


A MAP SHOWING A HYDROGRAPHIC SURVEY OF
A PORTION OF ISLE OF PALMS NORTH CANAL SYSTEM
LOCATED IN DUVAL COUNTY, FLORIDA



LEGEND/ABBREVIATIONS


- = CHANNEL CENTERLINE
——— = CHANNEL TOE
- MLW = MEAN LOW WATER
NO. = NUMBER
P.I. = POINT OF INTERSECTION
POB = POINT OF BEGINNING
STA. = STATION
NAVD 88 = NORTH AMERICAN VERTICAL DATUM 1988
ELEV. = ELEVATION
CGS = COASTAL GEODETIC SURVEY

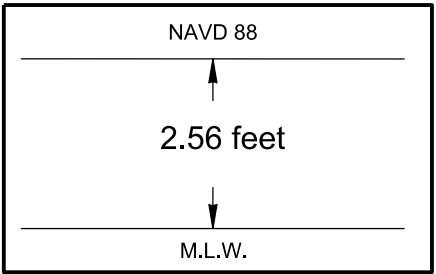

Relationship between NAVD 88
and Mean Low Water

BENCHMARKS	NAVD88 ELEV. (FT)	PLANE COORDINATES		DESCRIPTION
		X	Y	
Y 323	15.82	528,089.59	2,165,028.44	CGS BRASS DISK IN CONCRETE STAMPED Y 323 1970
PALM NORTH 1	4.60	521,064.20	2,163,201.96	SET 1/2" IRON PIPE W/ CAP LB# 6488

Richard J. Sawyer
Professional Surveyor and Mapper No. 6131
NOT VALID WITHOUT THE SIGNATURE AND THE ORIGINAL RAISED
SEAL OF A FLORIDA LICENSED SURVEYOR AND MAPPER


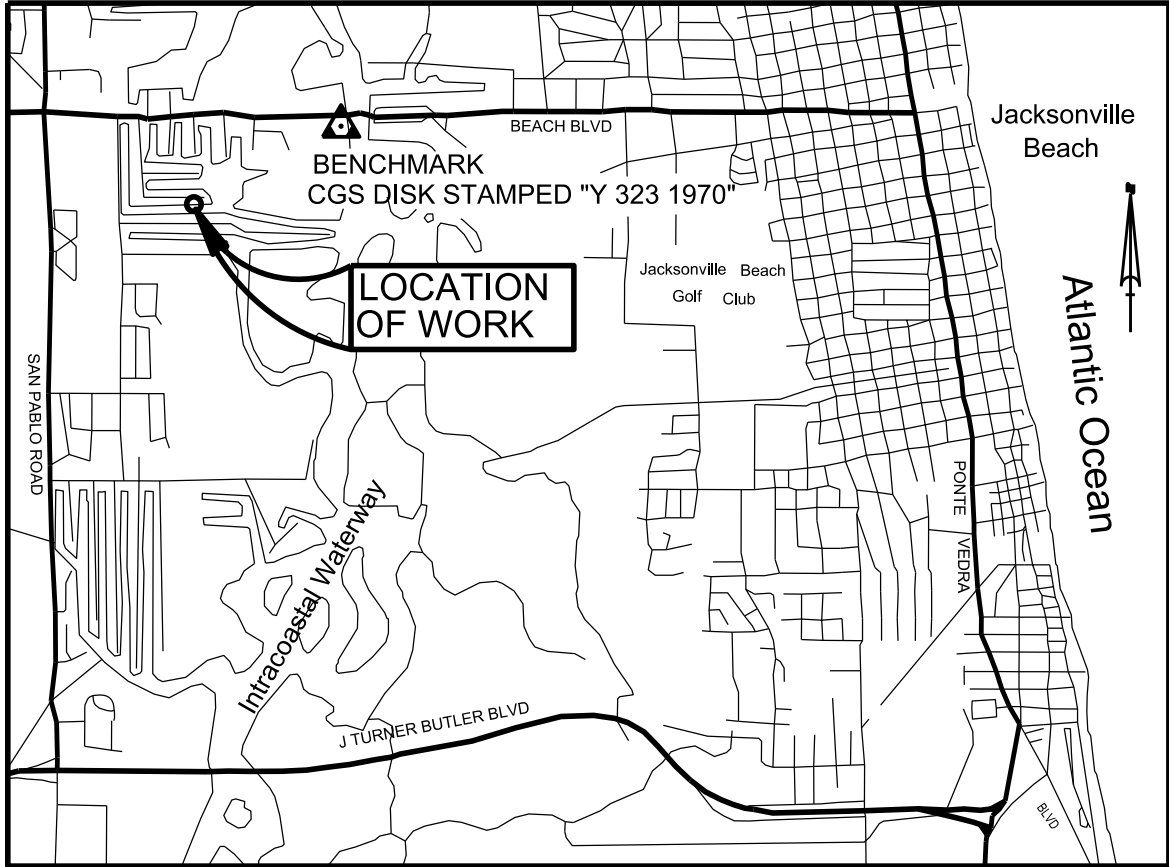


VICINITY MAP
NOT TO SCALE

SURVEY NOTES:

- HORIZONTAL DATUM: NORTH AMERICAN DATUM OF 1983/88, STATE PLANE COORDINATES, FLORIDA EAST ZONE.
 - VERTICAL DATUM: MEAN LOW WATER (MLW). SOUNDINGS ARE IN FEET AND TENTHS. MLW DATUM OBTAINED FROM LABINS POINT IDENTIFICATION NUMBER 3723.
 - UNITS: U.S SURVEY FEET.
 - CONTOUR INTERVAL: 1 FOOT.
 - THIS HYDROGRAPHIC SURVEY WAS PERFORMED UTILIZING DIFFERENTIAL GPS (DGPS) SURVEYING METHODS FOR HORIZONTAL POSITIONING.
 - SOUNDINGS WERE COLLECTED USING AN ODOM CV-100 SINGLE BEAM SONAR. DATA PROCESSING WAS COMPLETED USING HYPACK HYSWEEP SOFTWARE.
 - THE INFORMATION DEPICTED ON THIS MAP REPRESENTS THE RESULTS OF A SURVEY PERFORMED ON THE INDICATED DATES BELOW AND CAN ONLY BE CONSIDERED AS INDICATING THE GENERAL CONDITIONS AT THAT TIME.
- | VESSEL | DATE OF SURVEY |
|----------|-----------------|
| JON BOAT | AUGUST 10, 2021 |
- SURVEY QUALITY CONTROL STANDARDS AND FIELD EQUIPMENT CALIBRATIONS WERE FOLLOWED DURING THIS SURVEY IN ACCORDANCE WITH EM 1110-2-1003 FOR CLASS 1 HYDROGRAPHIC SURVEYS.
 - INTRACOASTAL CHANNEL LIMITS OBTAINED FROM A U.S. ARMY CORPS OF ENGINEERS MAP LABELED "INTRACOASTAL WATERWAY JACKSONVILLE TO MIAMI AND MIAMI TO KEY WEST, PROJECT CONDITION SURVEY 7, 10 & 12-FOOT PROJECT DEPTH" JOB NUMBER 04-021. NO ATTEMPT WAS MADE TO VERIFY INFORMATION. IT IS NOT TO BE USED FOR NAVIGATION.
 - BACKGROUND PHOTOGRAPHY WAS OBTAINED FROM WWW.LABINS.ORG, DATED 2017.
 - SURVEY BASELINES AND TEMPLATE REVISIONS PER CLIENT MARKUPS, JULY 22, 2021

SHEET INDEX

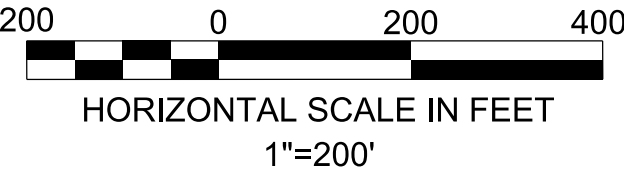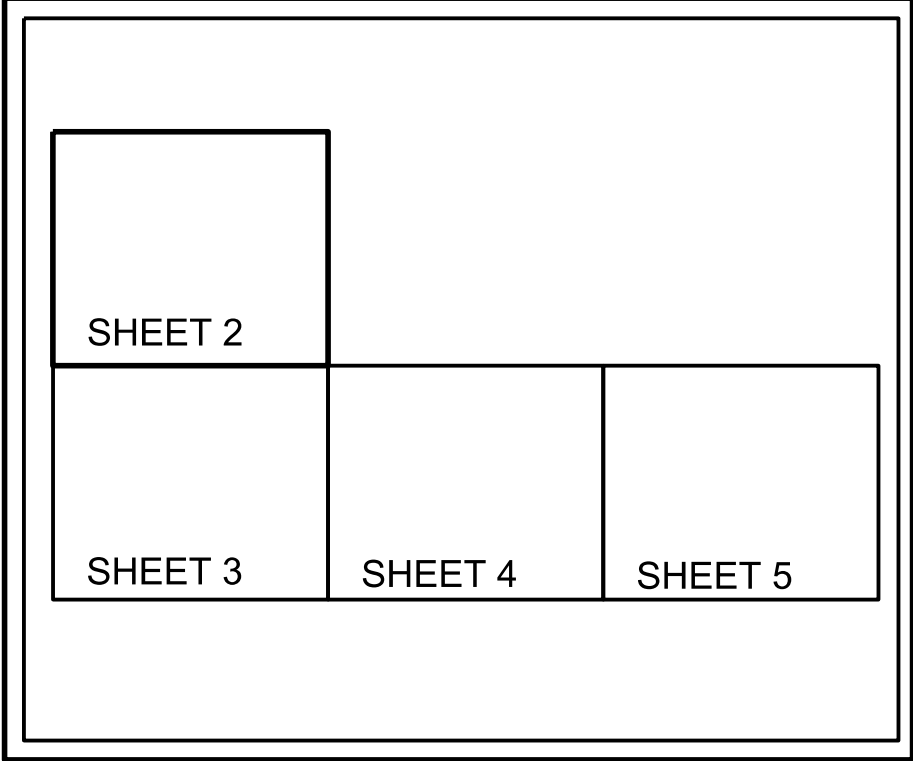

Project Title:


Isle of Palms North
Hydrographic After-Dredge #4 Survey

Prepared For:

Isle of Palms Special District
501 Riverside Avenue
Jacksonville, FL 32202

Arc Surveying & Mapping, Inc.

Professional Hydrographers • Surveyors • Mappers
5202 San Juan Avenue
Jacksonville, Florida 32210
904.394.8377

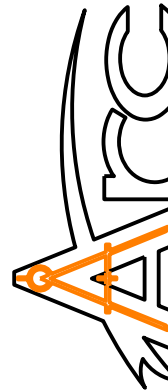

LB No. 6487

Drawn By: D. Trabits

Scale: see map

Plot Date: 08/16/21



File Name:

Fld Bk / Pg:NA


ARC Project No.:

2020-0077 AD4

SHEET: 1 OF: 20

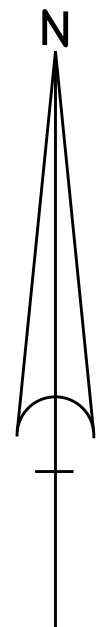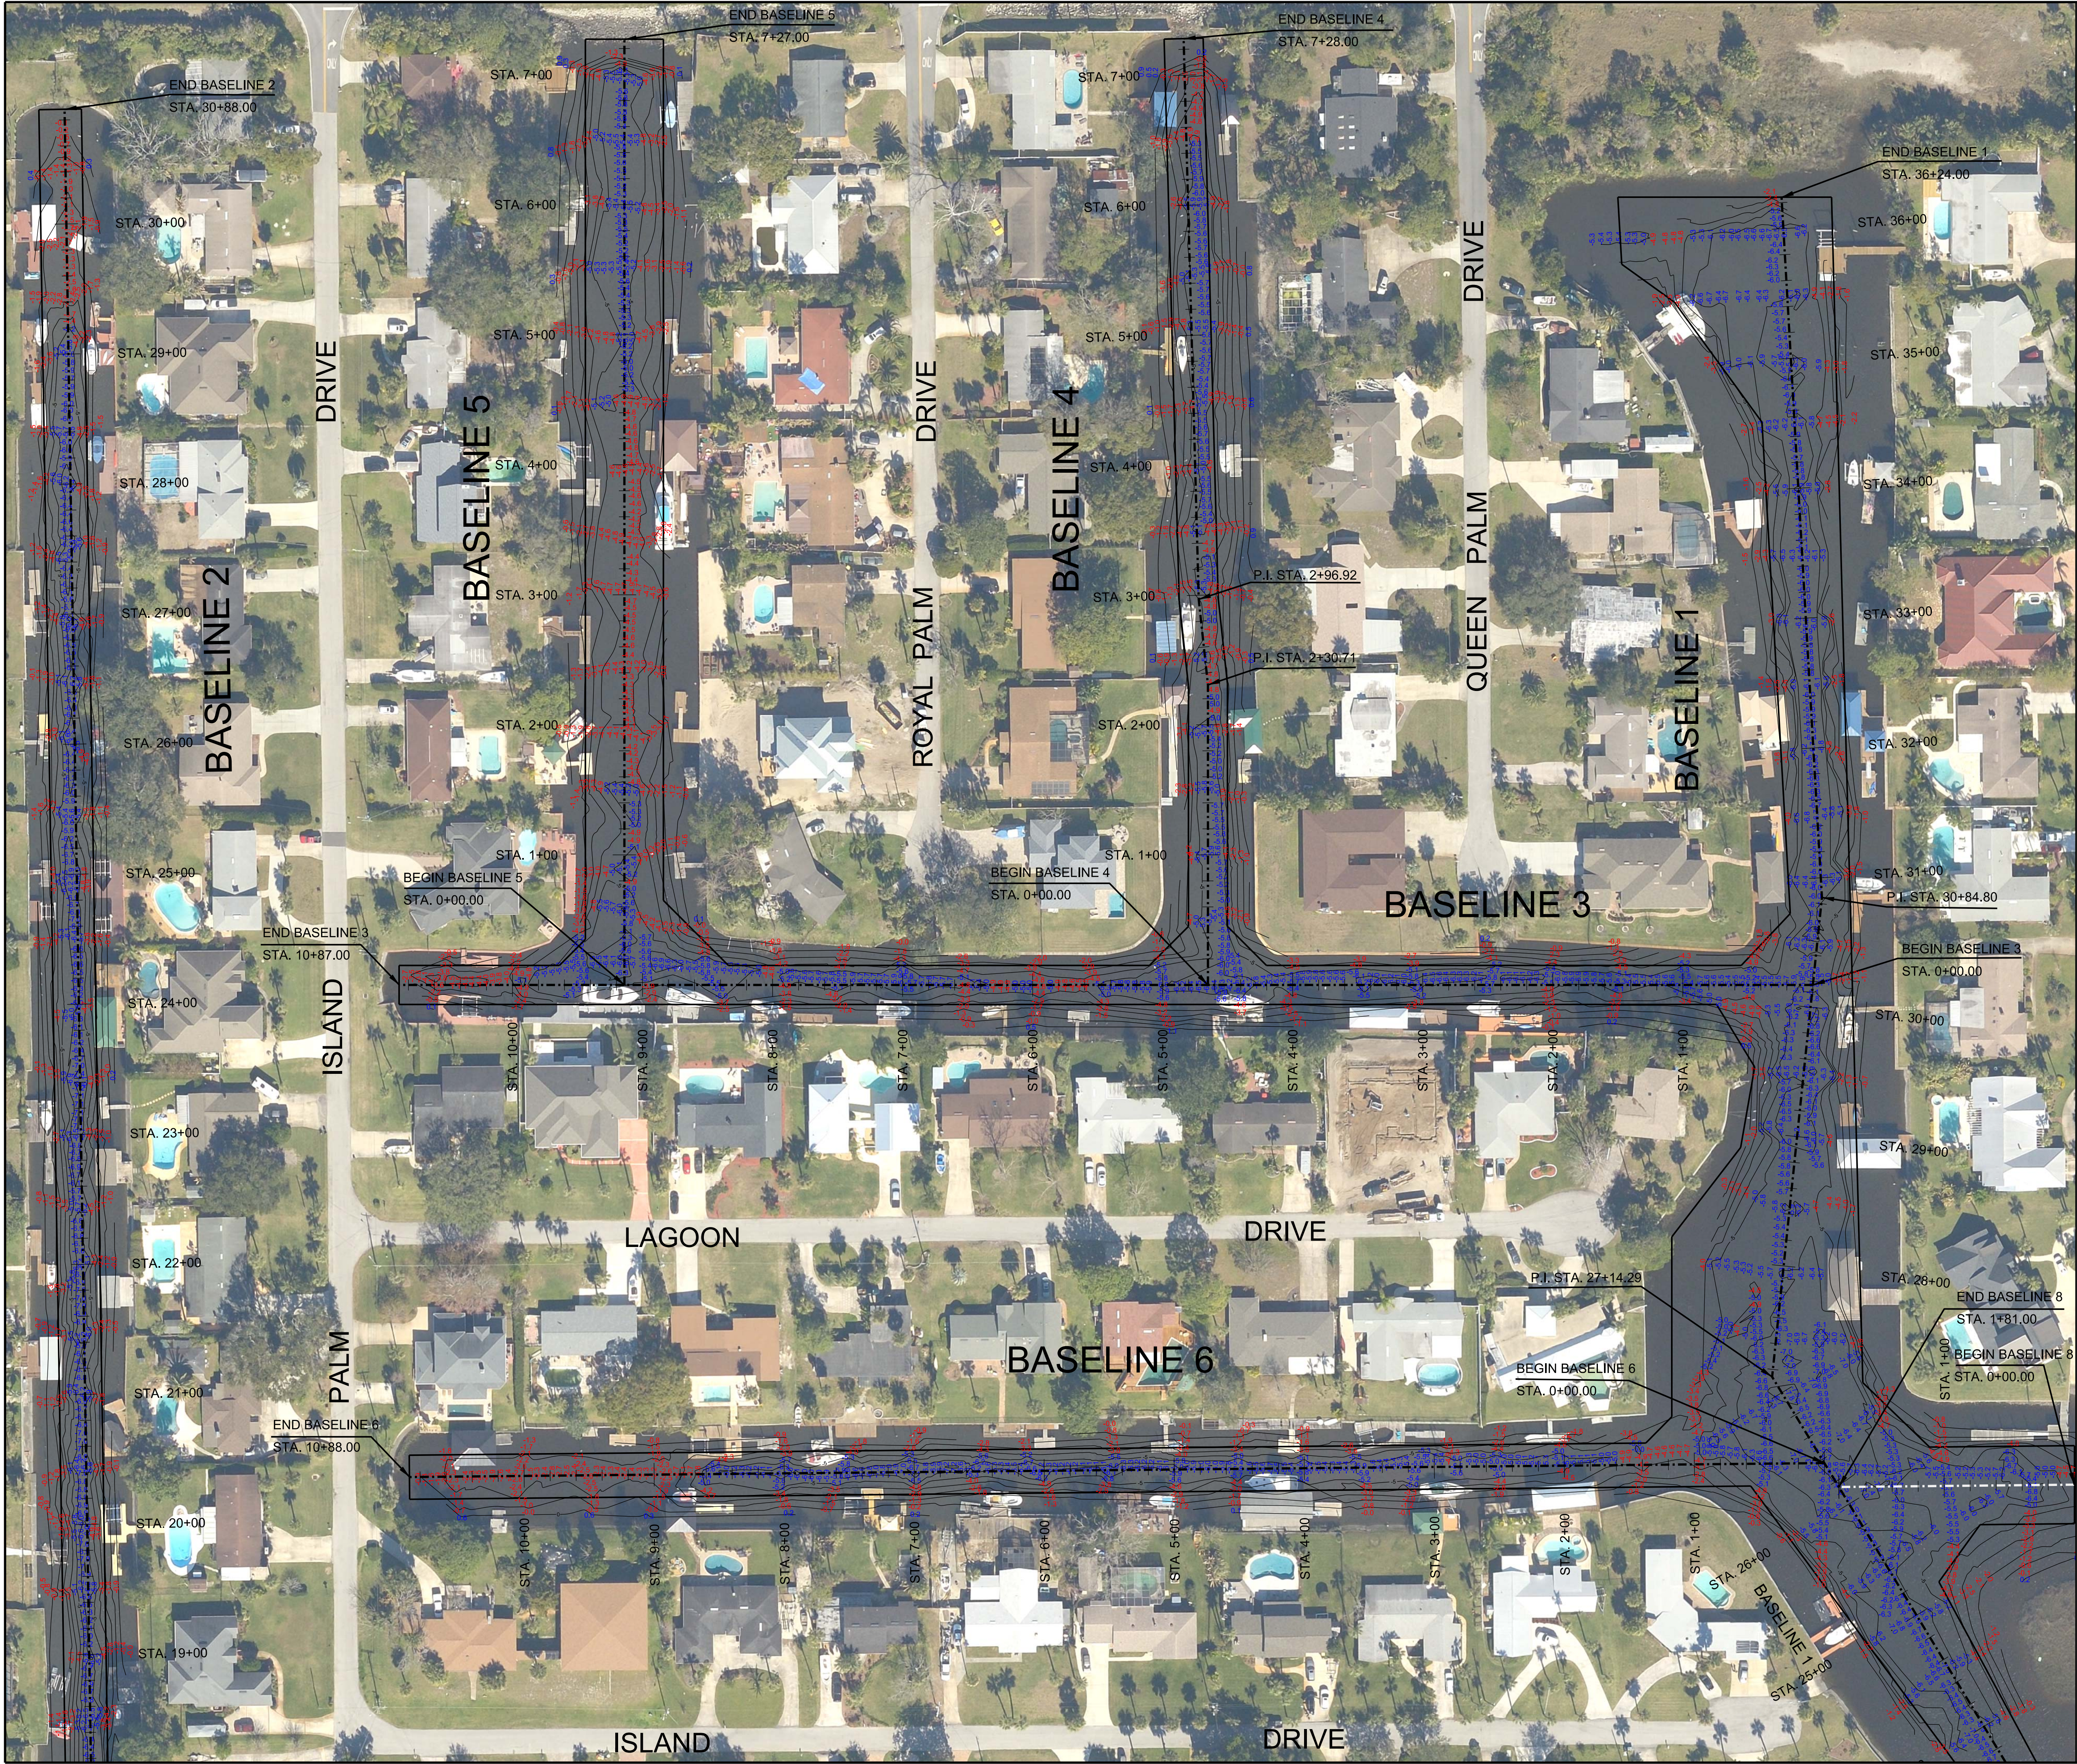


SHEET INDEX

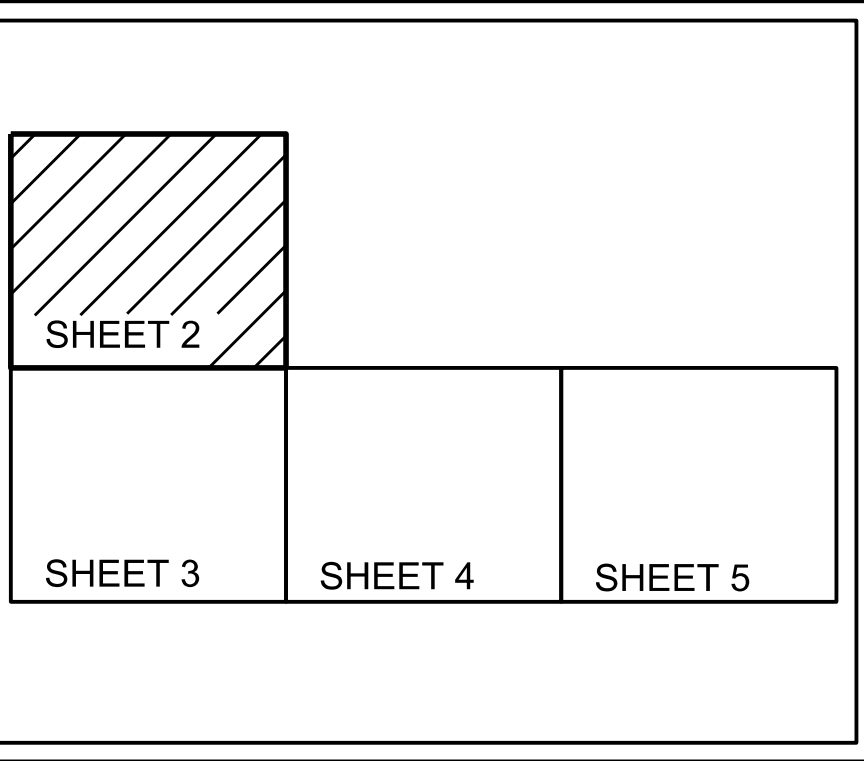

LEGEND/ABBREVIATIONS

- = CHANNEL CENTERLINE
- = CHANNEL TOE
- MLW = MEAN LOW WATER
- NO. = NUMBER
- P.I. = POINT OF INTERSECTION
- POB = POINT OF BEGINNING
- STA. = STATION
- NGVD = NATIONAL GEODETIC VERTICAL DATUM
- ELEV. = ELEVATION

NOTES:
1. REFER TO SURVEY NO. 2020-0077
2. SEE SHEET NO.1 FOR SURVEY NOTES.

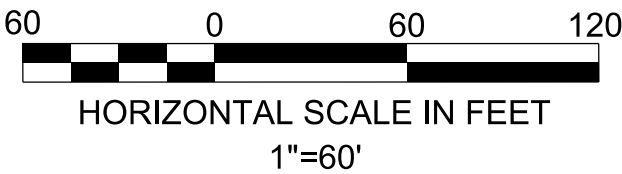


DATE	BY	REVISION


Project Title:
Isle of Palms North
Hydrographic After-Dredge #4 Survey

Prepared For:
Isle of Palms Special District
501 Riverside Avenue
Jacksonville, FL 32202


Arc Surveying & Mapping, Inc.
Professional Hydrographers • Surveyors • Mappers
5202 San Juan Avenue
Jacksonville, Florida 32210
904.394.8377

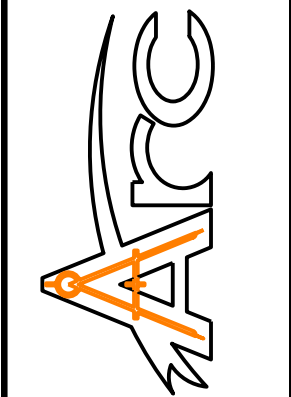

LB No. 6487
Drawn By: D. Trabis
Scale: see map
Plot Date: 08/16/21
File Name:
Fld Bk / Pg:NA
ARC Project No.: 2020-0077 AD4
SHEET: 2 OF: 20

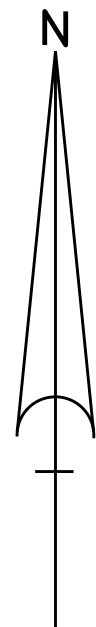


SHEET INDEX

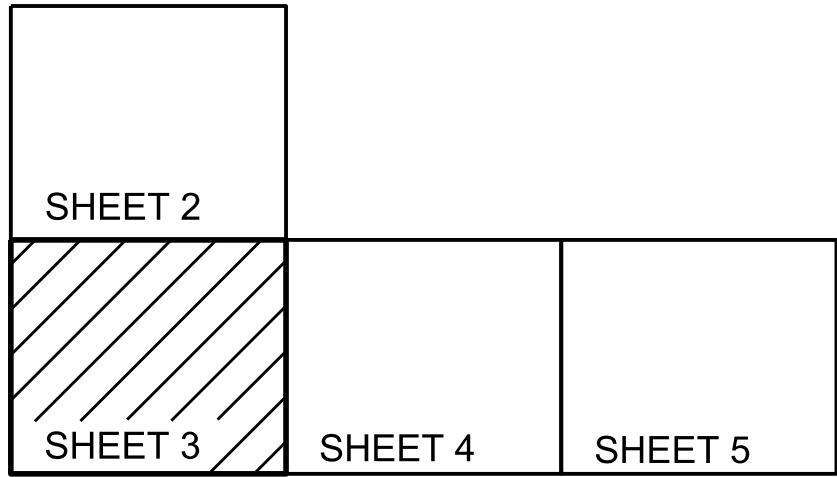

LEGEND/ABBREVIATIONS

- = CHANNEL CENTERLINE
- = CHANNEL TOE
- MLW = MEAN LOW WATER
- NO. = NUMBER
- P.I. = POINT OF INTERSECTION
- POB = POINT OF BEGINNING
- STA. = STATION
- NGVD = NATIONAL GEODETIC VERTICAL DATUM
- ELEV. = ELEVATION

- NOTES:
1. REFER TO SURVEY NO. 2020-0077
 2. SEE SHEET NO.1 FOR SURVEY NOTES.

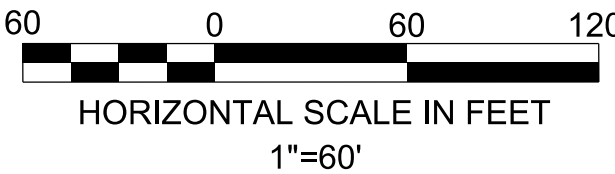


DATE	BY	REVISION



Project Title:
Isle of Palms North
Hydrographic After-Dredge #4 Survey

Prepared For:
Isle of Palms Special District
501 Riverside Avenue
Jacksonville, FL 32202


Arc Surveying & Mapping, Inc.
Professional Hydrographers • Surveyors • Mappers
5202 San Juan Avenue
Jacksonville, Florida 32210
904.394.8377

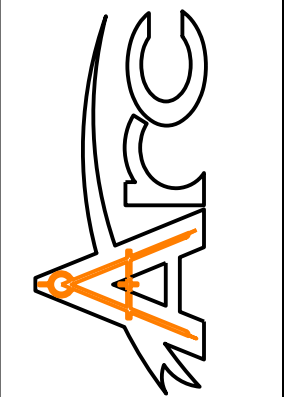

LB No. 6487
Drawn By: D. Trabits
Scale: see map
Plot Date: 08/16/21
File Name:
Fld Bk / Pg:NA
ARC Project No.: 2020-0077 AD4
SHEET: 3 OF: 20

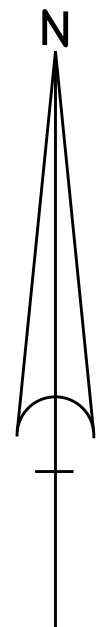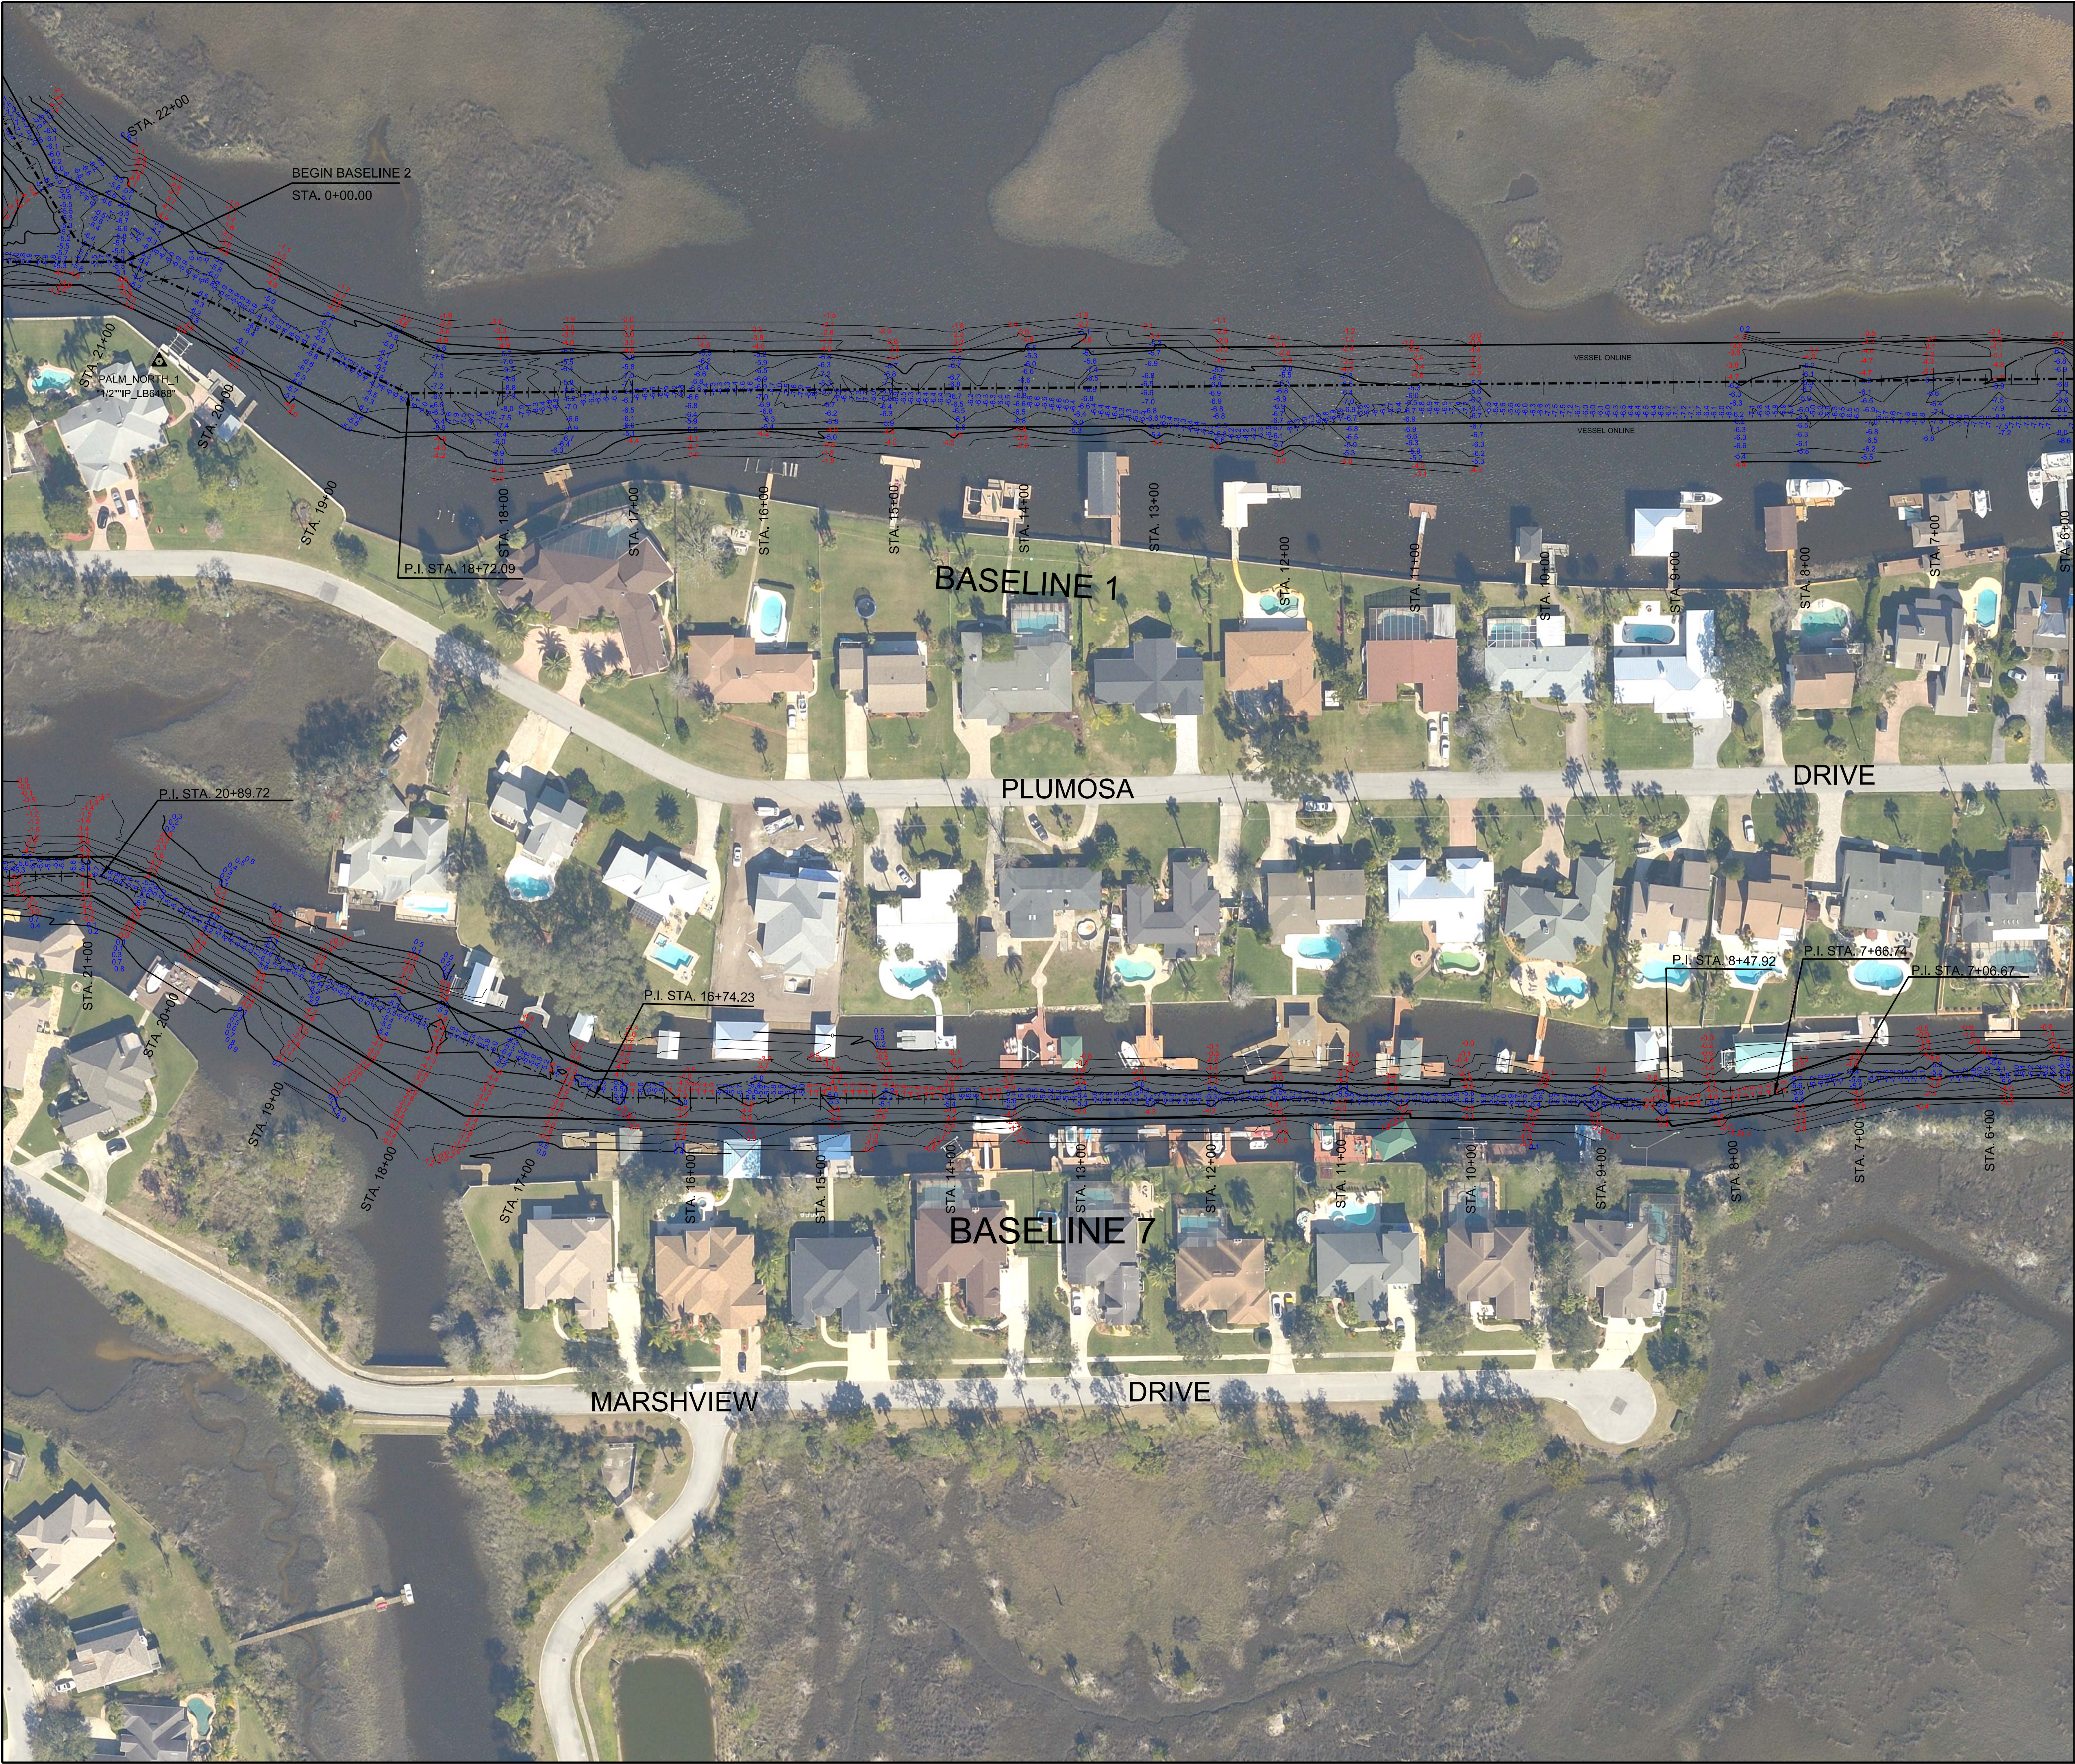


SHEET INDEX

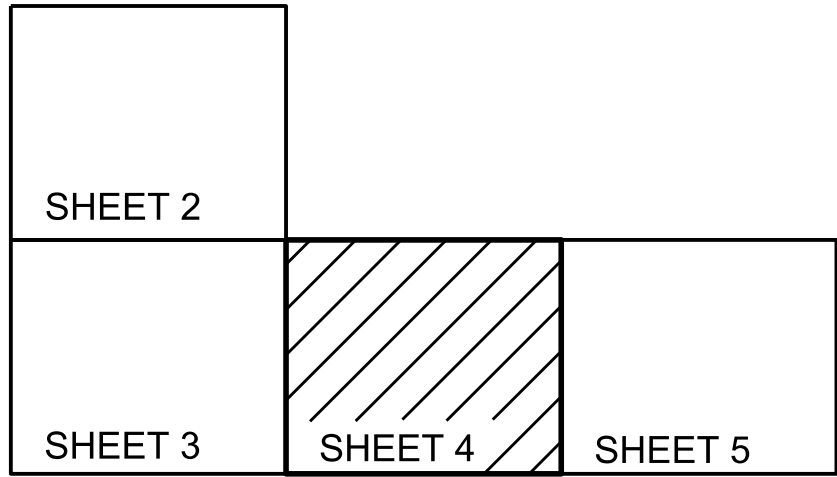

LEGEND/ABBREVIATIONS

- = CHANNEL CENTERLINE
- = CHANNEL TOE
- MLW = MEAN LOW WATER
- NO. = NUMBER
- P.I. = POINT OF INTERSECTION
- POB = POINT OF BEGINNING
- STA. = STATION
- NGVD = NATIONAL GEODETIC VERTICAL DATUM
- ELEV. = ELEVATION

- NOTES:
1. REFER TO SURVEY NO. 2020-0077
 2. SEE SHEET NO.1 FOR SURVEY NOTES.

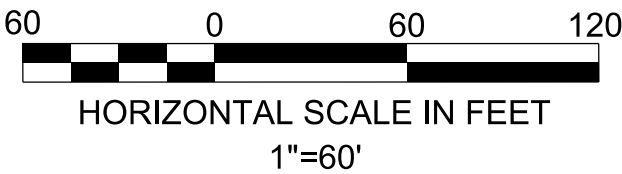


DATE	BY	REVISION


Project Title:
Isle of Palms North
Hydrographic After-Dredge #4 Survey

Prepared For:
Isle of Palms Special District
501 Riverside Avenue
Jacksonville, FL 32202


Arc Surveying & Mapping, Inc.
Professional Hydrographers • Surveyors • Mappers
5202 San Juan Avenue
Jacksonville, Florida 32210
904.394.8377

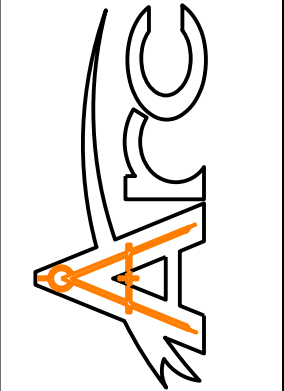

LB No. 6487
Drawn By: D. Trabits
Scale: see map
Plot Date: 08/16/21
File Name:
Fld Bk / Pg:NA
ARC Project No.: 2020-0077 AD4
SHEET: 4 OF: 20

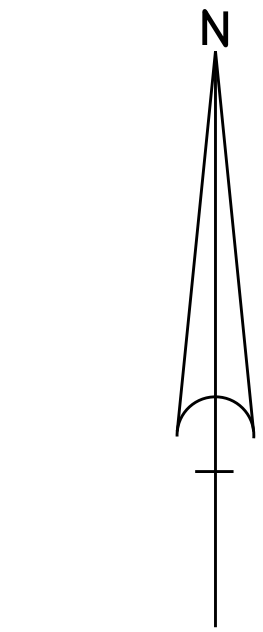


SHEET INDEX

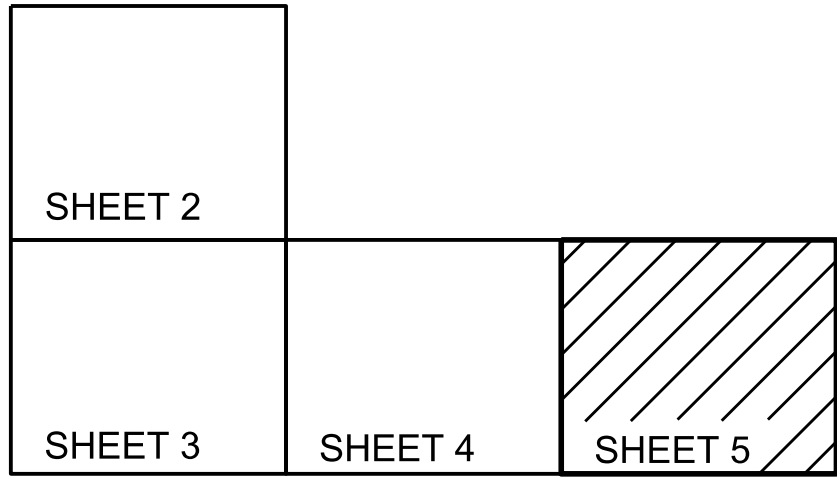

LEGEND/ABBREVIATIONS

- = CHANNEL CENTERLINE
- = CHANNEL TOE
- MLW = MEAN LOW WATER
- NO. = NUMBER
- P.I. = POINT OF INTERSECTION
- POB = POINT OF BEGINNING
- STA. = STATION
- NGVD = NATIONAL GEODETIC VERTICAL DATUM
- ELEV. = ELEVATION

- NOTES:
- REFER TO SURVEY NO. 2020-0077
 - SEE SHEET NO.1 FOR SURVEY NOTES.

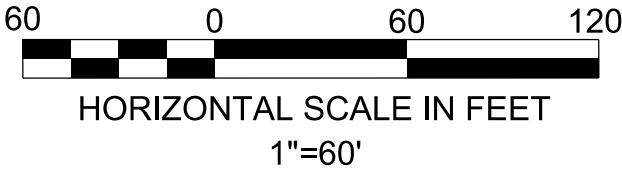


DATE	BY	REVISION

Project Title:
Isle of Palms North
Hydrographic After-Dredge #4 Survey



Prepared For:
Isle of Palms Special District
501 Riverside Avenue
Jacksonville, FL 32202

Arc Surveying & Mapping, Inc.
Professional Hydrographers • Surveyors • Mappers
5202 San Juan Avenue
Jacksonville, Florida 32210
904.394.8377

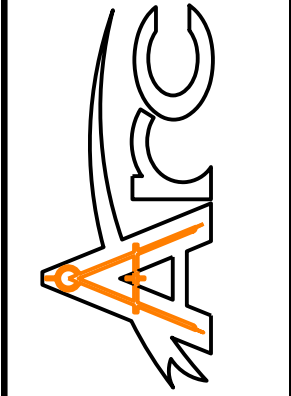

LB No. 6487
Drawn By: D. Trabits
Scale: see map
Plot Date: 08/16/21
File Name:
Fld Bk / Pg:NA
ARC Project No.: 2020-0077 AD4
SHEET: 5 OF: 20

ISLE OF PALMS NORTH, SURVEY BASELINE 1

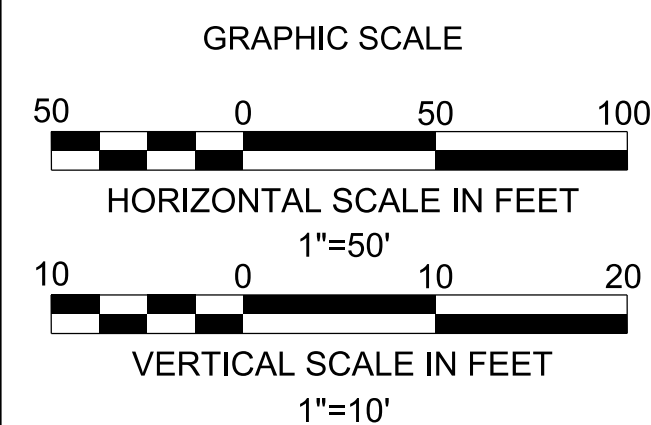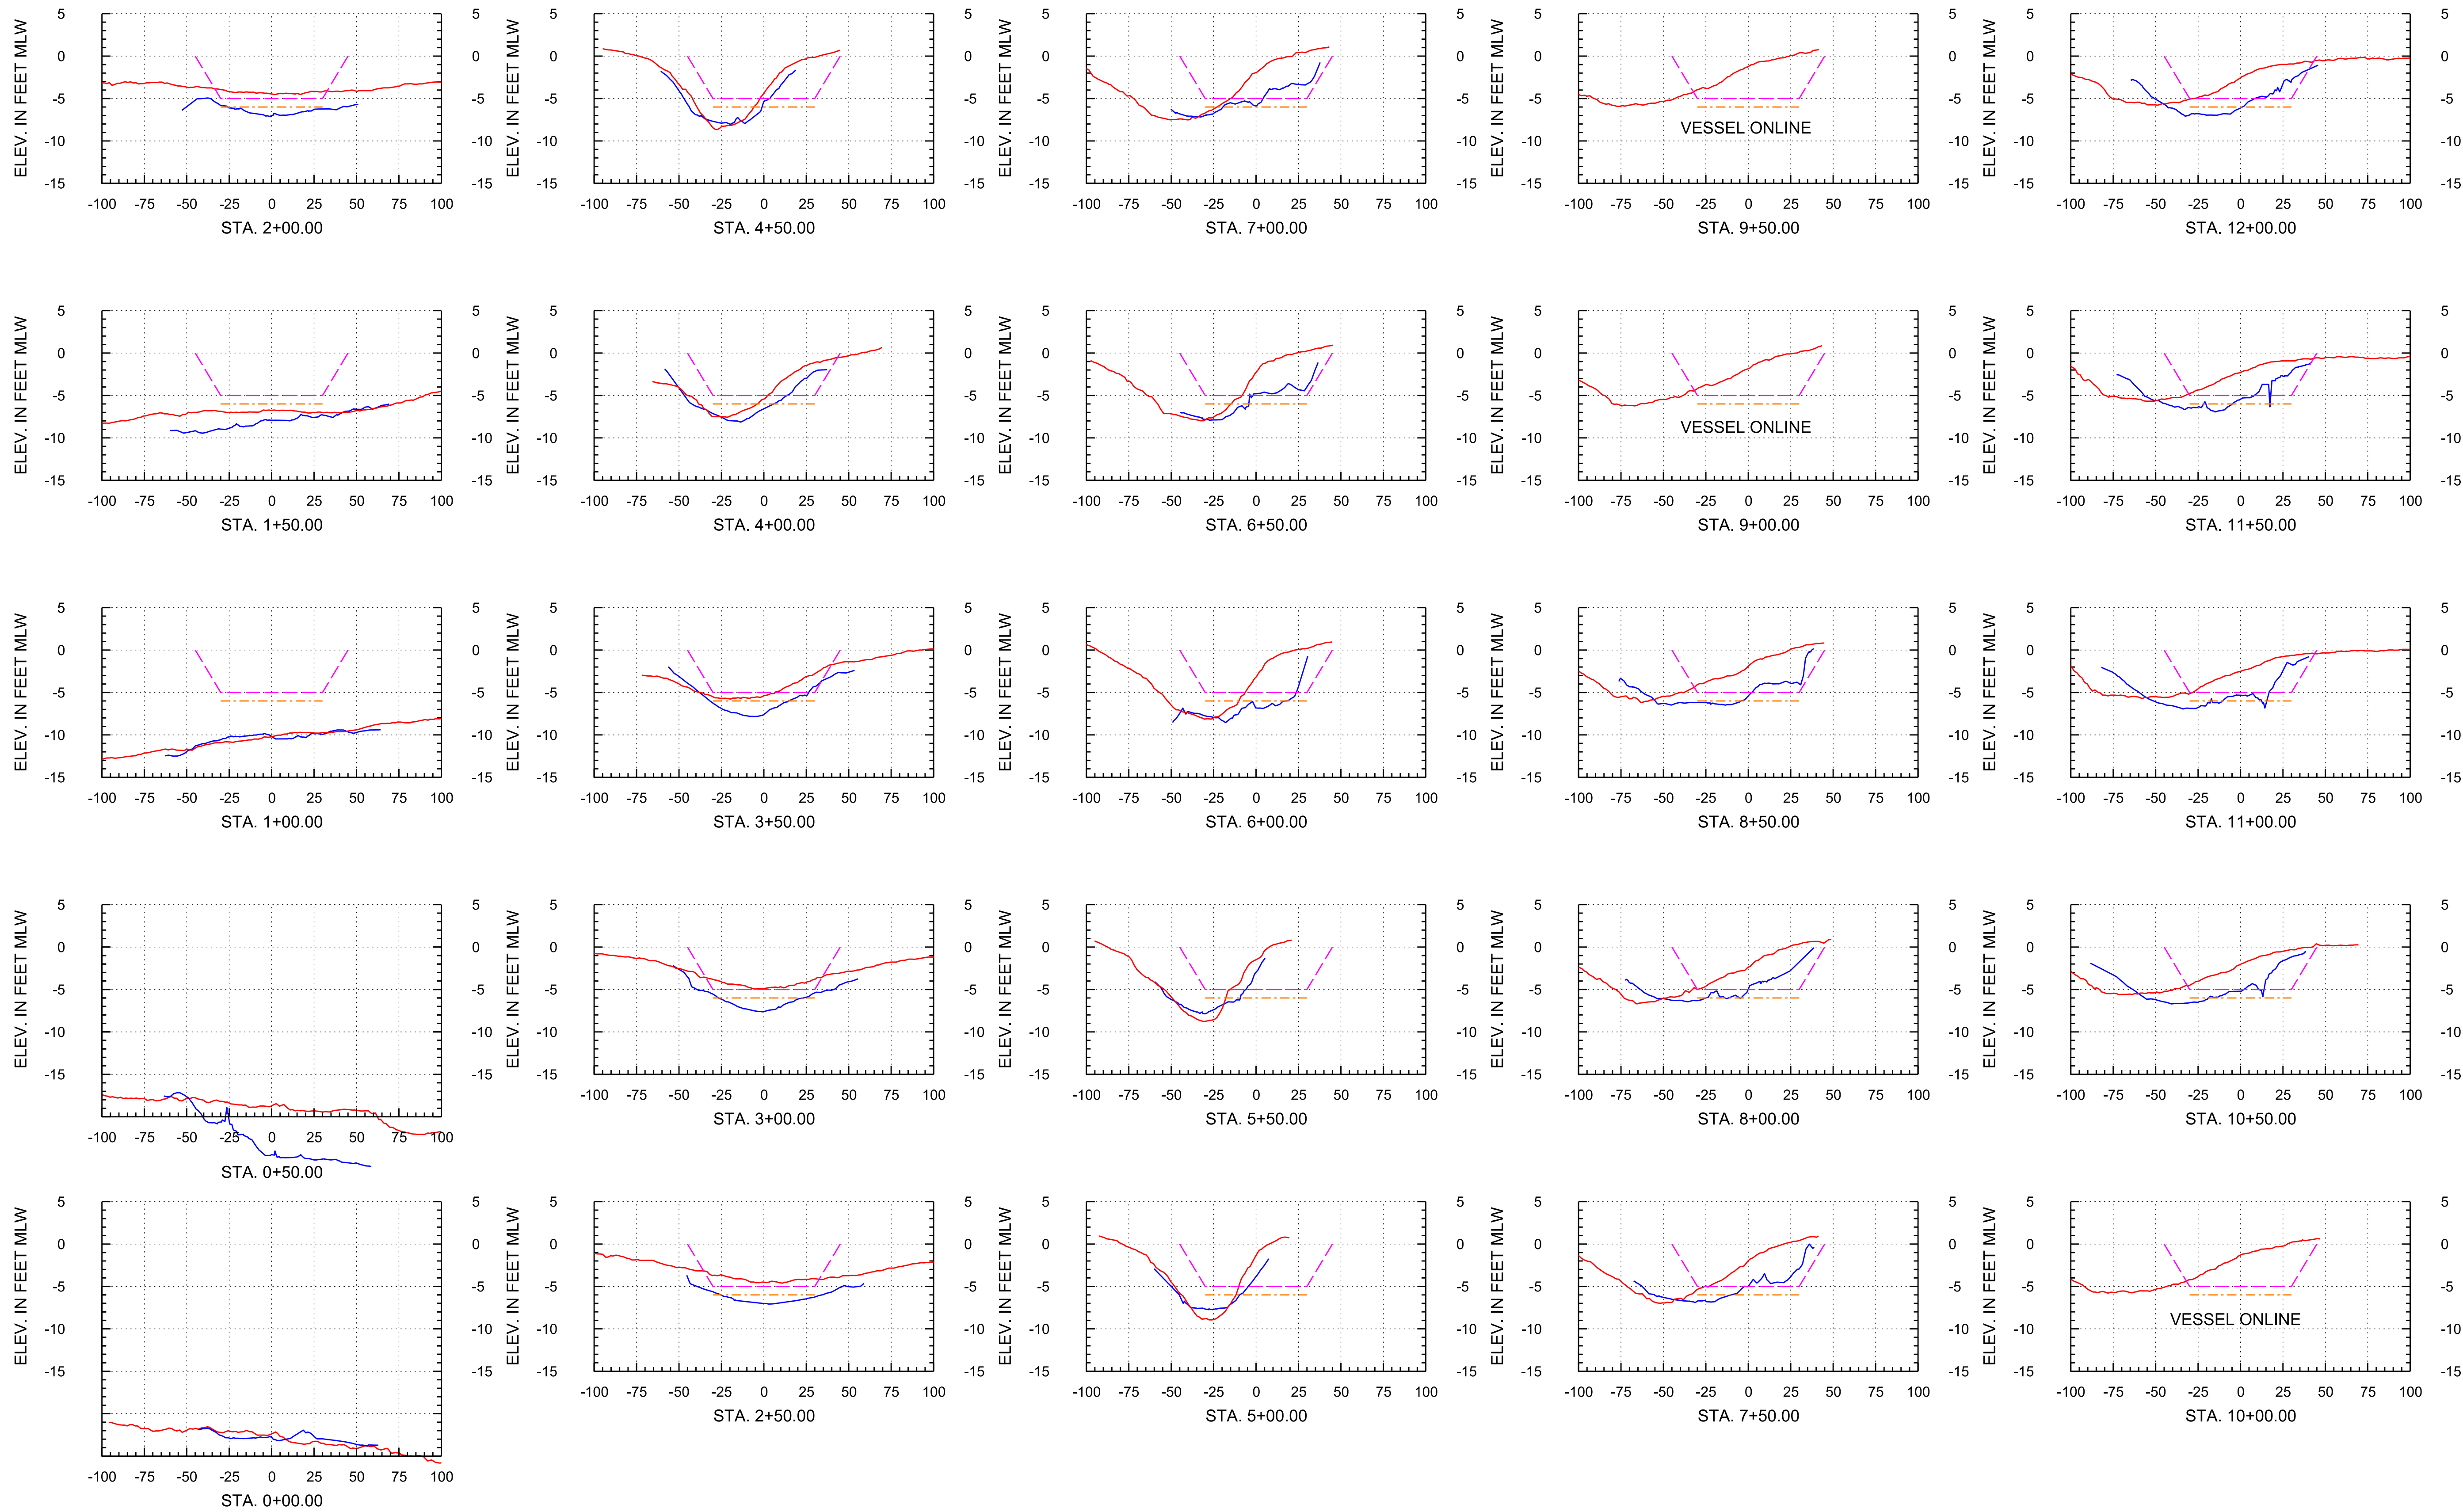

Arc Surveying & Mapping, Inc.
Professional Hydrographers • Surveyors • Mappers
5202 San Juan Avenue
Jacksonville, Florida 32210
904.384.8377

Prepared For:
Isle of Palms Special District
501 Riverside Avenue
Jacksonville, FL 32202

Project Title:
Isle of Palms North
Hydrographic After-Dredge #4 Survey

— = ARC SURVEY HYDROGRAPHIC SURVEY AUGUST 10, 2021
— = ARC SURVEY HYDROGRAPHIC SURVEY JUNE 23-JULY 6, 2020



MLW = MEAN LOW WATER
STA. = STATION

— = TEMPLATE AT -5' MLW (REVISED PER CLIENT)
— = TEMPLATE AT -6' MLW (REVISED PER CLIENT)

DATE	BY	REVISION

LB No. 6487
Drawn By: D. Trabis
Scale: see map
Plot Date: 08/16/21
File Name:
Fld Bk / Pg:
ARC Project No.:
2020-0077 AD4
SHEET: 7 OF: 20

ISLE OF PALMS NORTH, SURVEY BASELINE 1

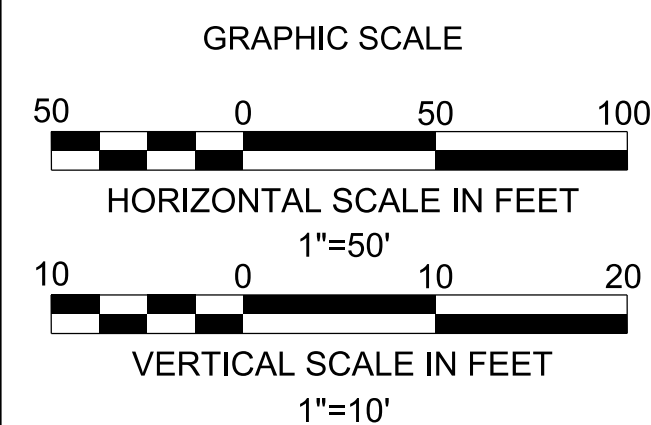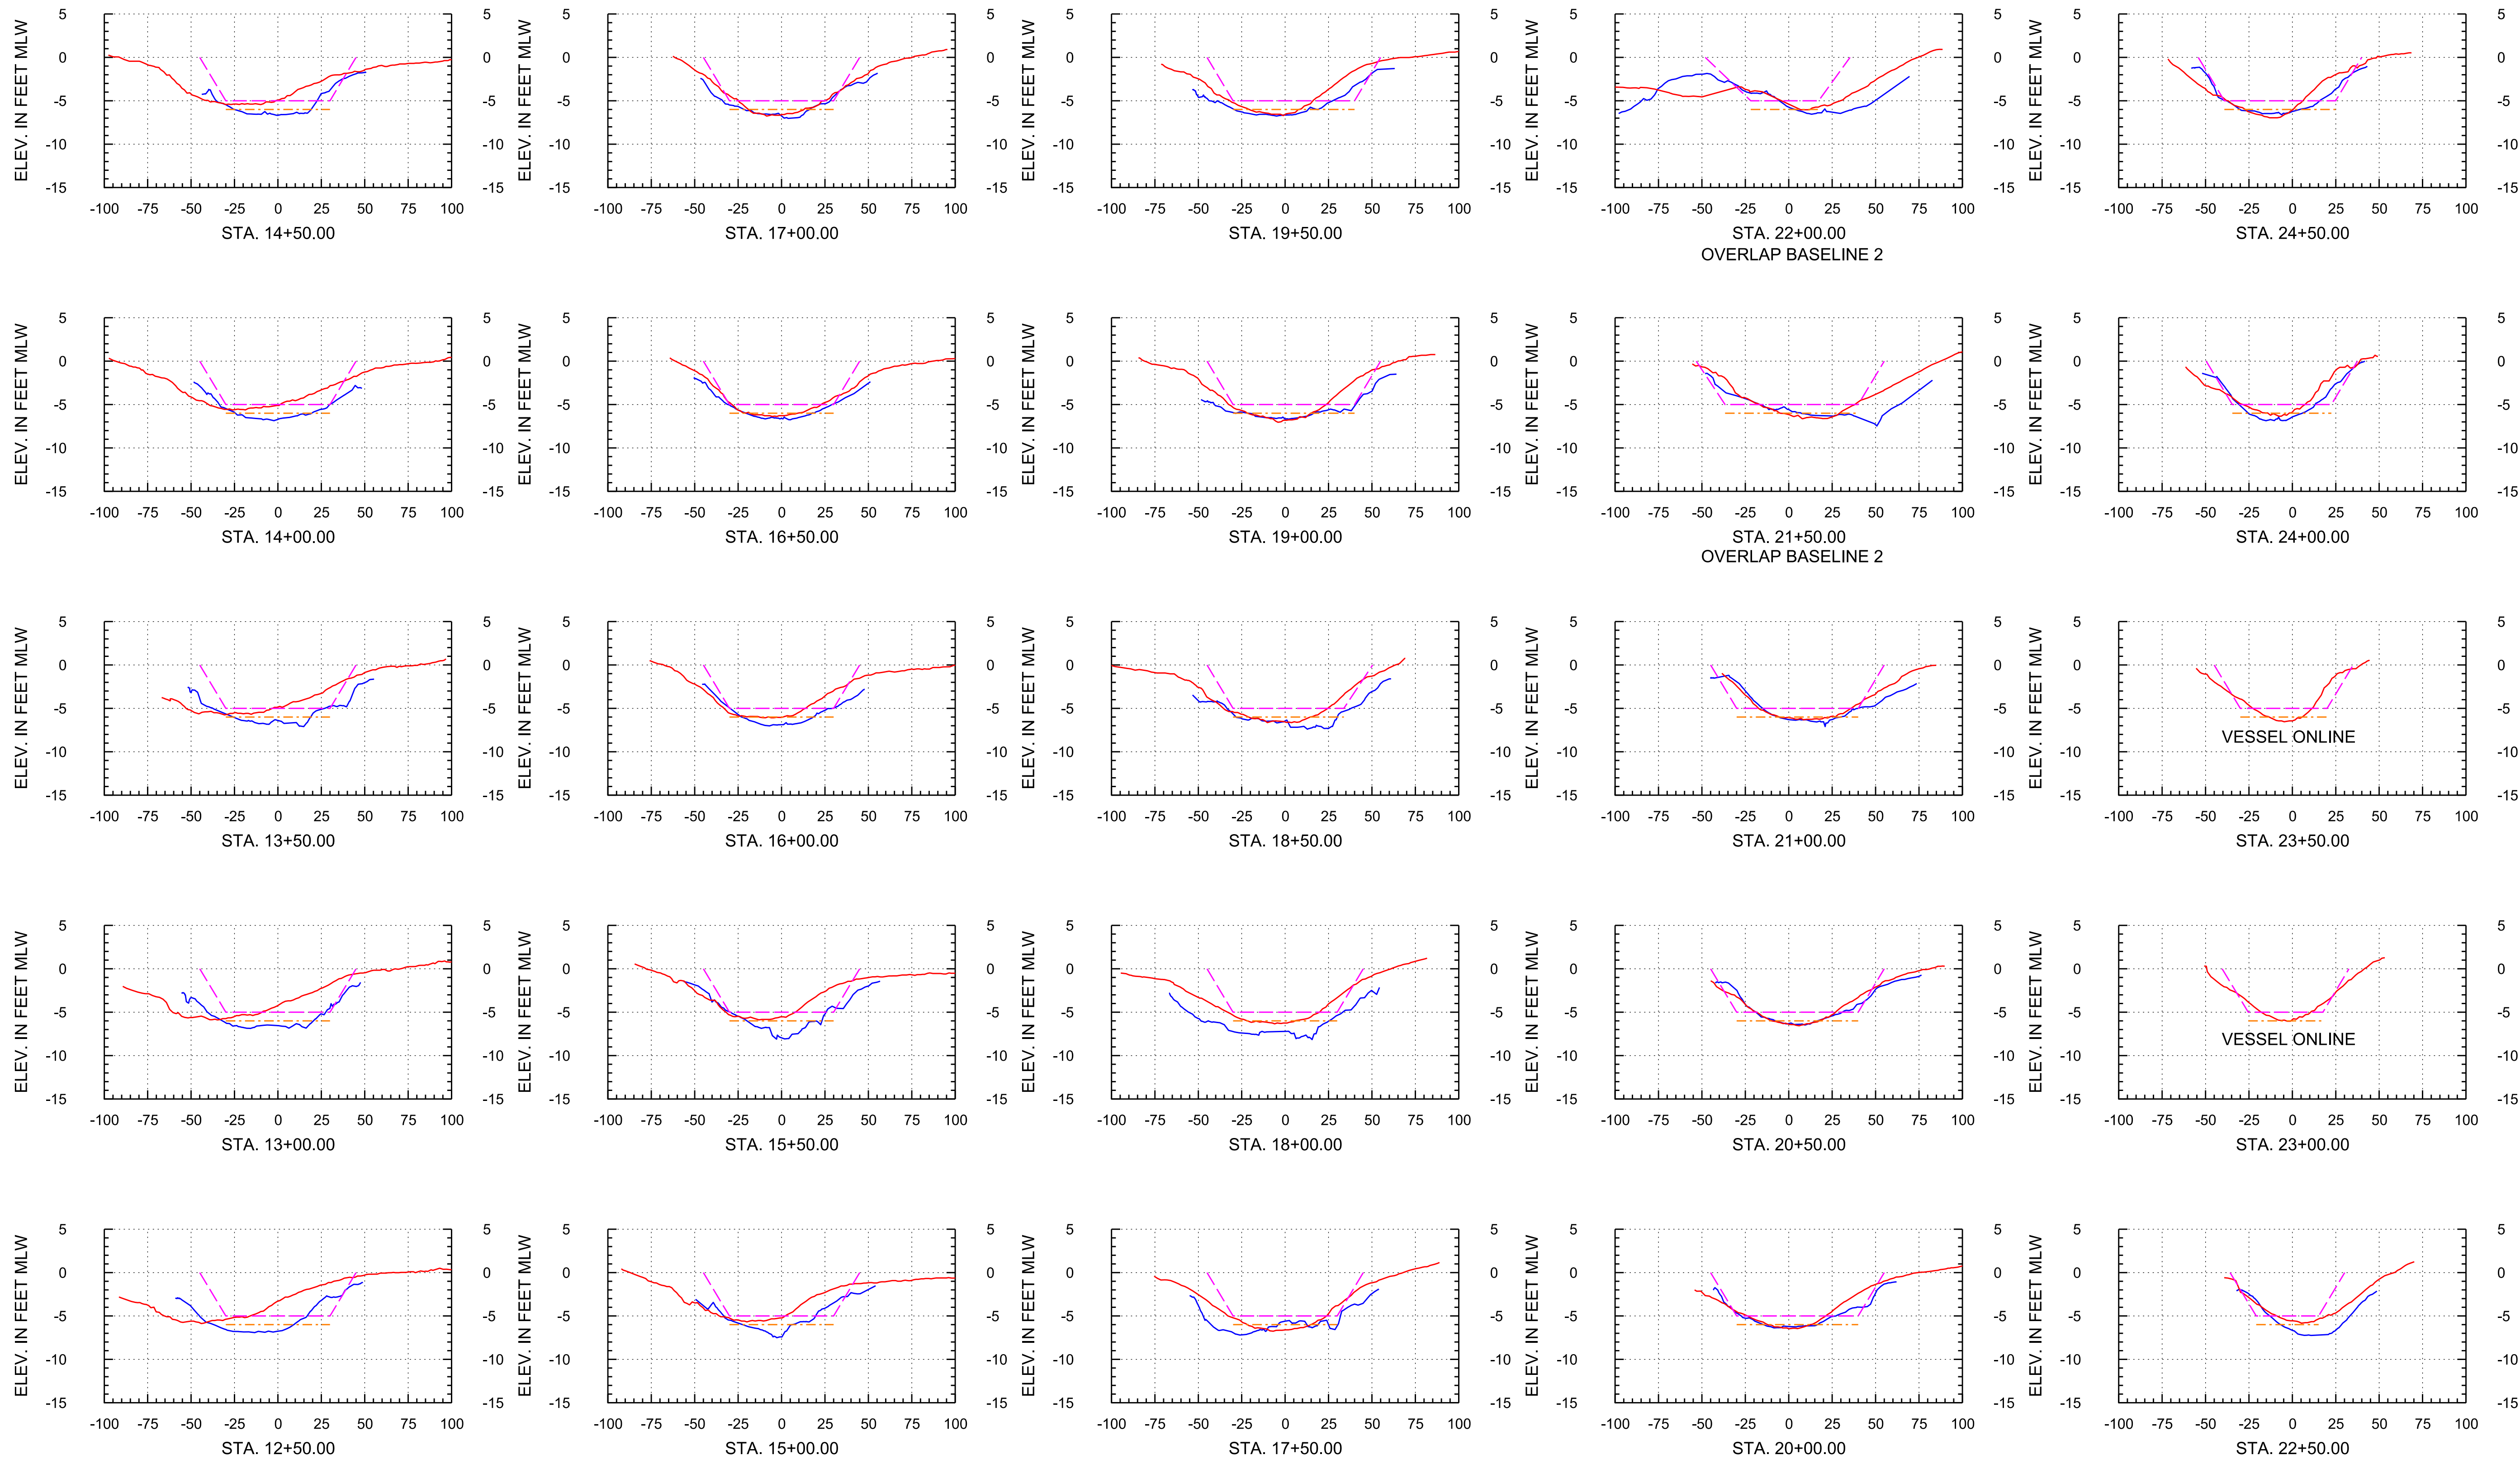

Arc Surveying & Mapping, Inc.
Professional Hydrographers • Surveyors • Mappers
5202 San Juan Avenue
Jacksonville, Florida 32210
904.384.8377

Prepared For:
Isle of Palms Special District
501 Riverside Avenue
Jacksonville, FL 32202

Project Title:
Isle of Palms North
Hydrographic After-Dredge #4 Survey



— = ARC SURVEY HYDROGRAPHIC SURVEY AUGUST 10, 2021
— = ARC SURVEY HYDROGRAPHIC SURVEY JUNE 23-JULY 6, 2020

MLW = MEAN LOW WATER — = TEMPLATE AT -5' MLW (REVISED PER CLIENT)
STA. = STATION — = TEMPLATE AT -6' MLW (REVISED PER CLIENT)

DATE	BY	REVISION

LB No. 6487
Drawn By: D. Trabis
Scale: see map
Plot Date: 08/16/21
File Name:
Fld Bk / Pg:
ARC Project No.:
2020-0077 AD4
SHEET: 8 OF 20

ISLE OF PALMS NORTH, SURVEY BASELINE 1

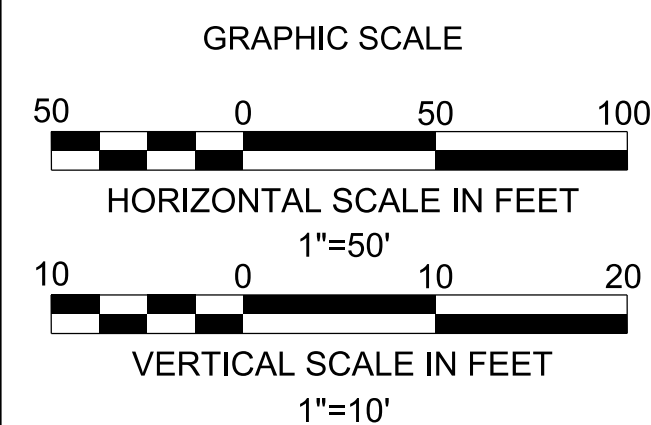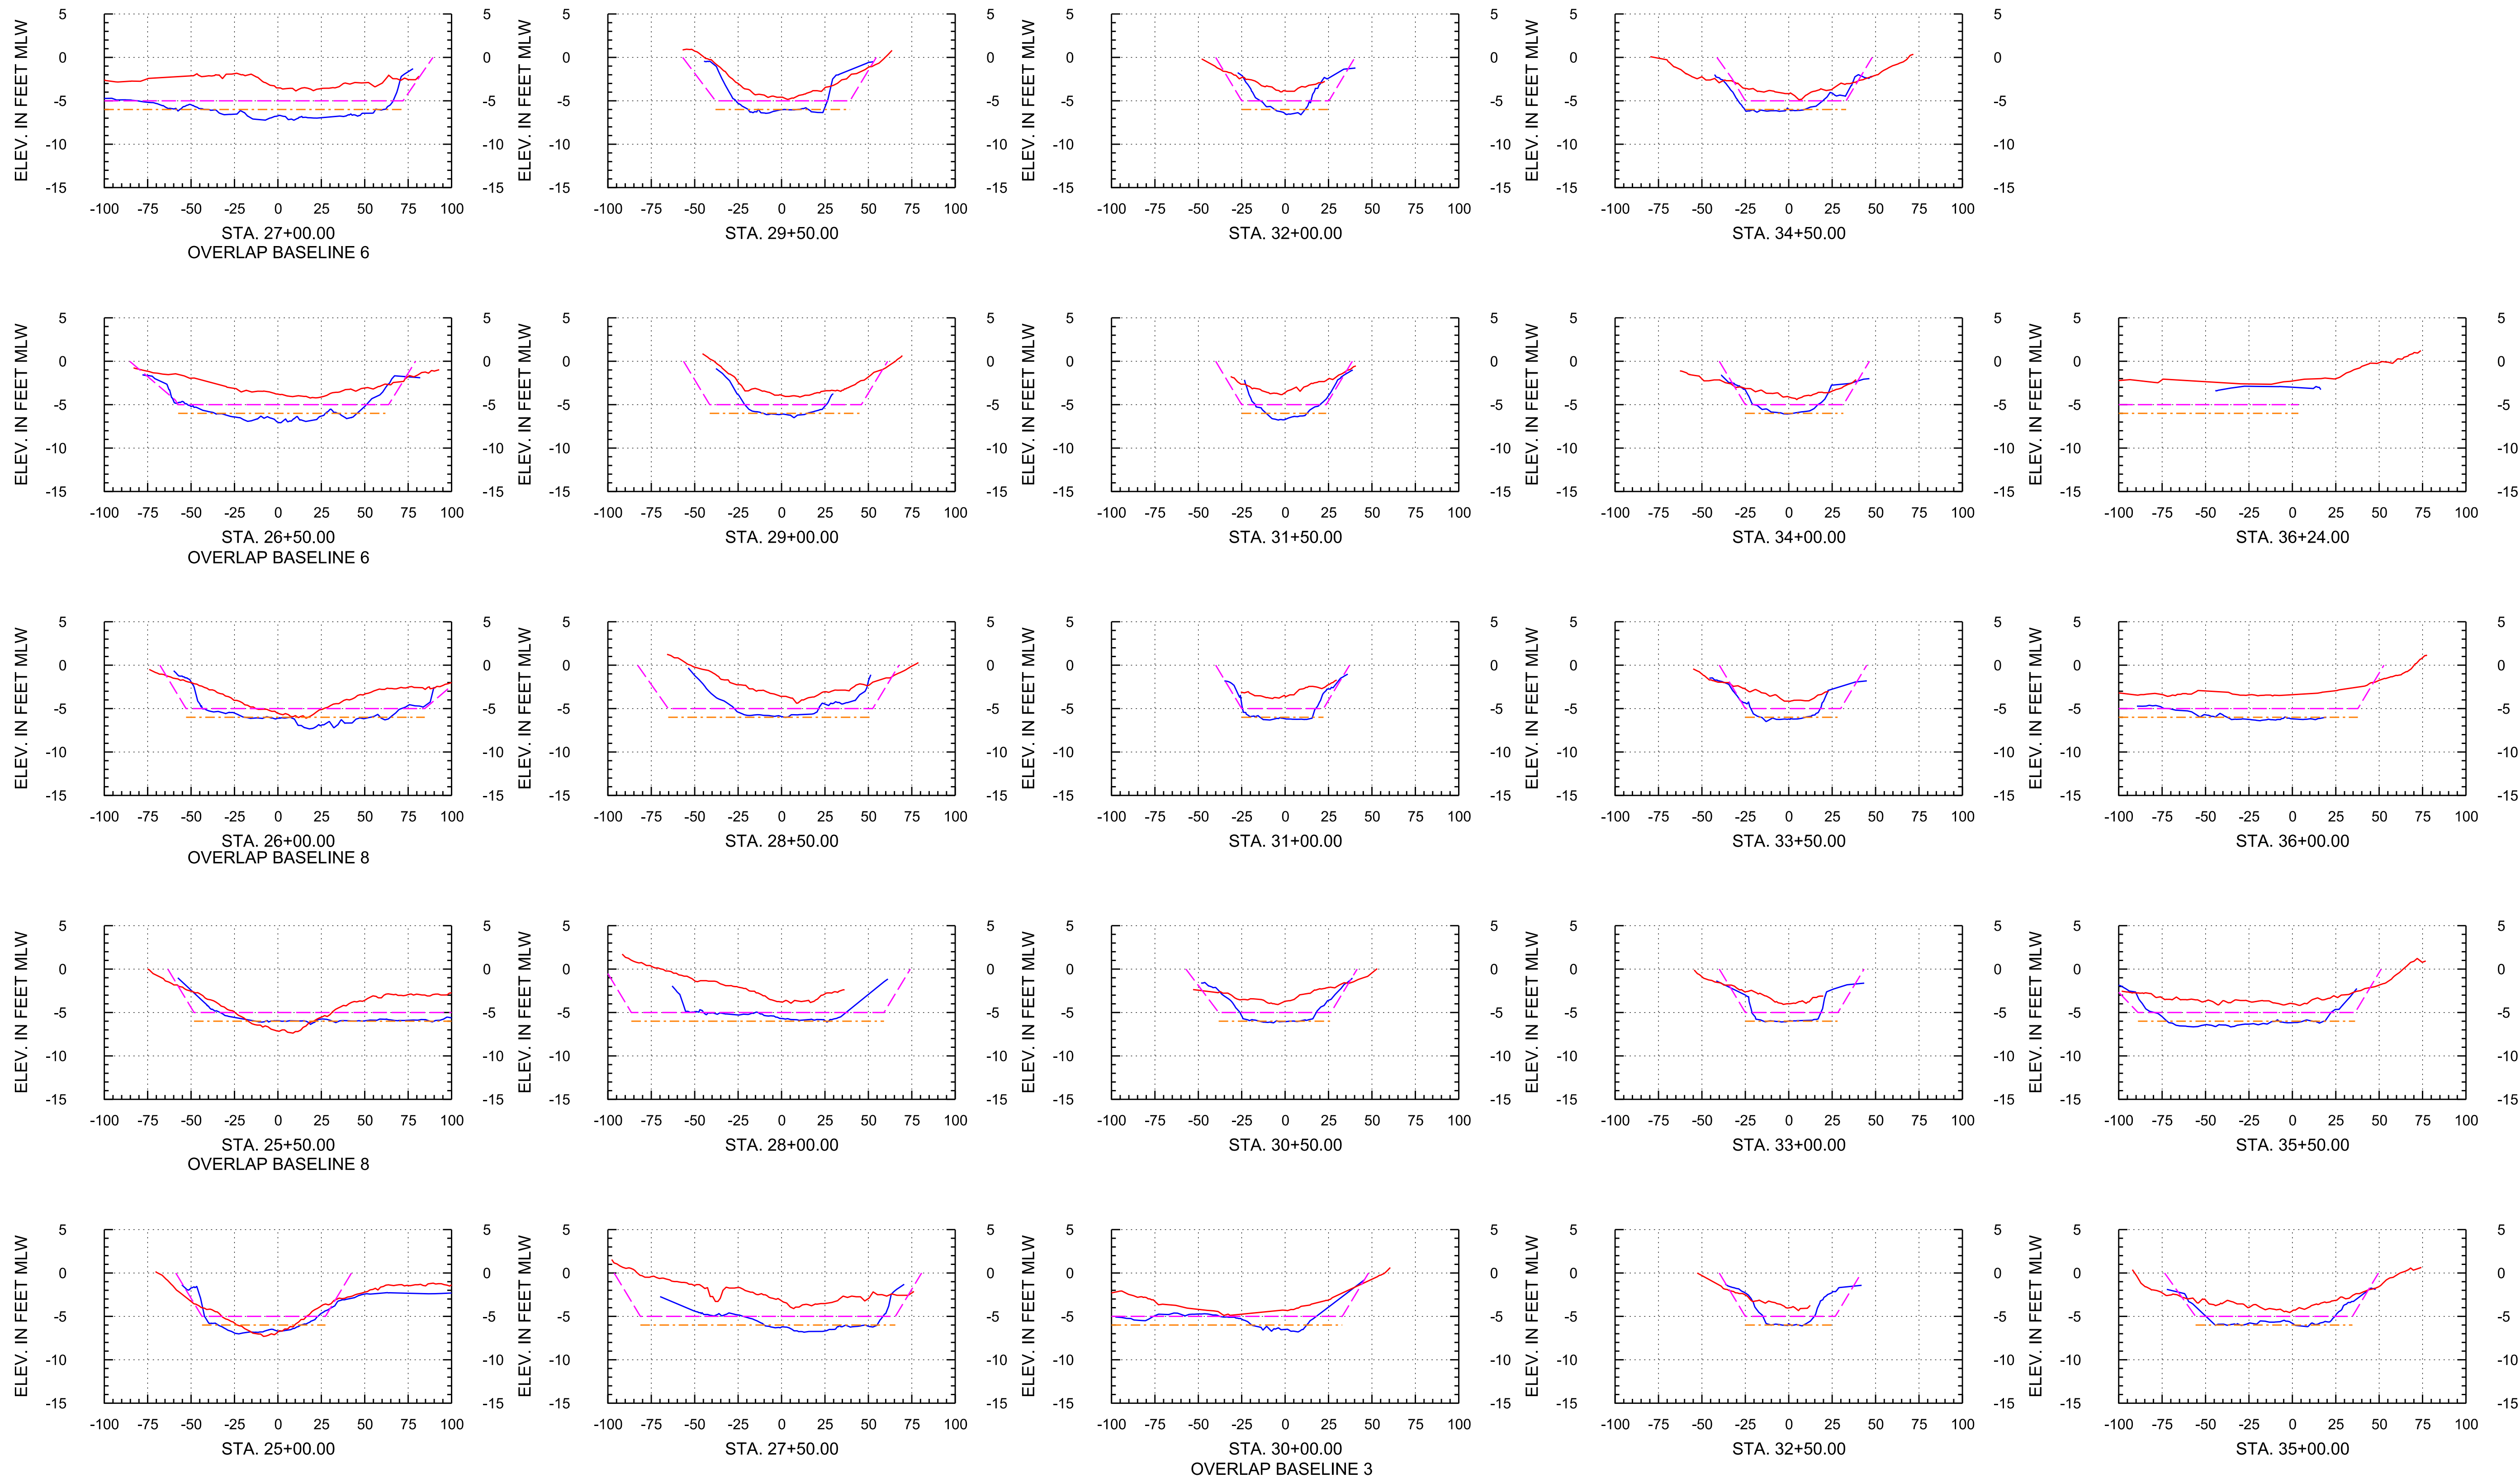

Arc Surveying & Mapping, Inc.
Professional Hydrographers • Surveyors • Mappers
5202 San Juan Avenue
Jacksonville, Florida 32210
904.384.8377

Prepared For:
Isle of Palms Special District
501 Riverside Avenue
Jacksonville, FL 32202

Project Title:
Isle of Palms North
Hydrographic After-Dredge #4 Survey

— = ARC SURVEY HYDROGRAPHIC SURVEY AUGUST 10, 2021
— = ARC SURVEY HYDROGRAPHIC SURVEY JUNE 23-JULY 6, 2020




MLW = MEAN LOW WATER
STA. = STATION

— = TEMPLATE AT -5' MLW (REVISED PER CLIENT)
— = TEMPLATE AT -6' MLW (REVISED PER CLIENT)

DATE	BY	REVISION

LB No. 6487
Drawn By: D. Trabis
Scale: see map
Plot Date: 08/16/21
File Name:
Fld Bk / Pg:
ARC Project No.:
2020-0077 AD4
SHEET: 9 OF: 20

ISLE OF PALMS NORTH, SURVEY BASELINE 2

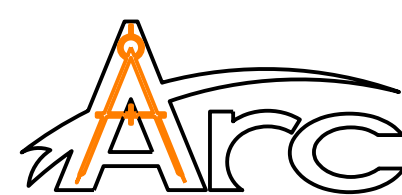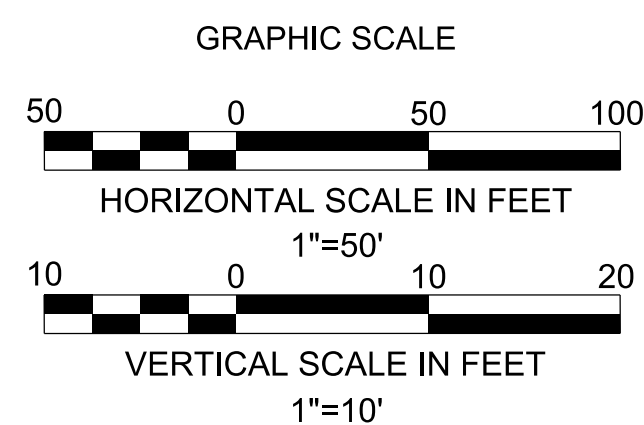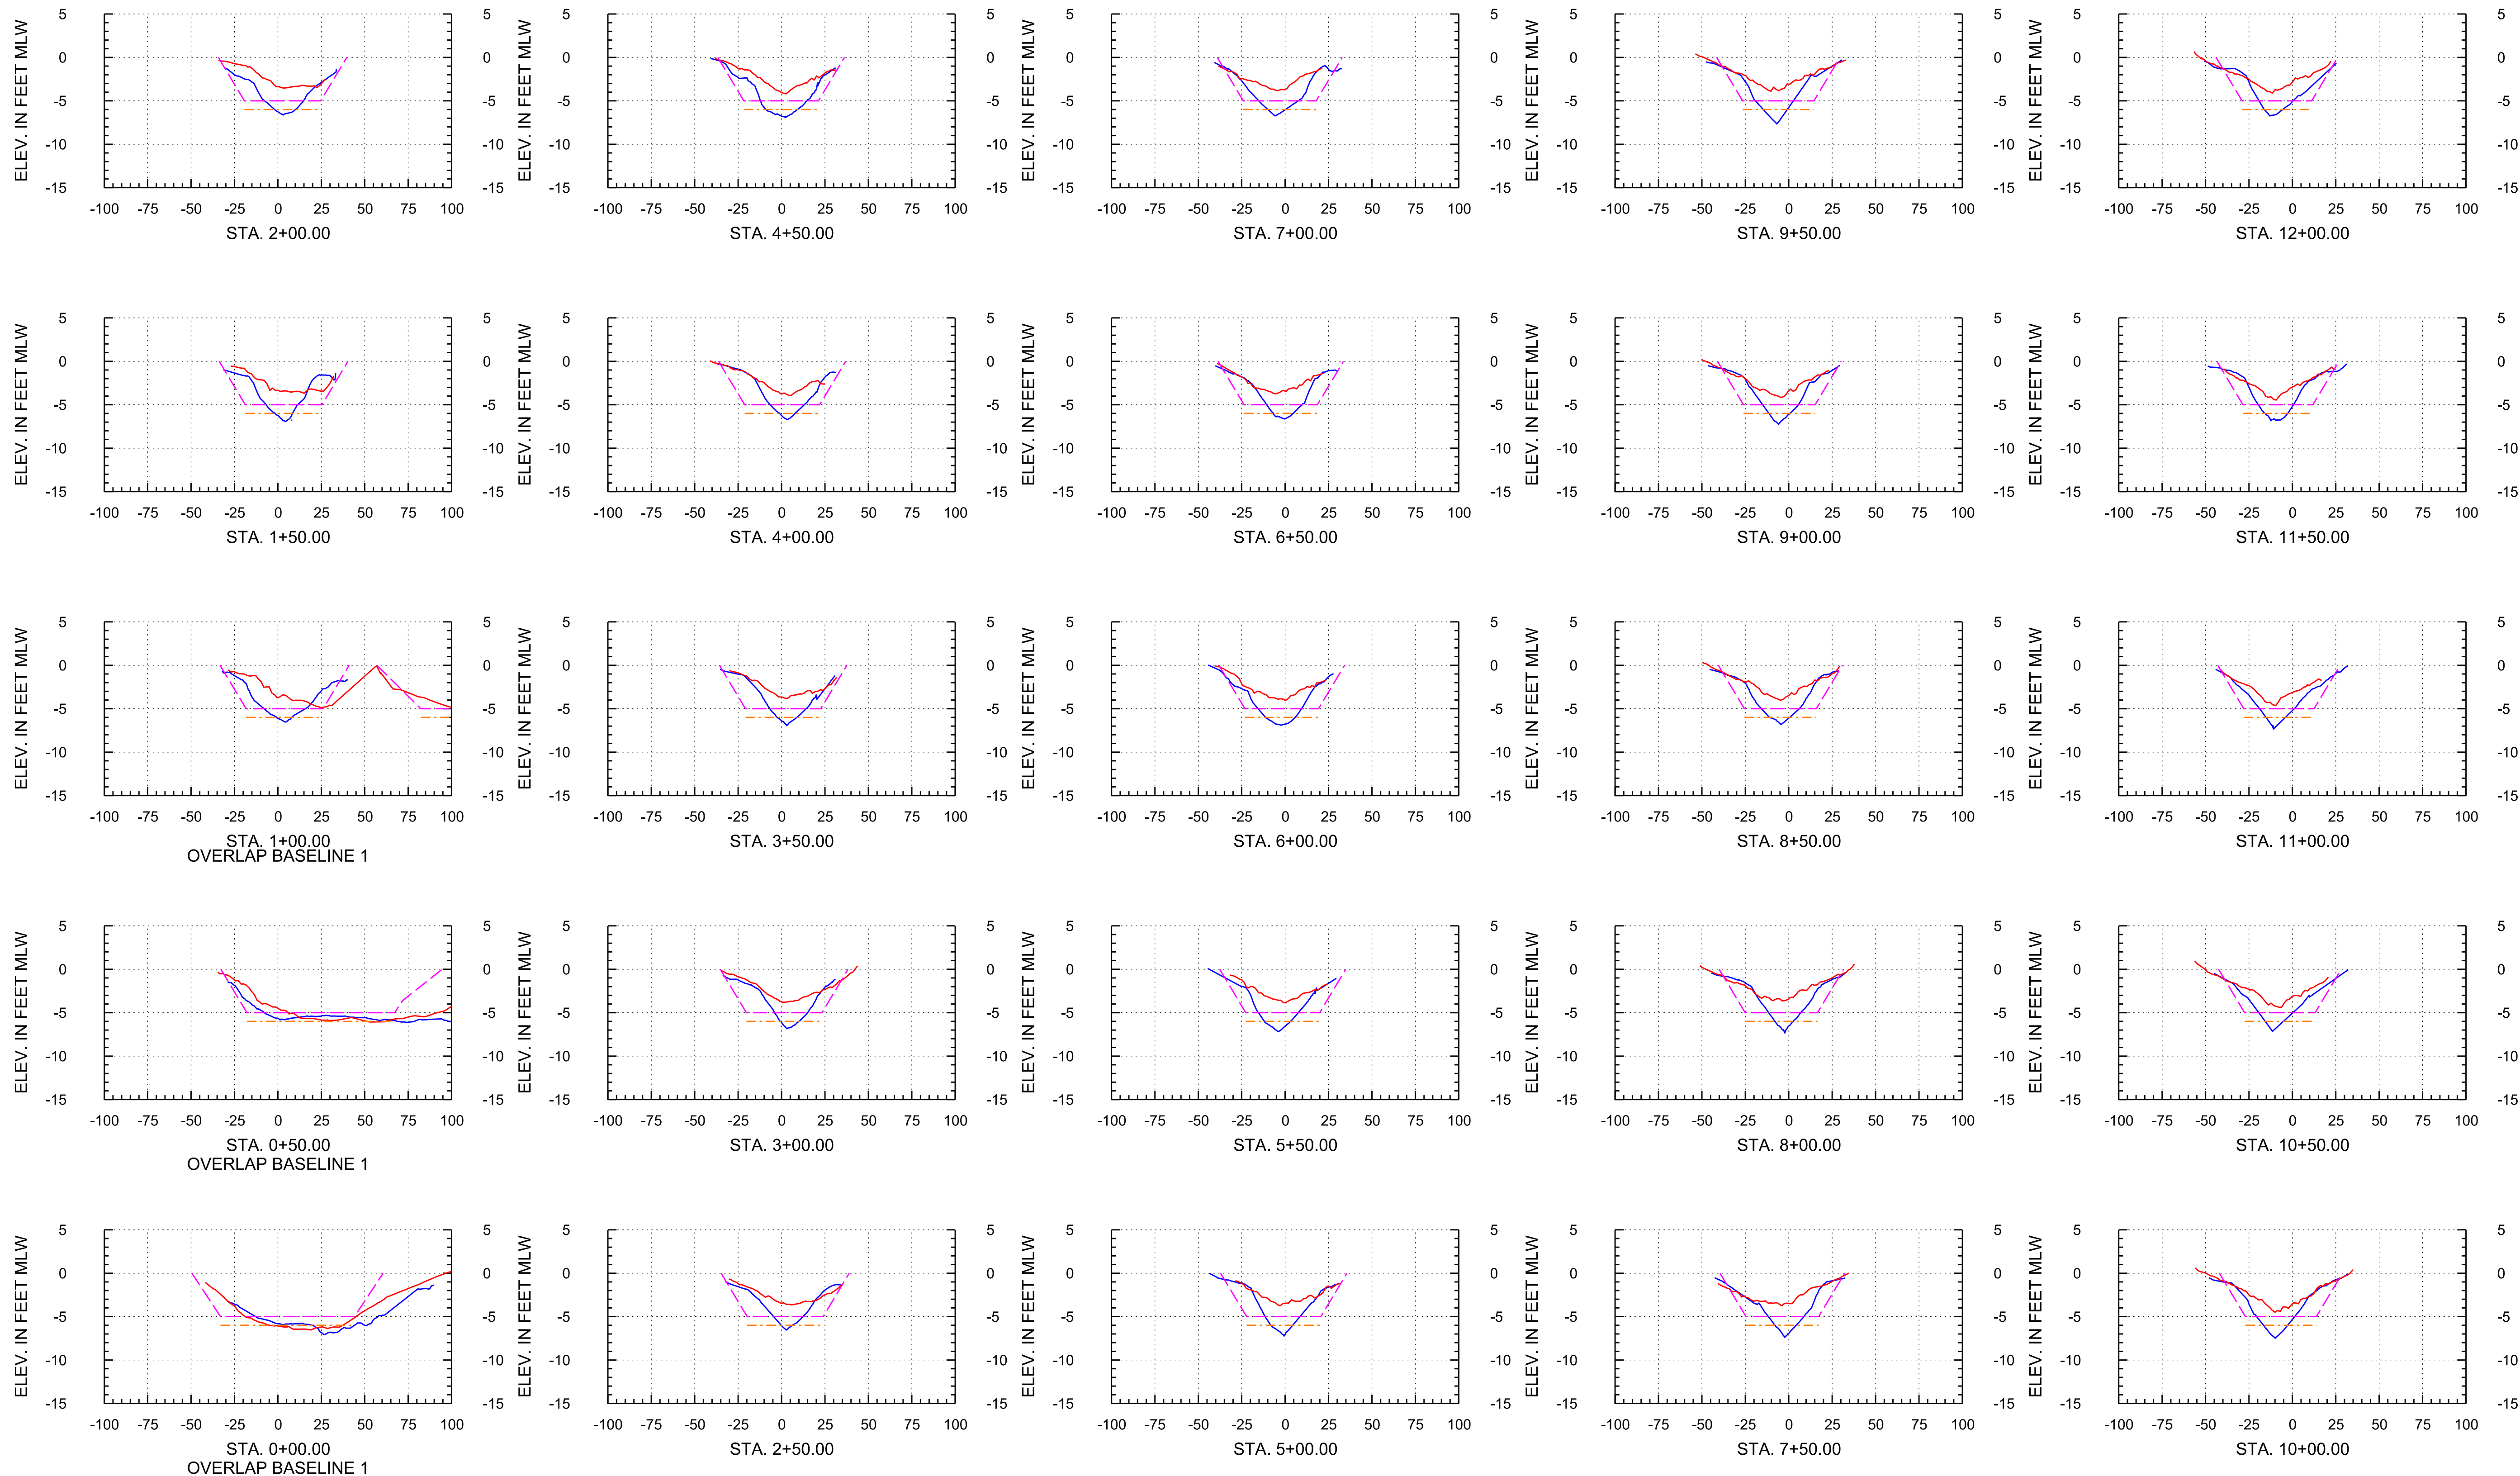

Arc Surveying & Mapping, Inc.
Professional Hydrographers • Surveyors • Mappers
5202 San Juan Avenue
Jacksonville, Florida 32210
904.384.8377

Prepared For:
Isle of Palms Special District
501 Riverside Avenue
Jacksonville, FL 32202

Project Title:
Isle of Palms North
Hydrographic After-Dredge #4 Survey

— = ARC SURVEY HYDROGRAPHIC SURVEY AUGUST 10, 2021
— = ARC SURVEY HYDROGRAPHIC SURVEY JUNE 23-JULY 6, 2020




MLW = MEAN LOW WATER
STA. = STATION

— = TEMPLATE AT -5' MLW (REVISED PER CLIENT)
— = TEMPLATE AT -6' MLW (REVISED PER CLIENT)

DATE	BY	REVISION

LB No. 6487
Drawn By: D. Trubits
Scale: see map
Plot Date: 08/16/21
File Name:
Fld Bk / Pg:
ARC Project No.:
2020-0077 AD4
SHEET: 10 OF: 20

ISLE OF PALMS NORTH, SURVEY BASELINE 2

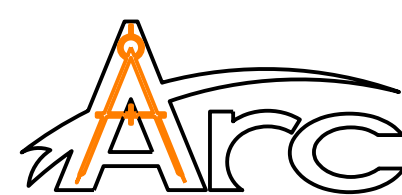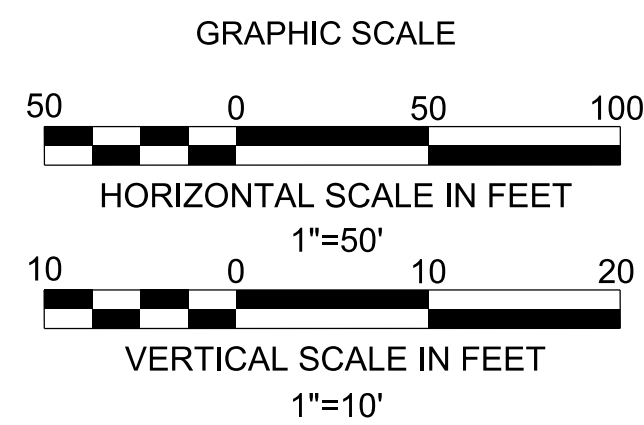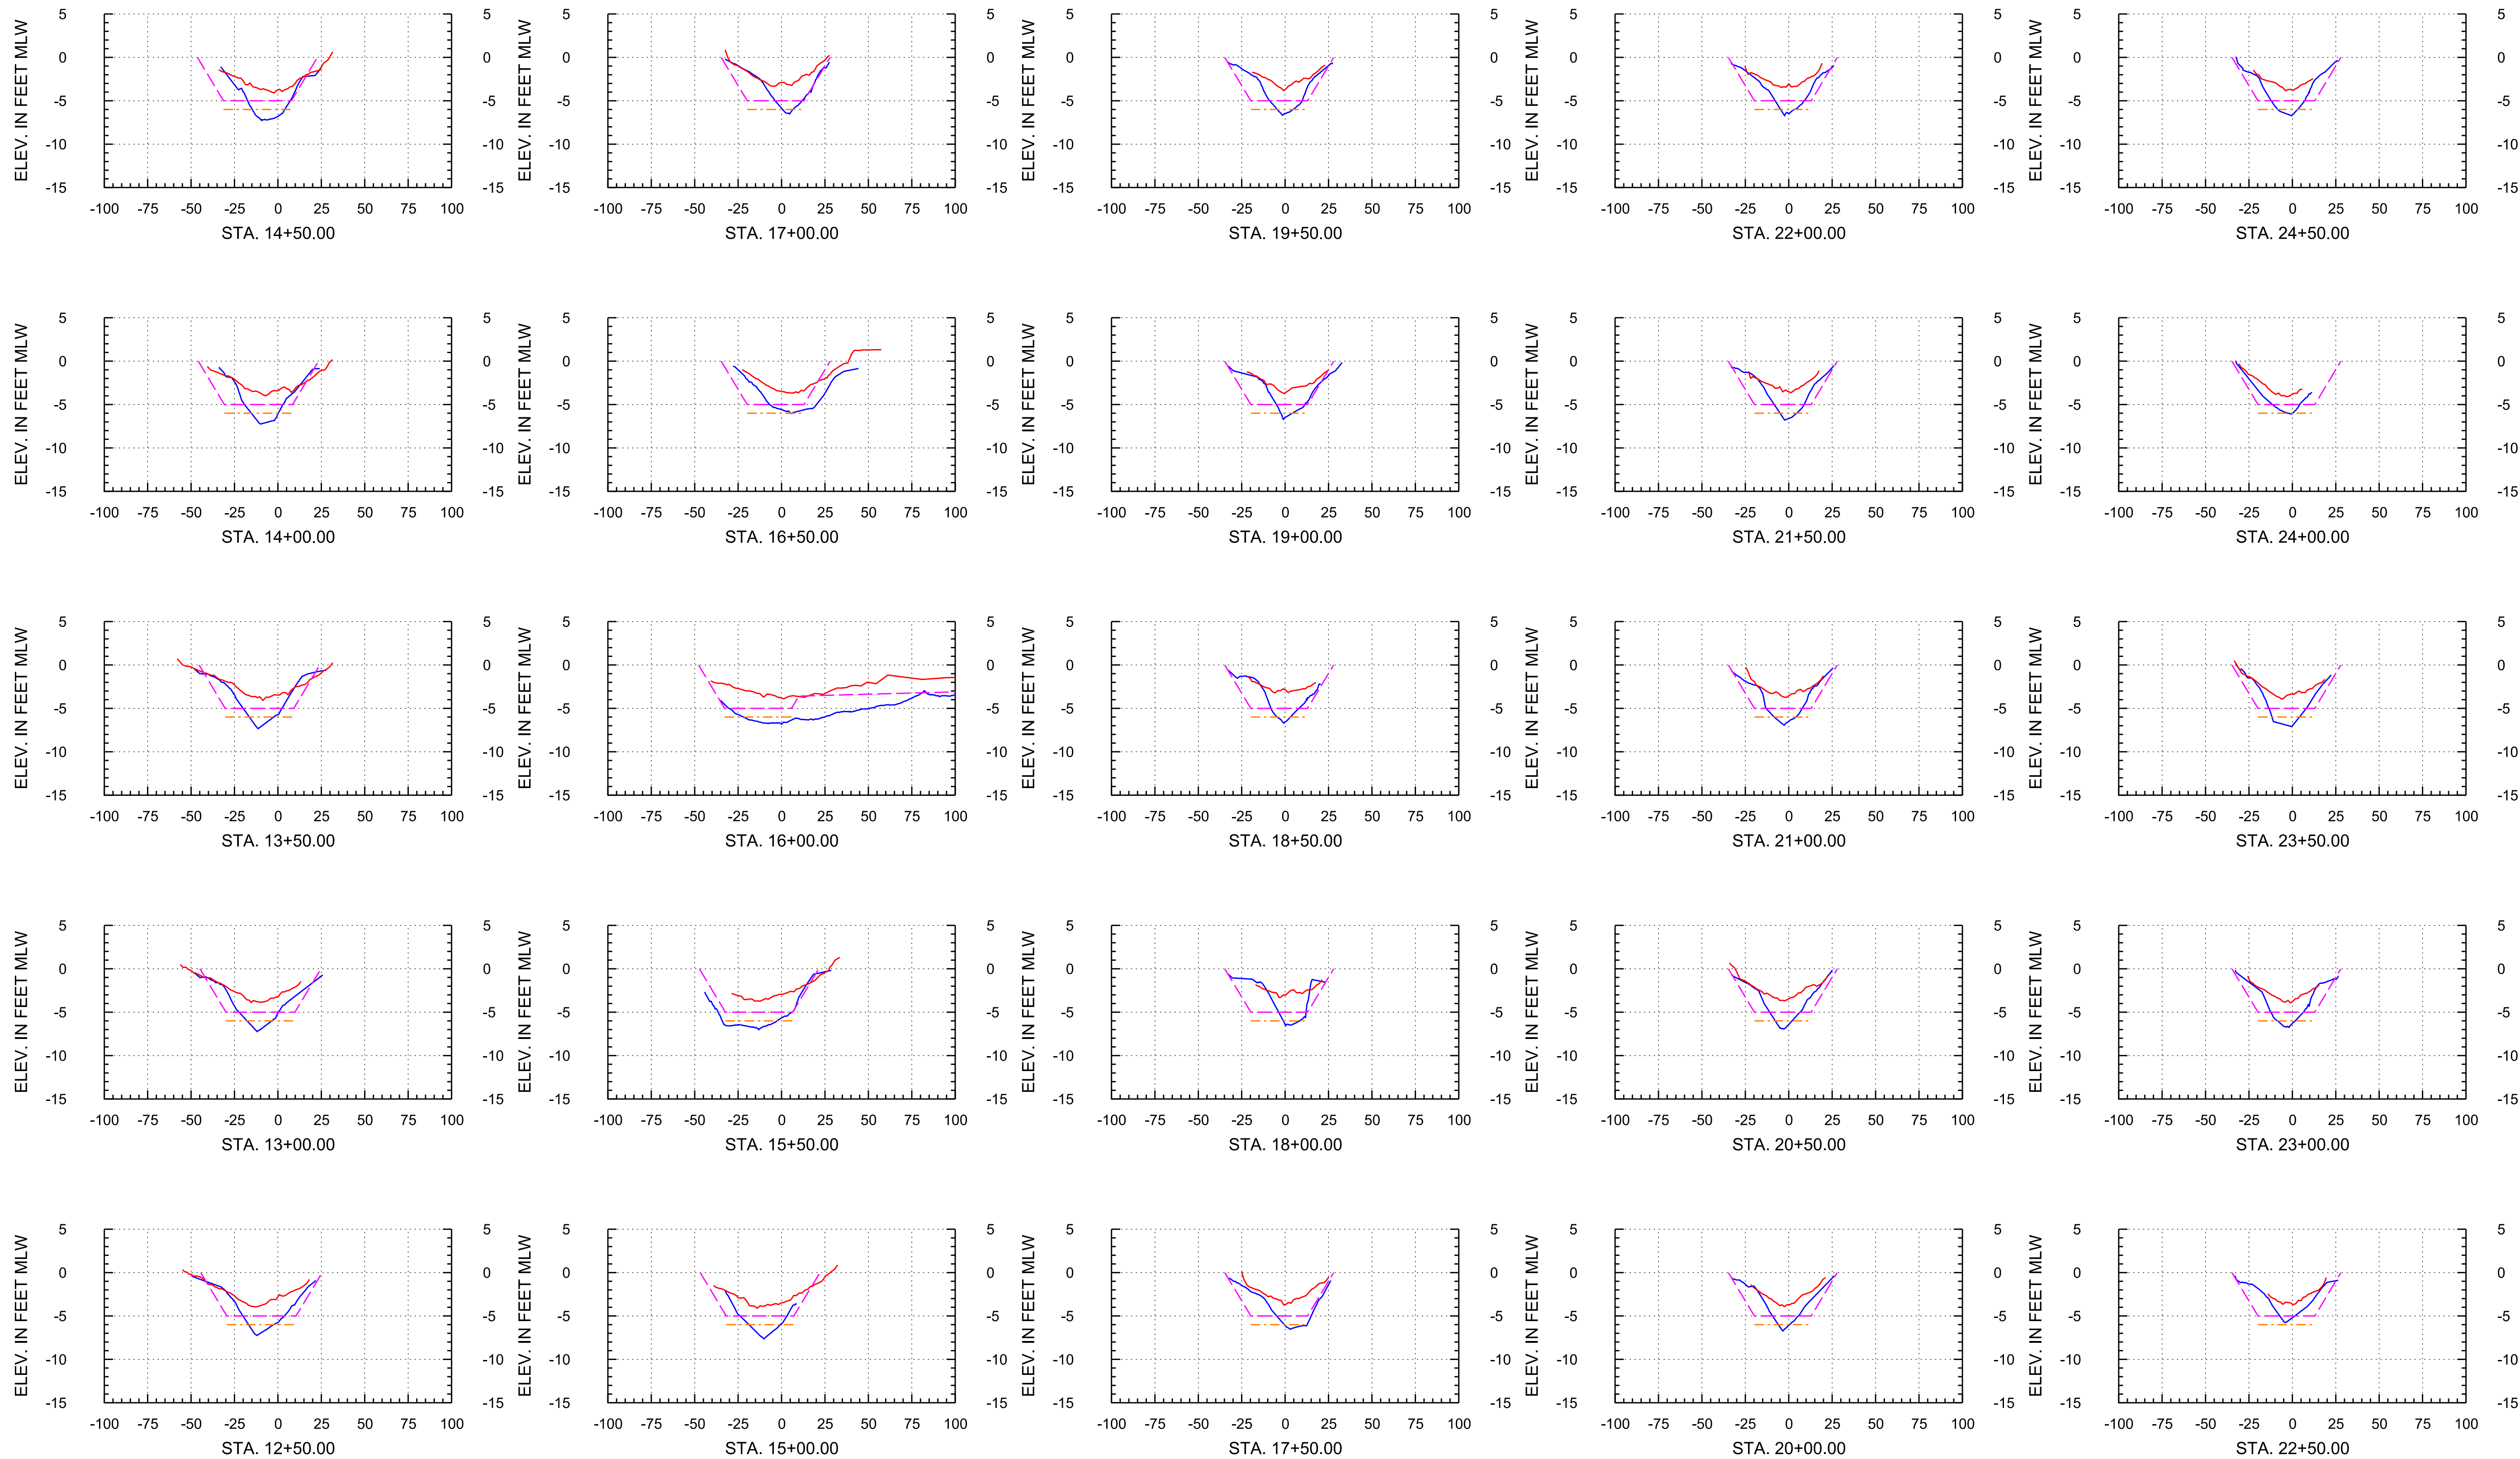

Arc Surveying & Mapping, Inc.
Professional Hydrographers • Surveyors • Mappers
5202 San Juan Avenue
Jacksonville, Florida 32210
904.384.8377

Prepared For:
Isle of Palms Special District
501 Riverside Avenue
Jacksonville, FL 32202

Project Title:
Isle of Palms North
Hydrographic After-Dredge #4 Survey

— = ARC SURVEY HYDROGRAPHIC SURVEY AUGUST 10, 2021
— = ARC SURVEY HYDROGRAPHIC SURVEY JUNE 23-JULY 6, 2020




MLW = MEAN LOW WATER
STA. = STATION

— = TEMPLATE AT -5' MLW (REVISED PER CLIENT)
— = TEMPLATE AT -6' MLW (REVISED PER CLIENT)

DATE	BY	REVISION

LB No. 6487
Drawn By: D. Trubits
Scale: see map
Plot Date: 08/16/21
File Name:
Fld Bk / Pg:
ARC Project No.:
2020-0077 AD4
SHEET: 11 OF: 20

ISLE OF PALMS NORTH, SURVEY BASELINE 2

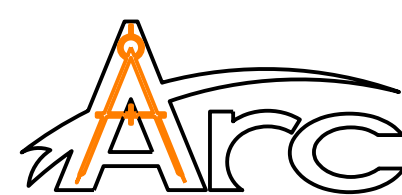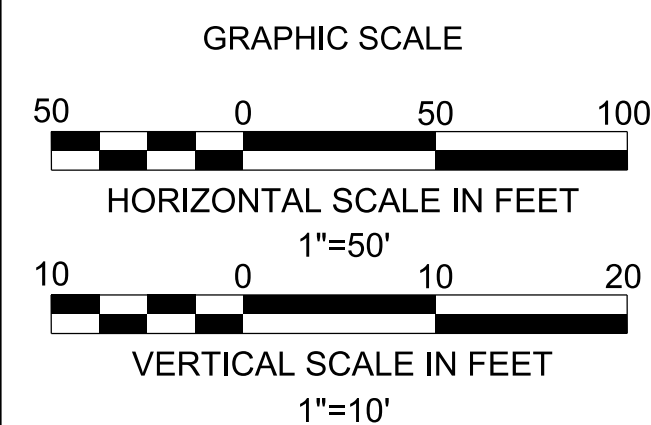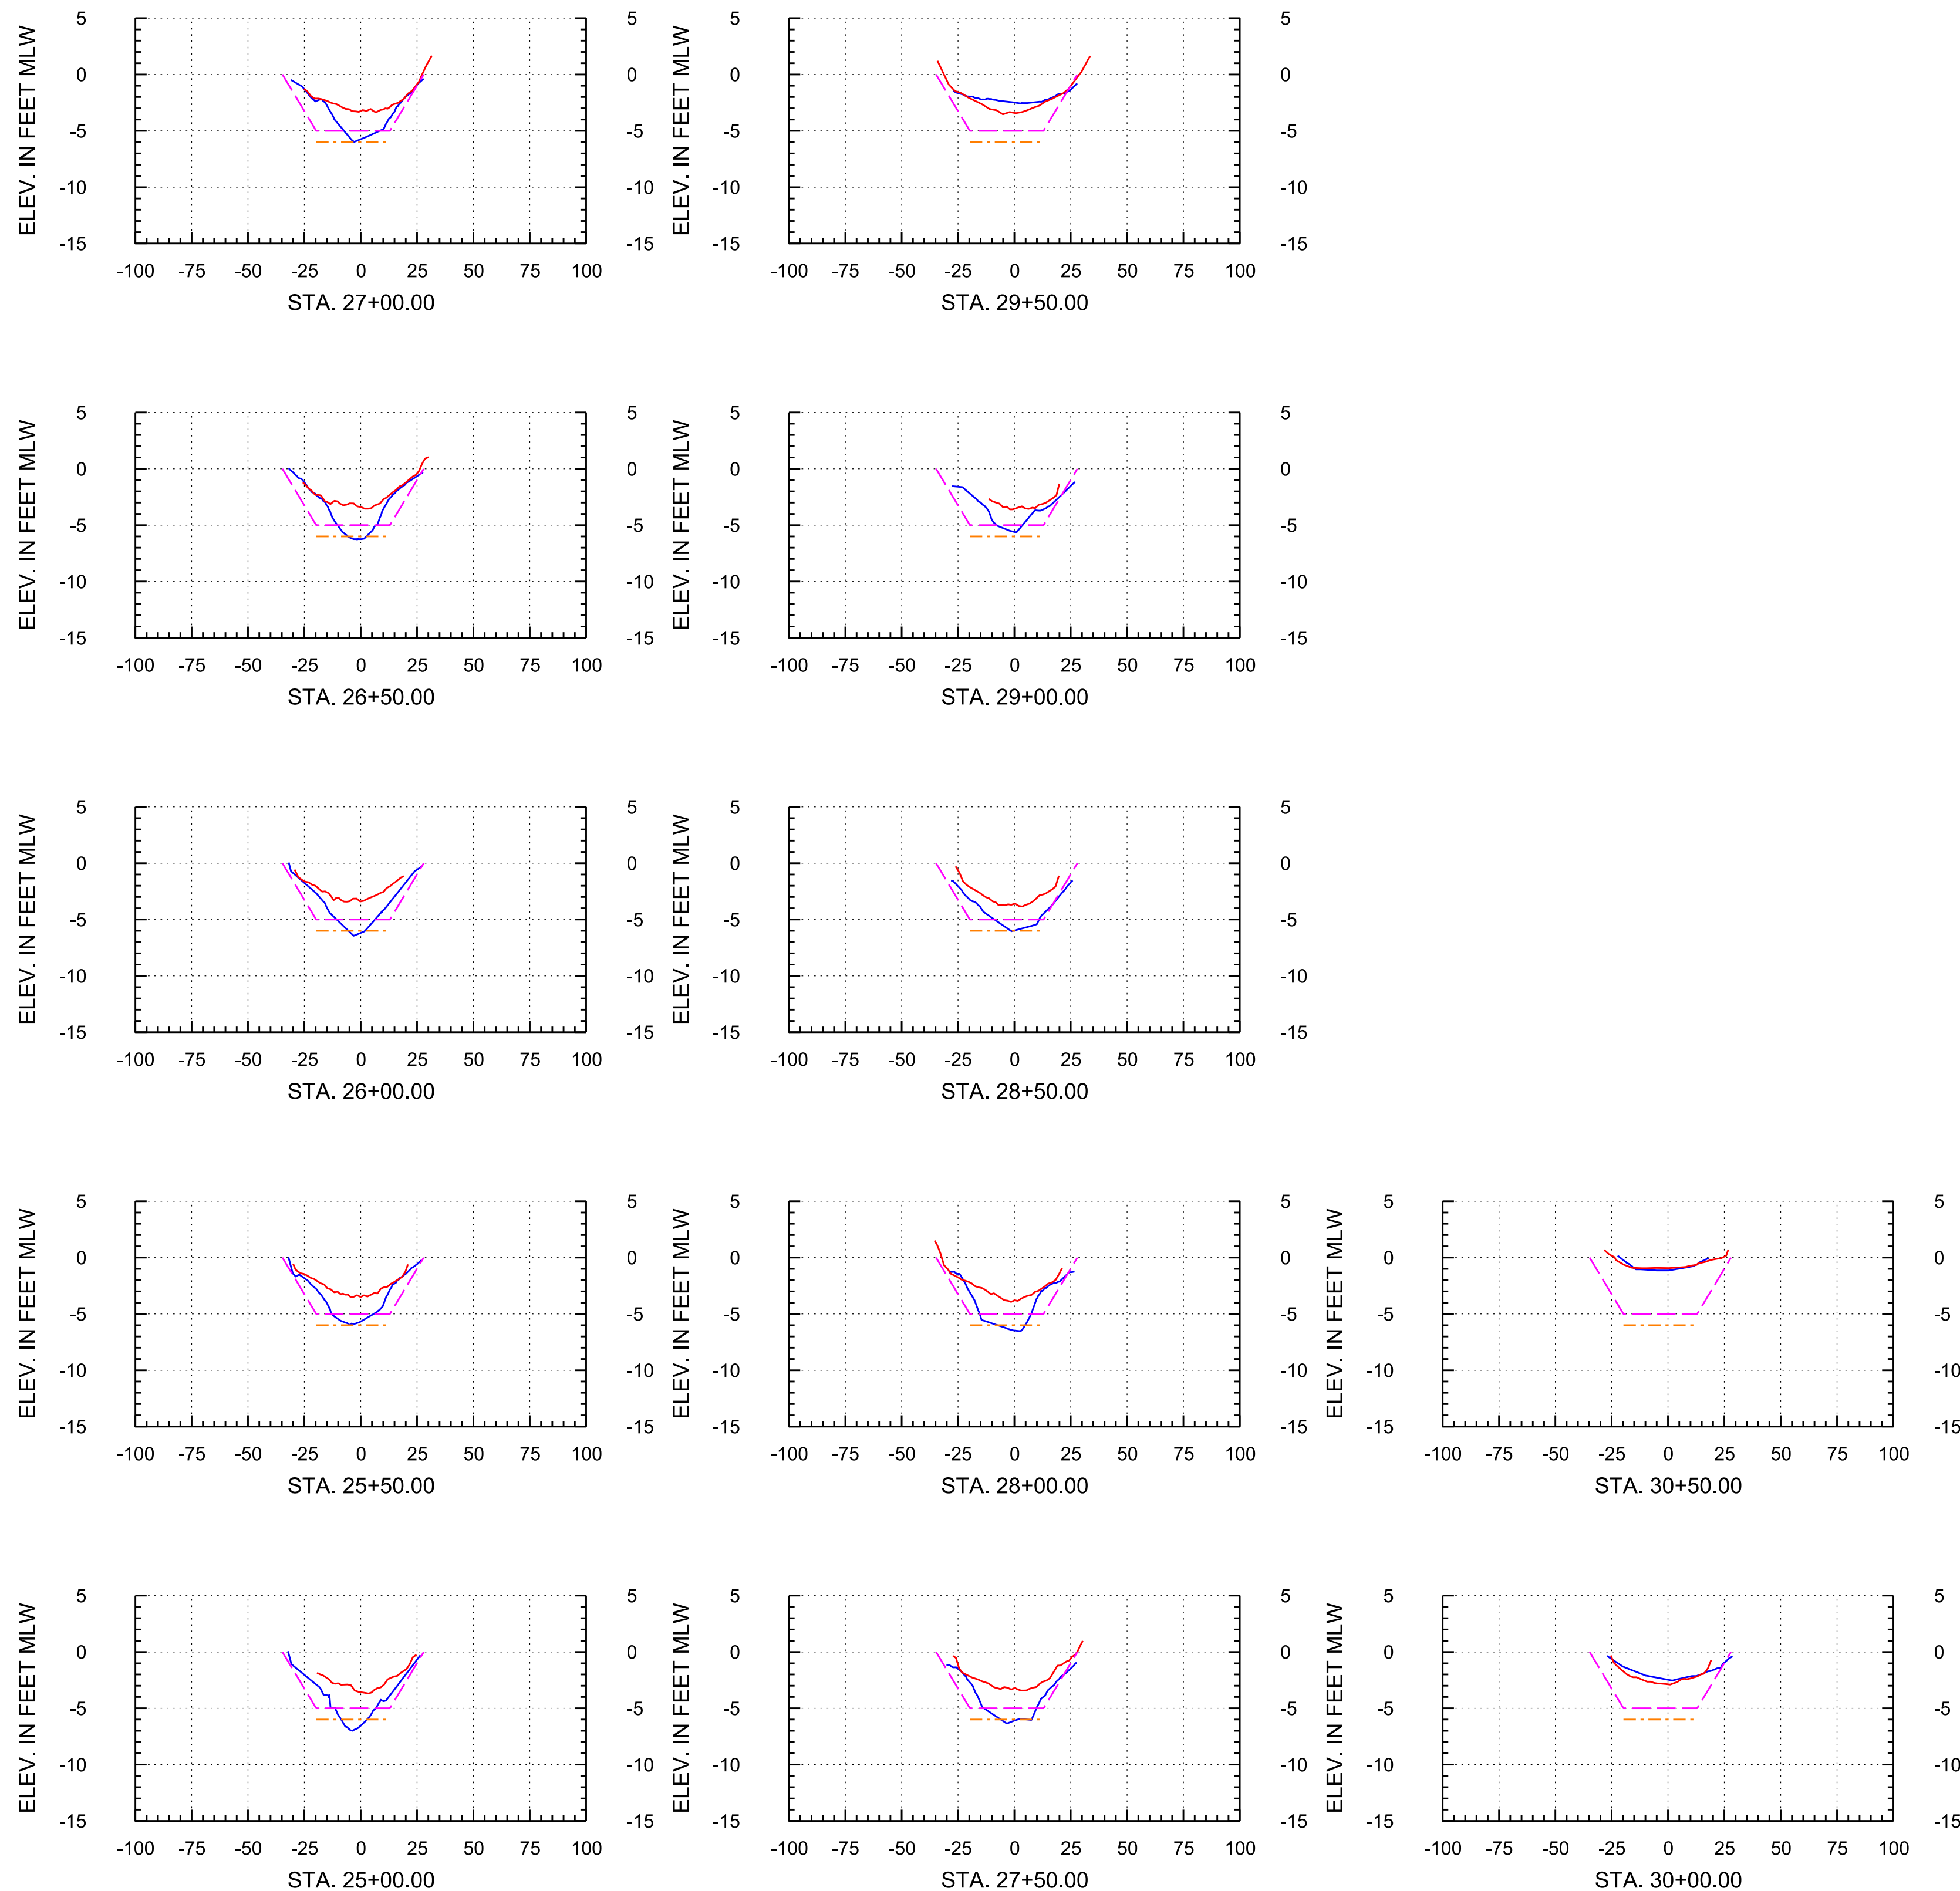

Arc Surveying & Mapping, Inc.
Professional Hydrographers • Surveyors • Mappers
5202 San Juan Avenue
Jacksonville, Florida 32210
904.384.8377

Prepared For:
Isle of Palms Special District
501 Riverside Avenue
Jacksonville, FL 32202

Project Title:
Isle of Palms North
Hydrographic After-Dredge #4 Survey

— = ARC SURVEY HYDROGRAPHIC SURVEY AUGUST 10, 2021
— = ARC SURVEY HYDROGRAPHIC SURVEY JUNE 23-JULY 6, 2020




MLW = MEAN LOW WATER
STA. = STATION

- - = TEMPLATE AT -5' MLW (REVISED PER CLIENT)
- - = TEMPLATE AT -6' MLW (REVISED PER CLIENT)

DATE	BY	REVISION

LB No. 6487
Drawn By: D. Trabits
Scale: see map
Plot Date: 08/16/21
File Name:
Fld Bk / Pg:
ARC Project No.:
2020-0077 AD4
SHEET: 12 OF: 20

ISLE OF PALMS NORTH, SURVEY BASELINE 3

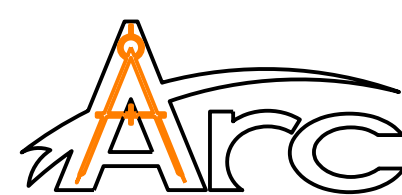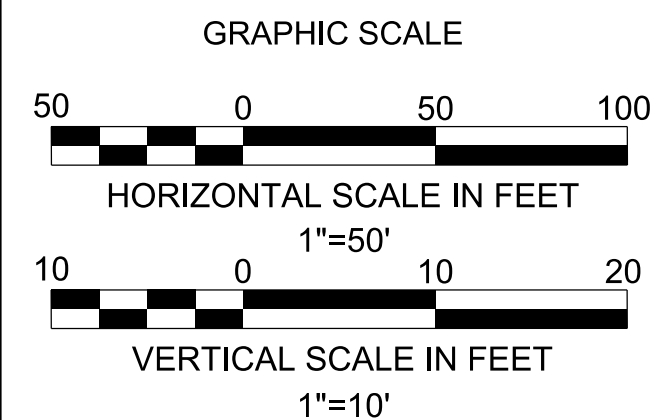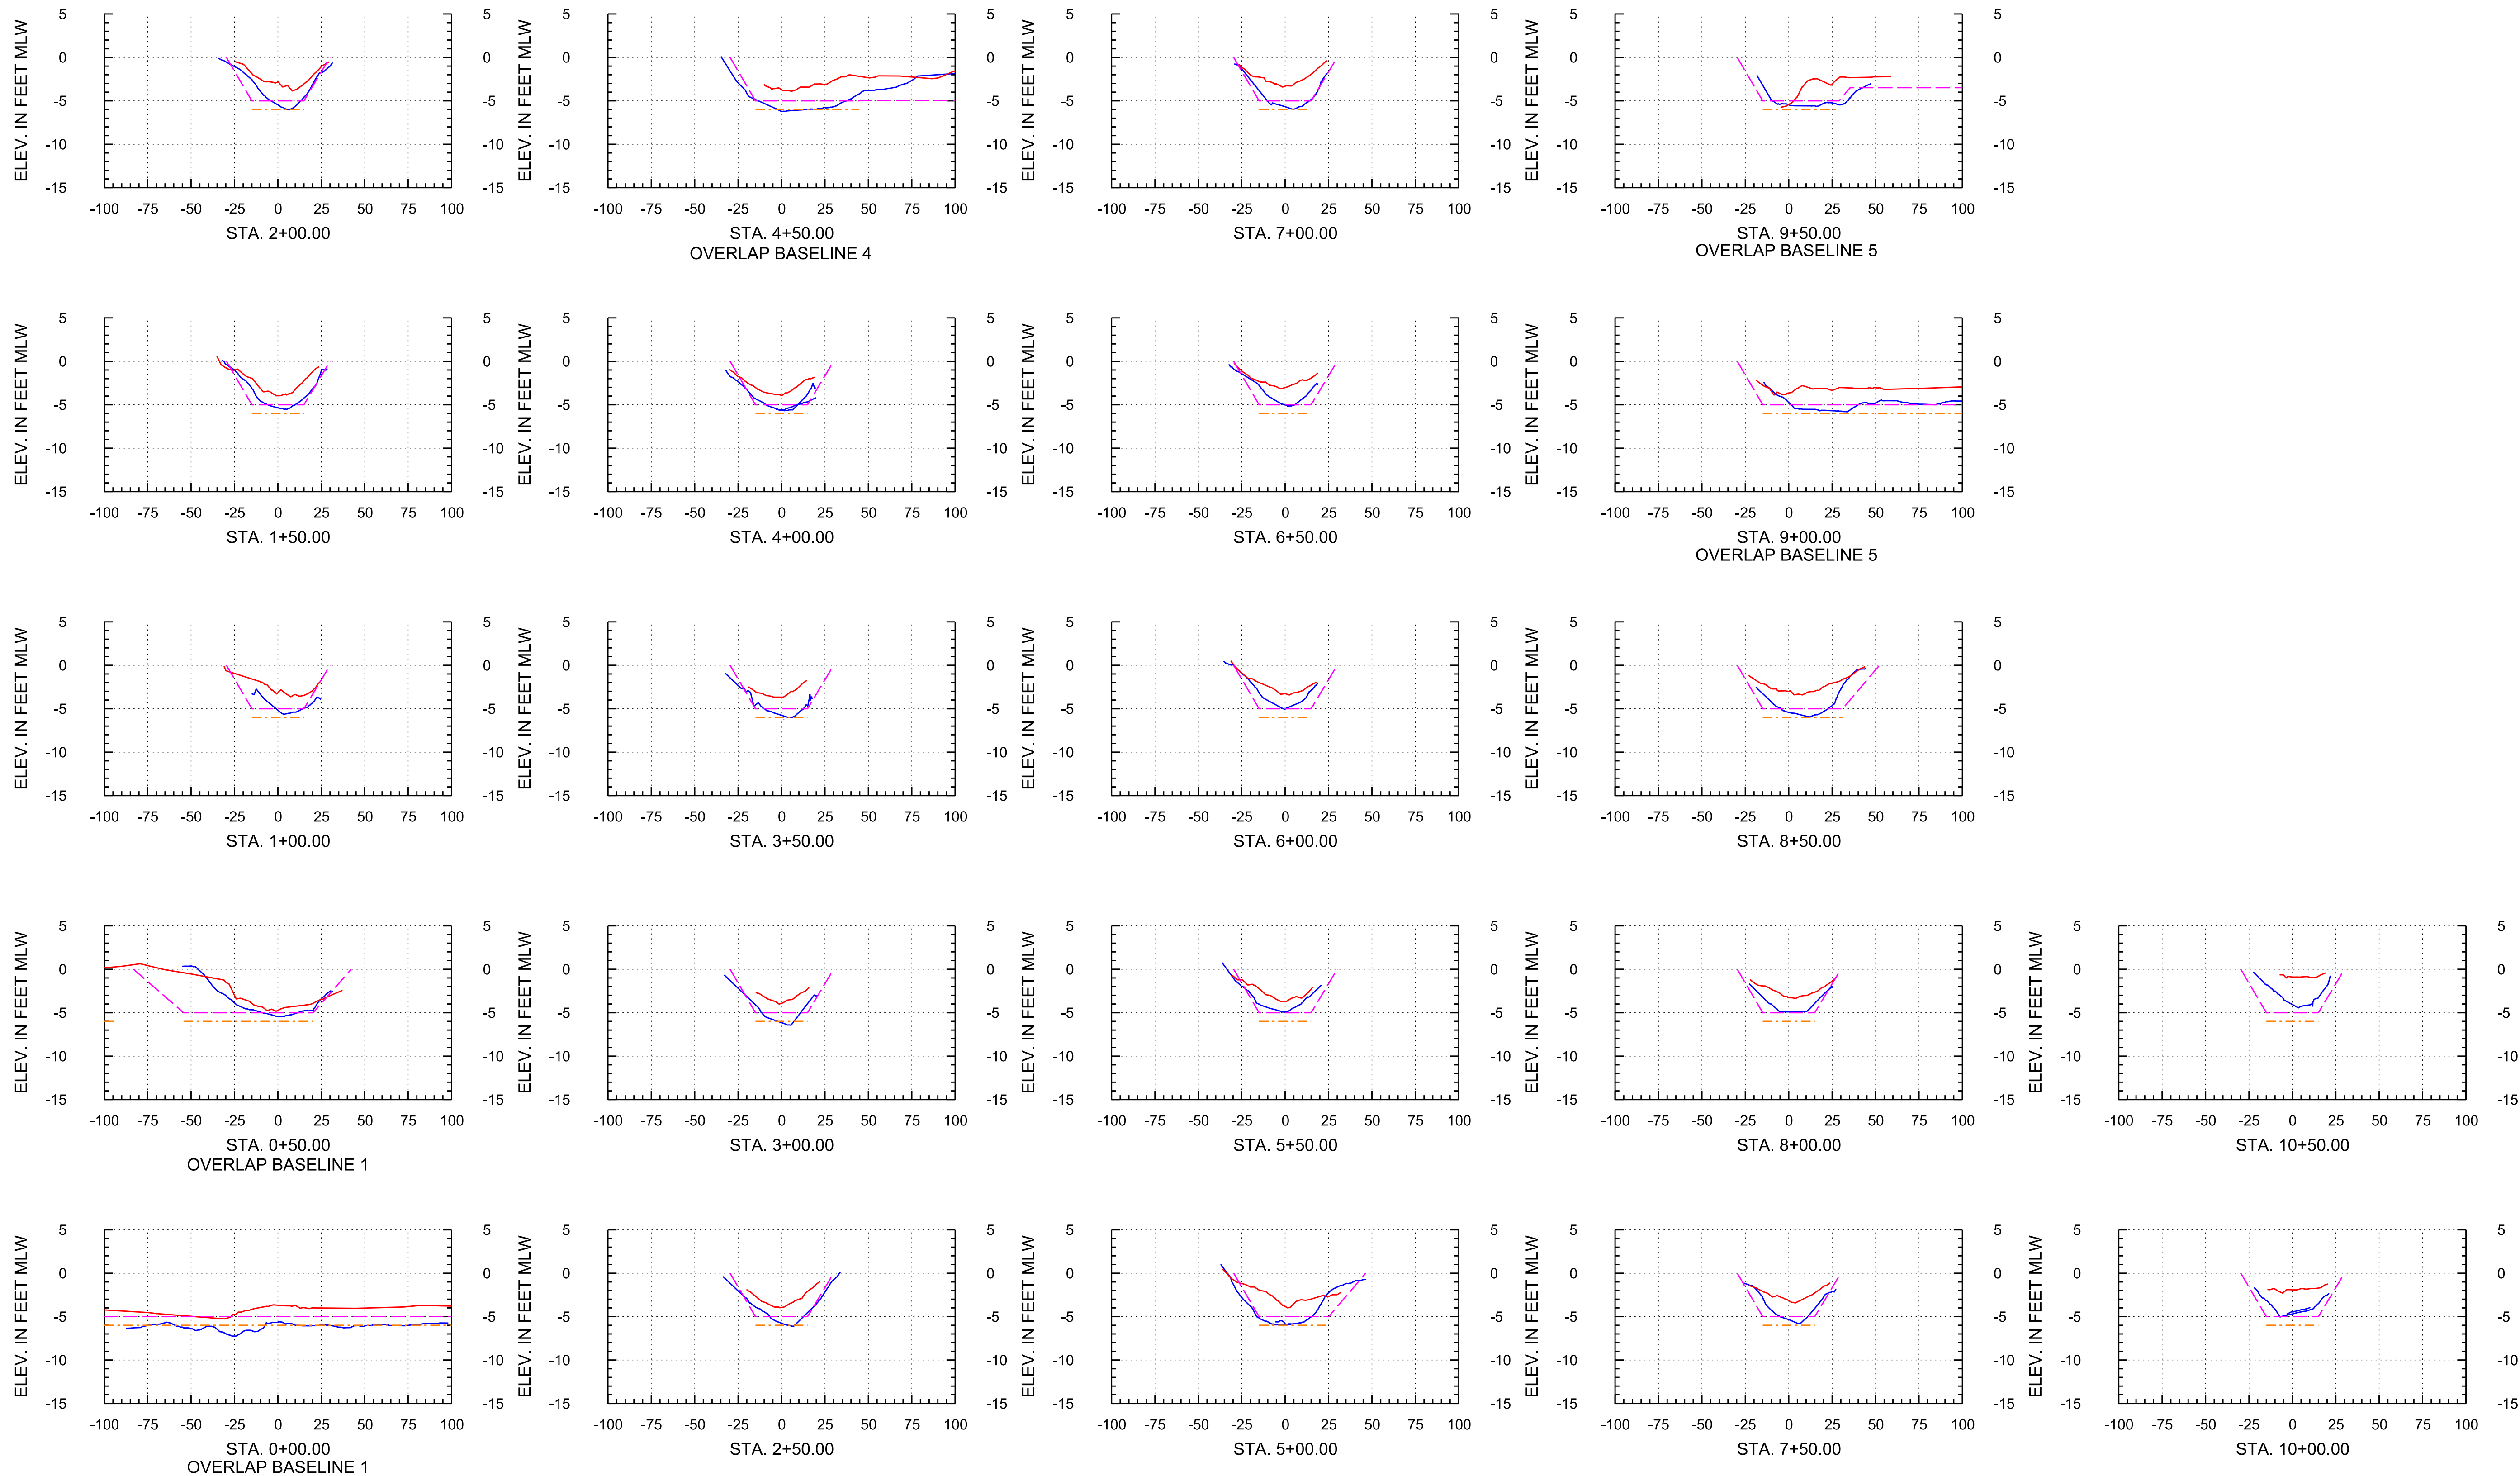

Arc Surveying & Mapping, Inc.
Professional Hydrographers • Surveyors • Mappers
5202 San Juan Avenue
Jacksonville, Florida 32210
904.384.8377

Prepared For:
Isle of Palms Special District
501 Riverside Avenue
Jacksonville, FL 32202

Project Title:
Isle of Palms North
Hydrographic After-Dredge #4 Survey

— = ARC SURVEY HYDROGRAPHIC SURVEY AUGUST 10, 2021
— = ARC SURVEY HYDROGRAPHIC SURVEY JUNE 23-JULY 6, 2020




MLW = MEAN LOW WATER
STA. = STATION

— = TEMPLATE AT -5' MLW (REVISED PER CLIENT)
— = TEMPLATE AT -6' MLW (REVISED PER CLIENT)

DATE	BY	REVISION

LB No. 6487
Drawn By: D. Trabis
Scale: see map
Plot Date: 08/16/21
File Name:
Fld Bk / Pg:
ARC Project No.:
2020-0077 AD4
SHEET: 13 OF: 20

ISLE OF PALMS NORTH, SURVEY BASELINE 4

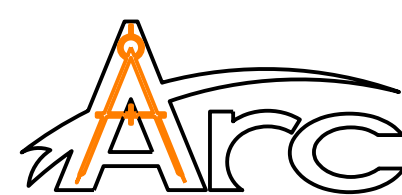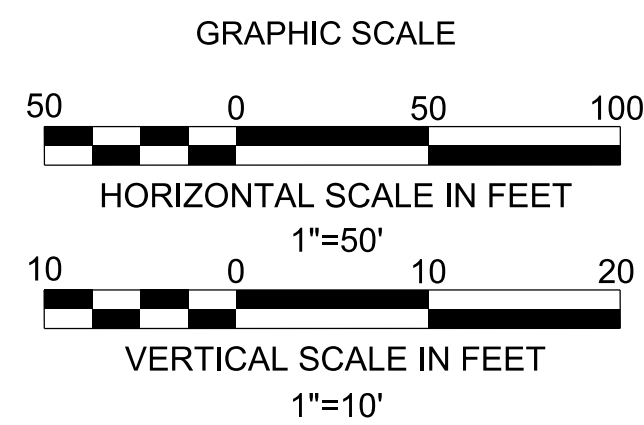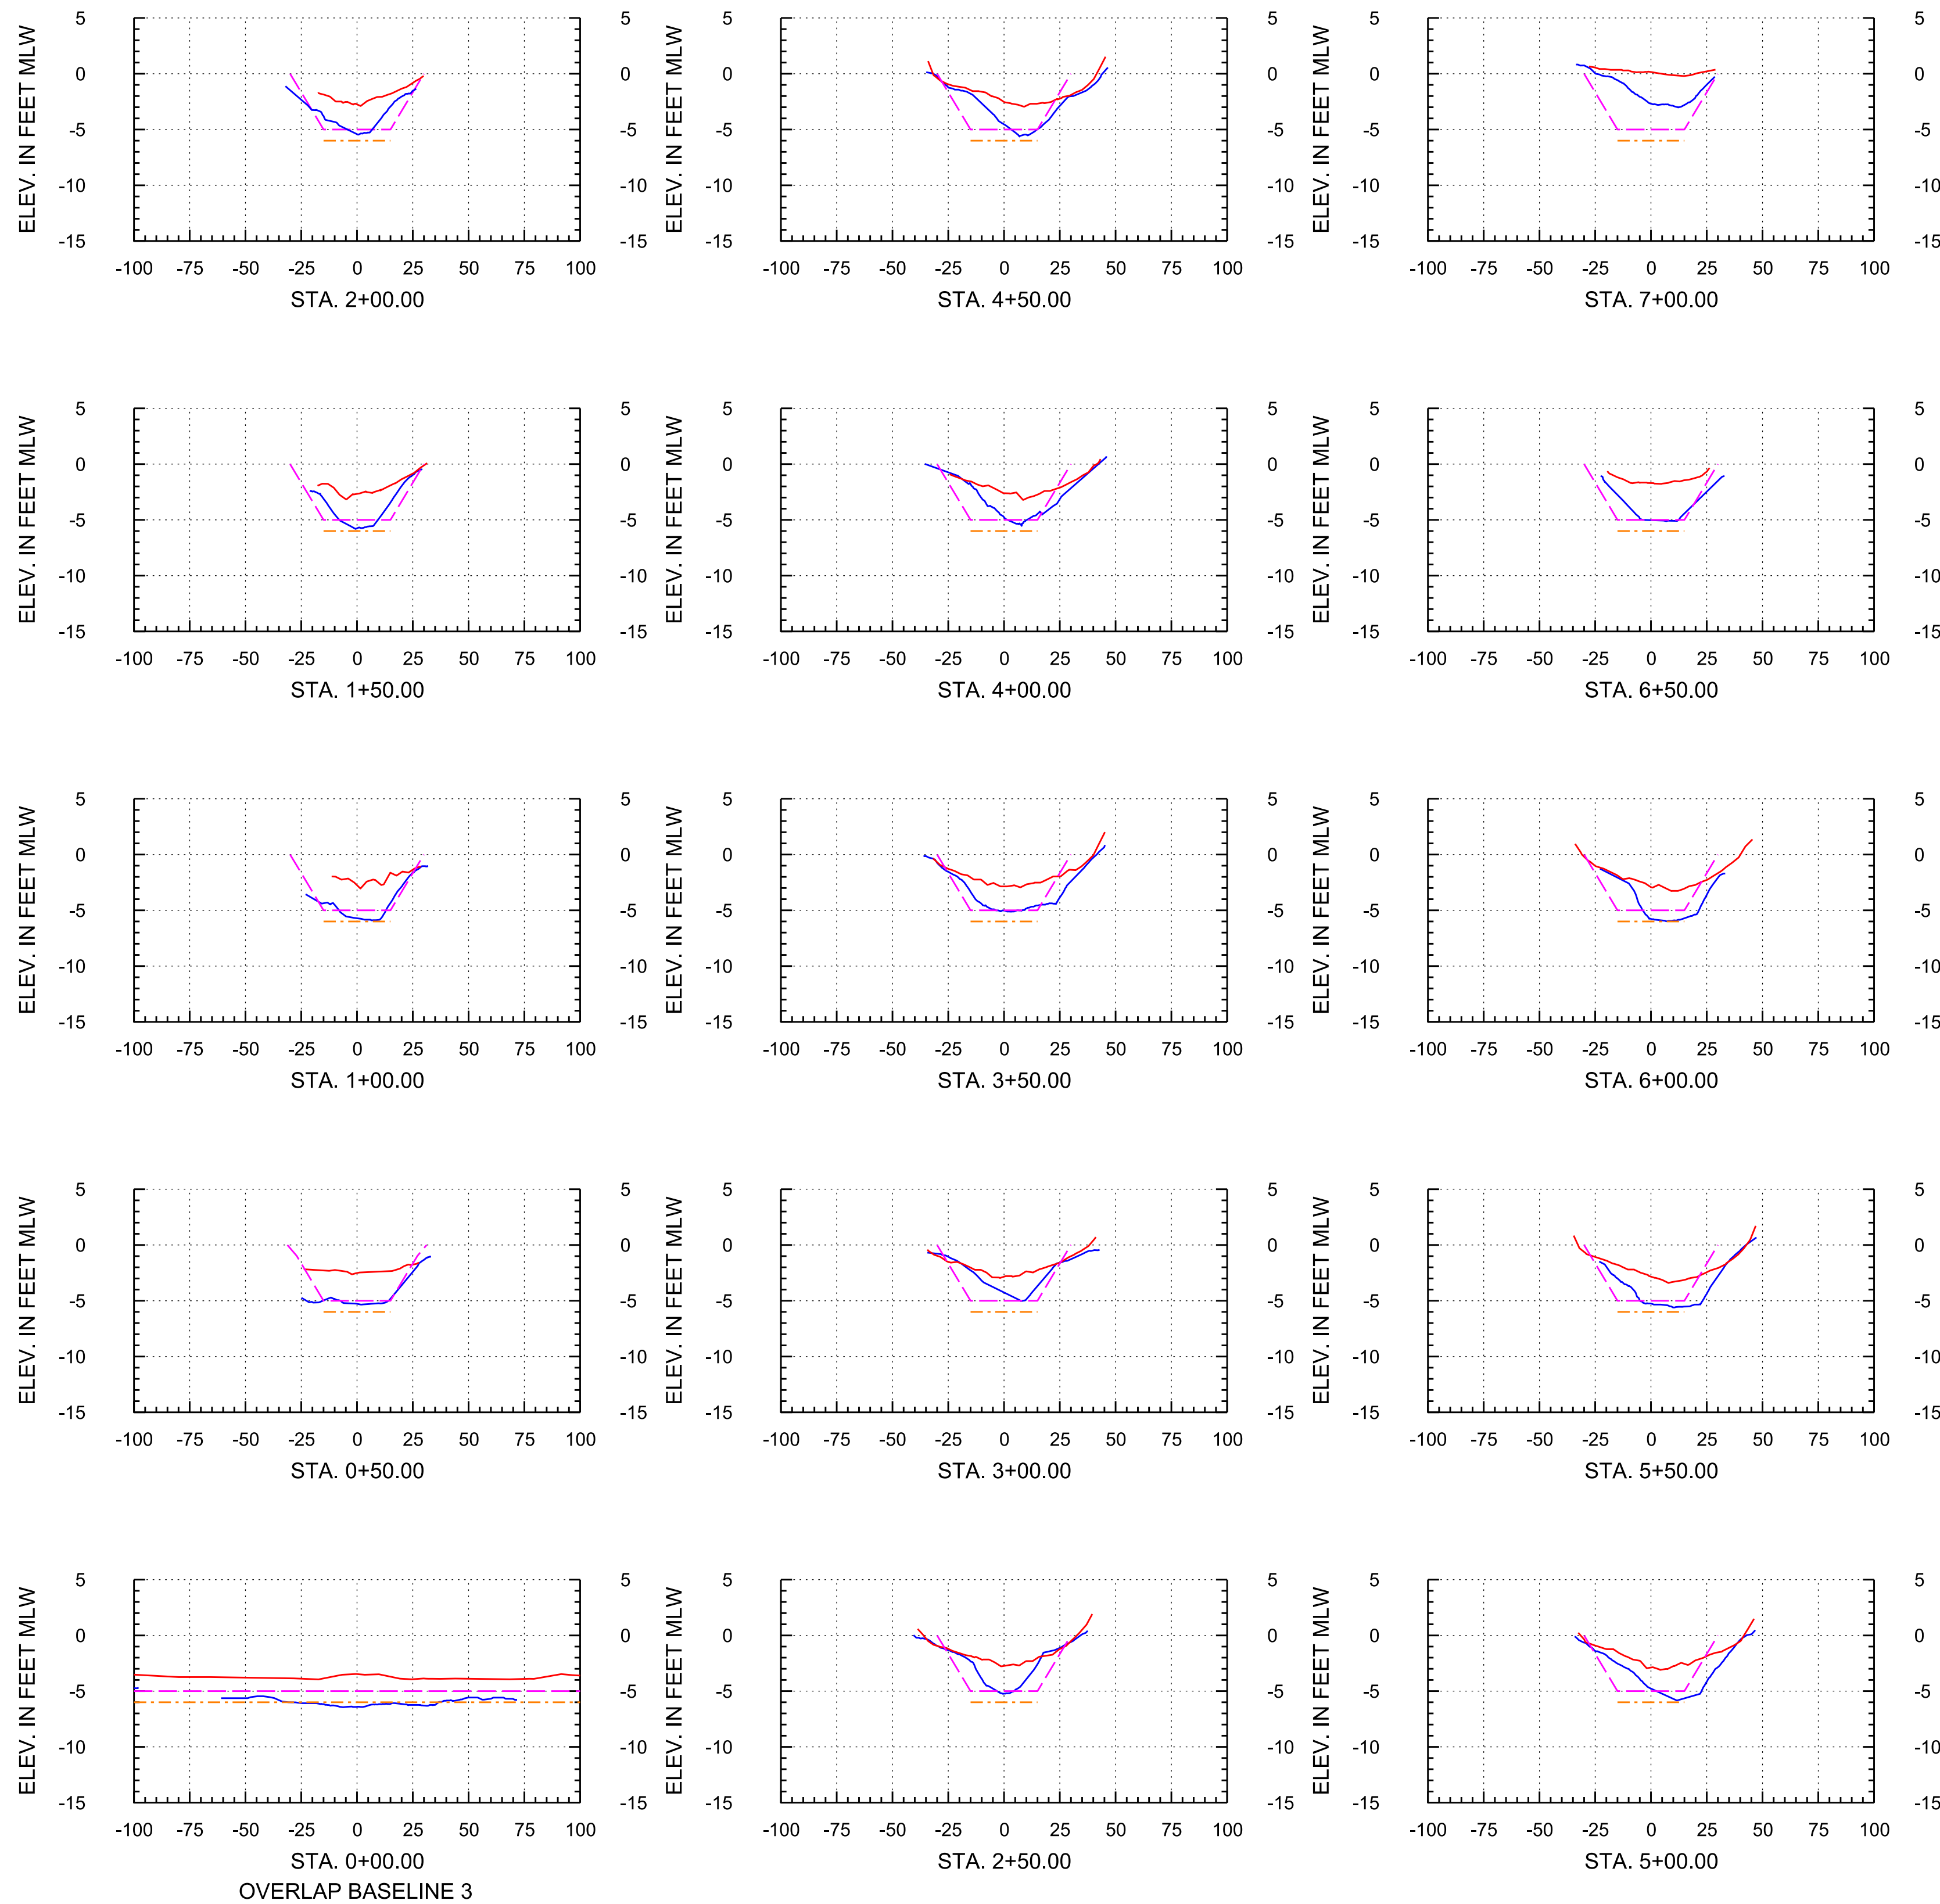

Arc Surveying & Mapping, Inc.
Professional Hydrographers • Surveyors • Mappers
5202 San Juan Avenue
Jacksonville, Florida 32210
904.384.8377

Prepared For:
Isle of Palms Special District
501 Riverside Avenue
Jacksonville, FL 32202

Project Title:
Isle of Palms North
Hydrographic After-Dredge #4 Survey

— = ARC SURVEY HYDROGRAPHIC SURVEY AUGUST 10, 2021
— = ARC SURVEY HYDROGRAPHIC SURVEY JUNE 23-JULY 6, 2020




MLW = MEAN LOW WATER
STA. = STATION

— = TEMPLATE AT -5' MLW (REVISED PER CLIENT)
— = TEMPLATE AT -6' MLW (REVISED PER CLIENT)

DATE	BY	REVISION

LB No. 6487
Drawn By: D. Trabis
Scale: see map
Plot Date: 08/16/21
File Name:
Fld Bk / Pg:
ARC Project No.:
2020-0077 AD4
SHEET: 14 OF: 20

ISLE OF PALMS NORTH, SURVEY BASELINE 5

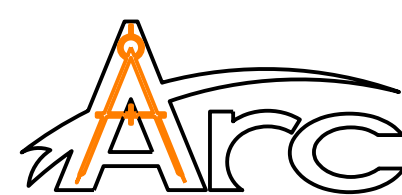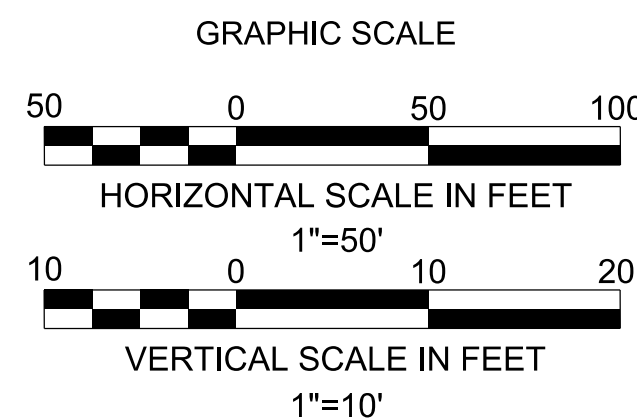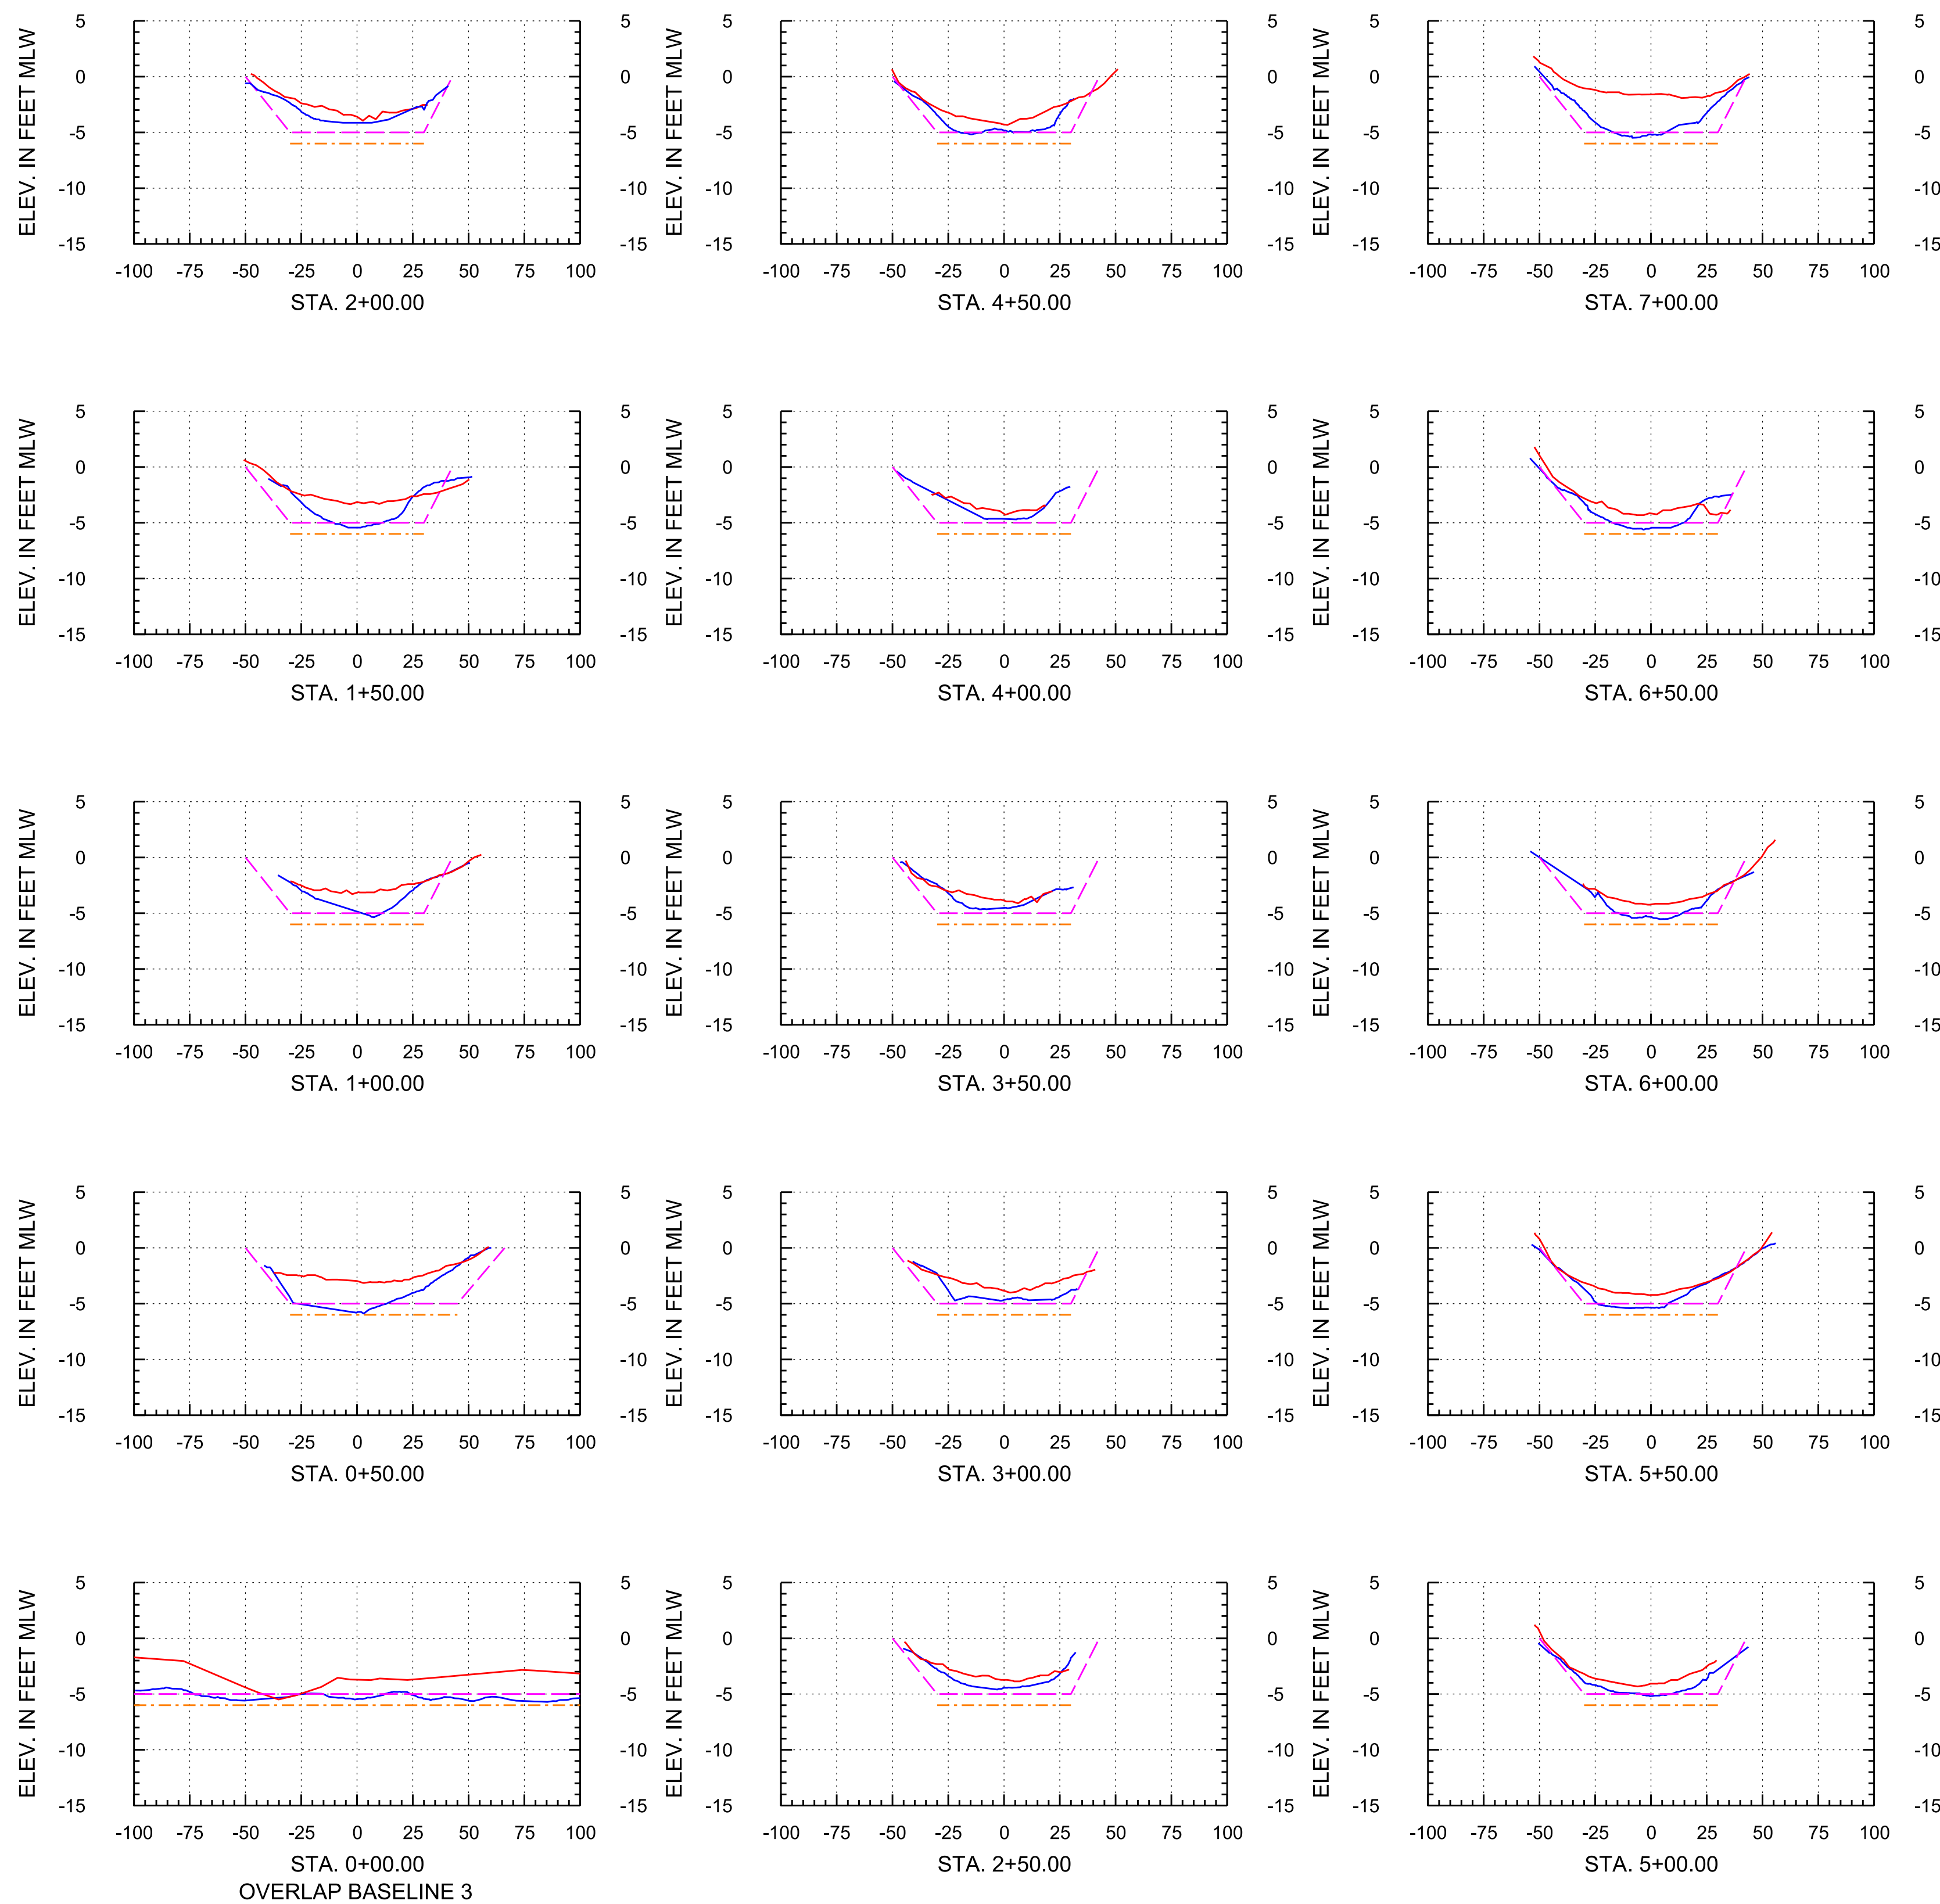

Arc Surveying & Mapping, Inc.
Professional Hydrographers • Surveyors • Mappers
5202 San Juan Avenue
Jacksonville, Florida 32210
904.384.8377

Prepared For:
Isle of Palms Special District
501 Riverside Avenue
Jacksonville, FL 32202

Project Title:
**Isle of Palms North
Hydrographic After-Dredge #4 Survey**

— = ARC SURVEY HYDROGRAPHIC SURVEY AUGUST 10, 2021
— = ARC SURVEY HYDROGRAPHIC SURVEY JUNE 23-JULY 6, 2020




MLW = MEAN LOW WATER
STA. = STATION

— = TEMPLATE AT -5' MLW (REVISED PER CLIENT)
— = TEMPLATE AT -6' MLW (REVISED PER CLIENT)

DATE	BY	REVISION

LB No. 6487
Drawn By: D. Trabis
Scale: see map
Plot Date: 08/16/21
File Name:
Fld Bk / Pg:
ARC Project No.:
2020-0077 AD4
SHEET: 15 OF: 20

ISLE OF PALMS NORTH, SURVEY BASELINE 6

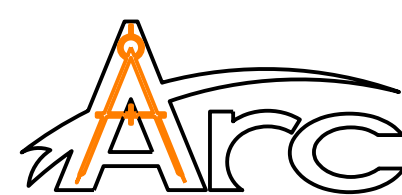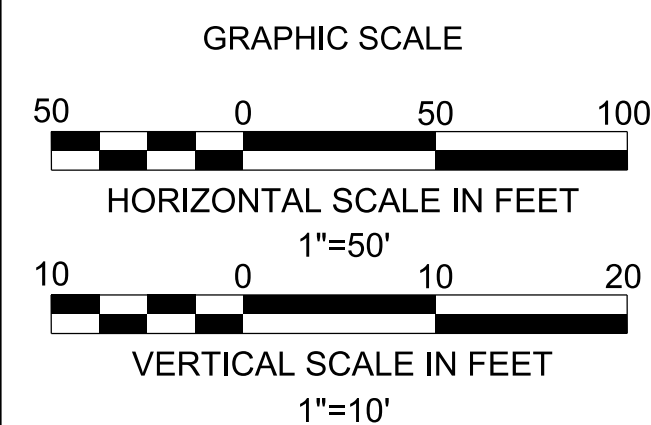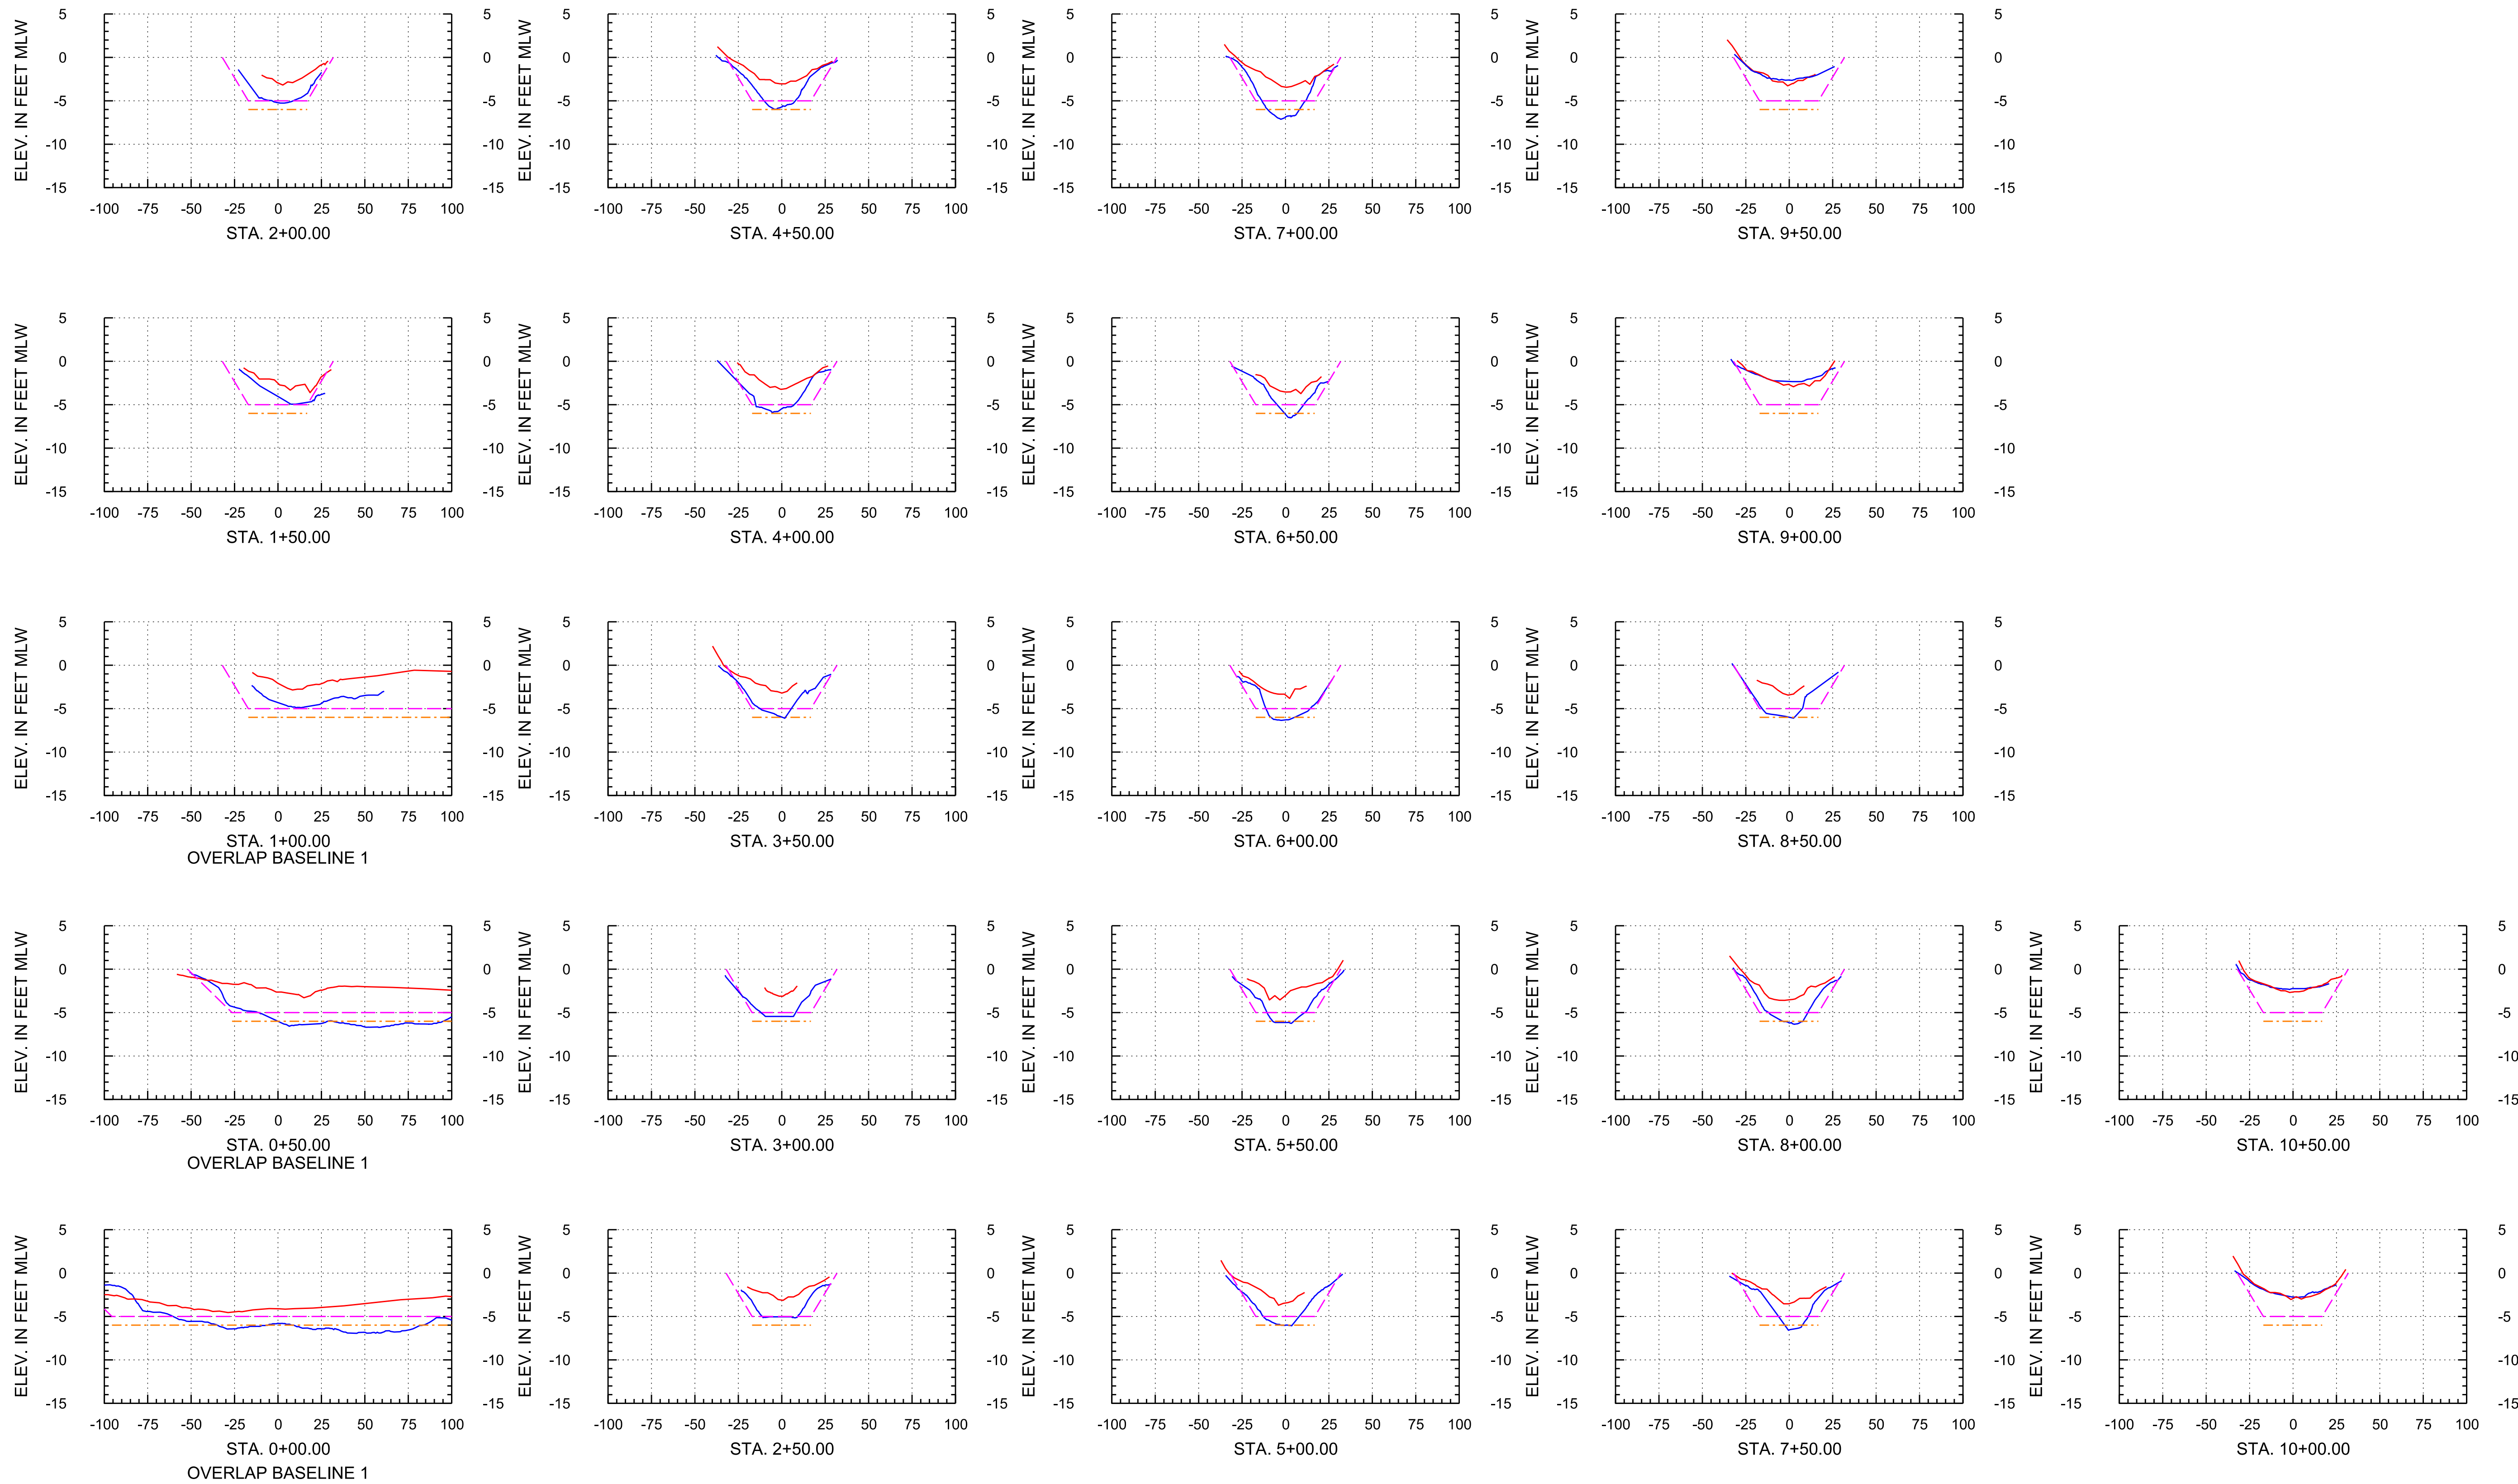

Arc Surveying & Mapping, Inc.
Professional Hydrographers • Surveyors • Mappers
5202 San Juan Avenue
Jacksonville, Florida 32210
904.384.8377

Prepared For:
Isle of Palms Special District
501 Riverside Avenue
Jacksonville, FL 32202

Project Title:
Isle of Palms North
Hydrographic After-Dredge #4 Survey

— = ARC SURVEY HYDROGRAPHIC SURVEY AUGUST 10, 2021
— = ARC SURVEY HYDROGRAPHIC SURVEY JUNE 23-JULY 6, 2020




MLW = MEAN LOW WATER
STA. = STATION

— = TEMPLATE AT -5' MLW (REVISED PER CLIENT)
— = TEMPLATE AT -6' MLW (REVISED PER CLIENT)

DATE	BY	REVISION

LB No. 6487
Drawn By: D. Trabis
Scale: see map
Plot Date: 08/16/21
File Name:
Fld Bk / Pg:
ARC Project No.:
2020-0077 AD4
SHEET: 16 OF: 20

ISLE OF PALMS NORTH, SURVEY BASELINE 7

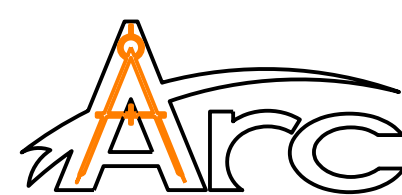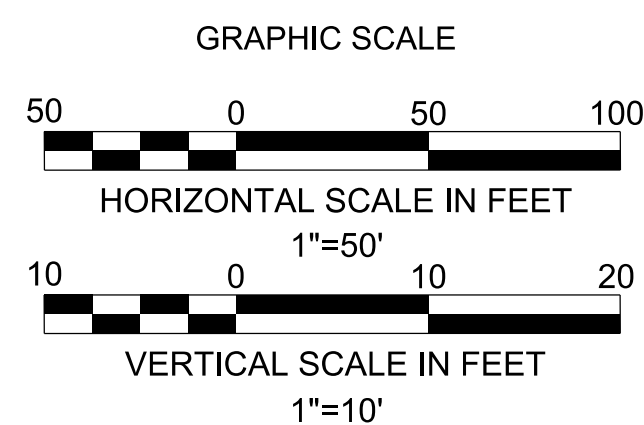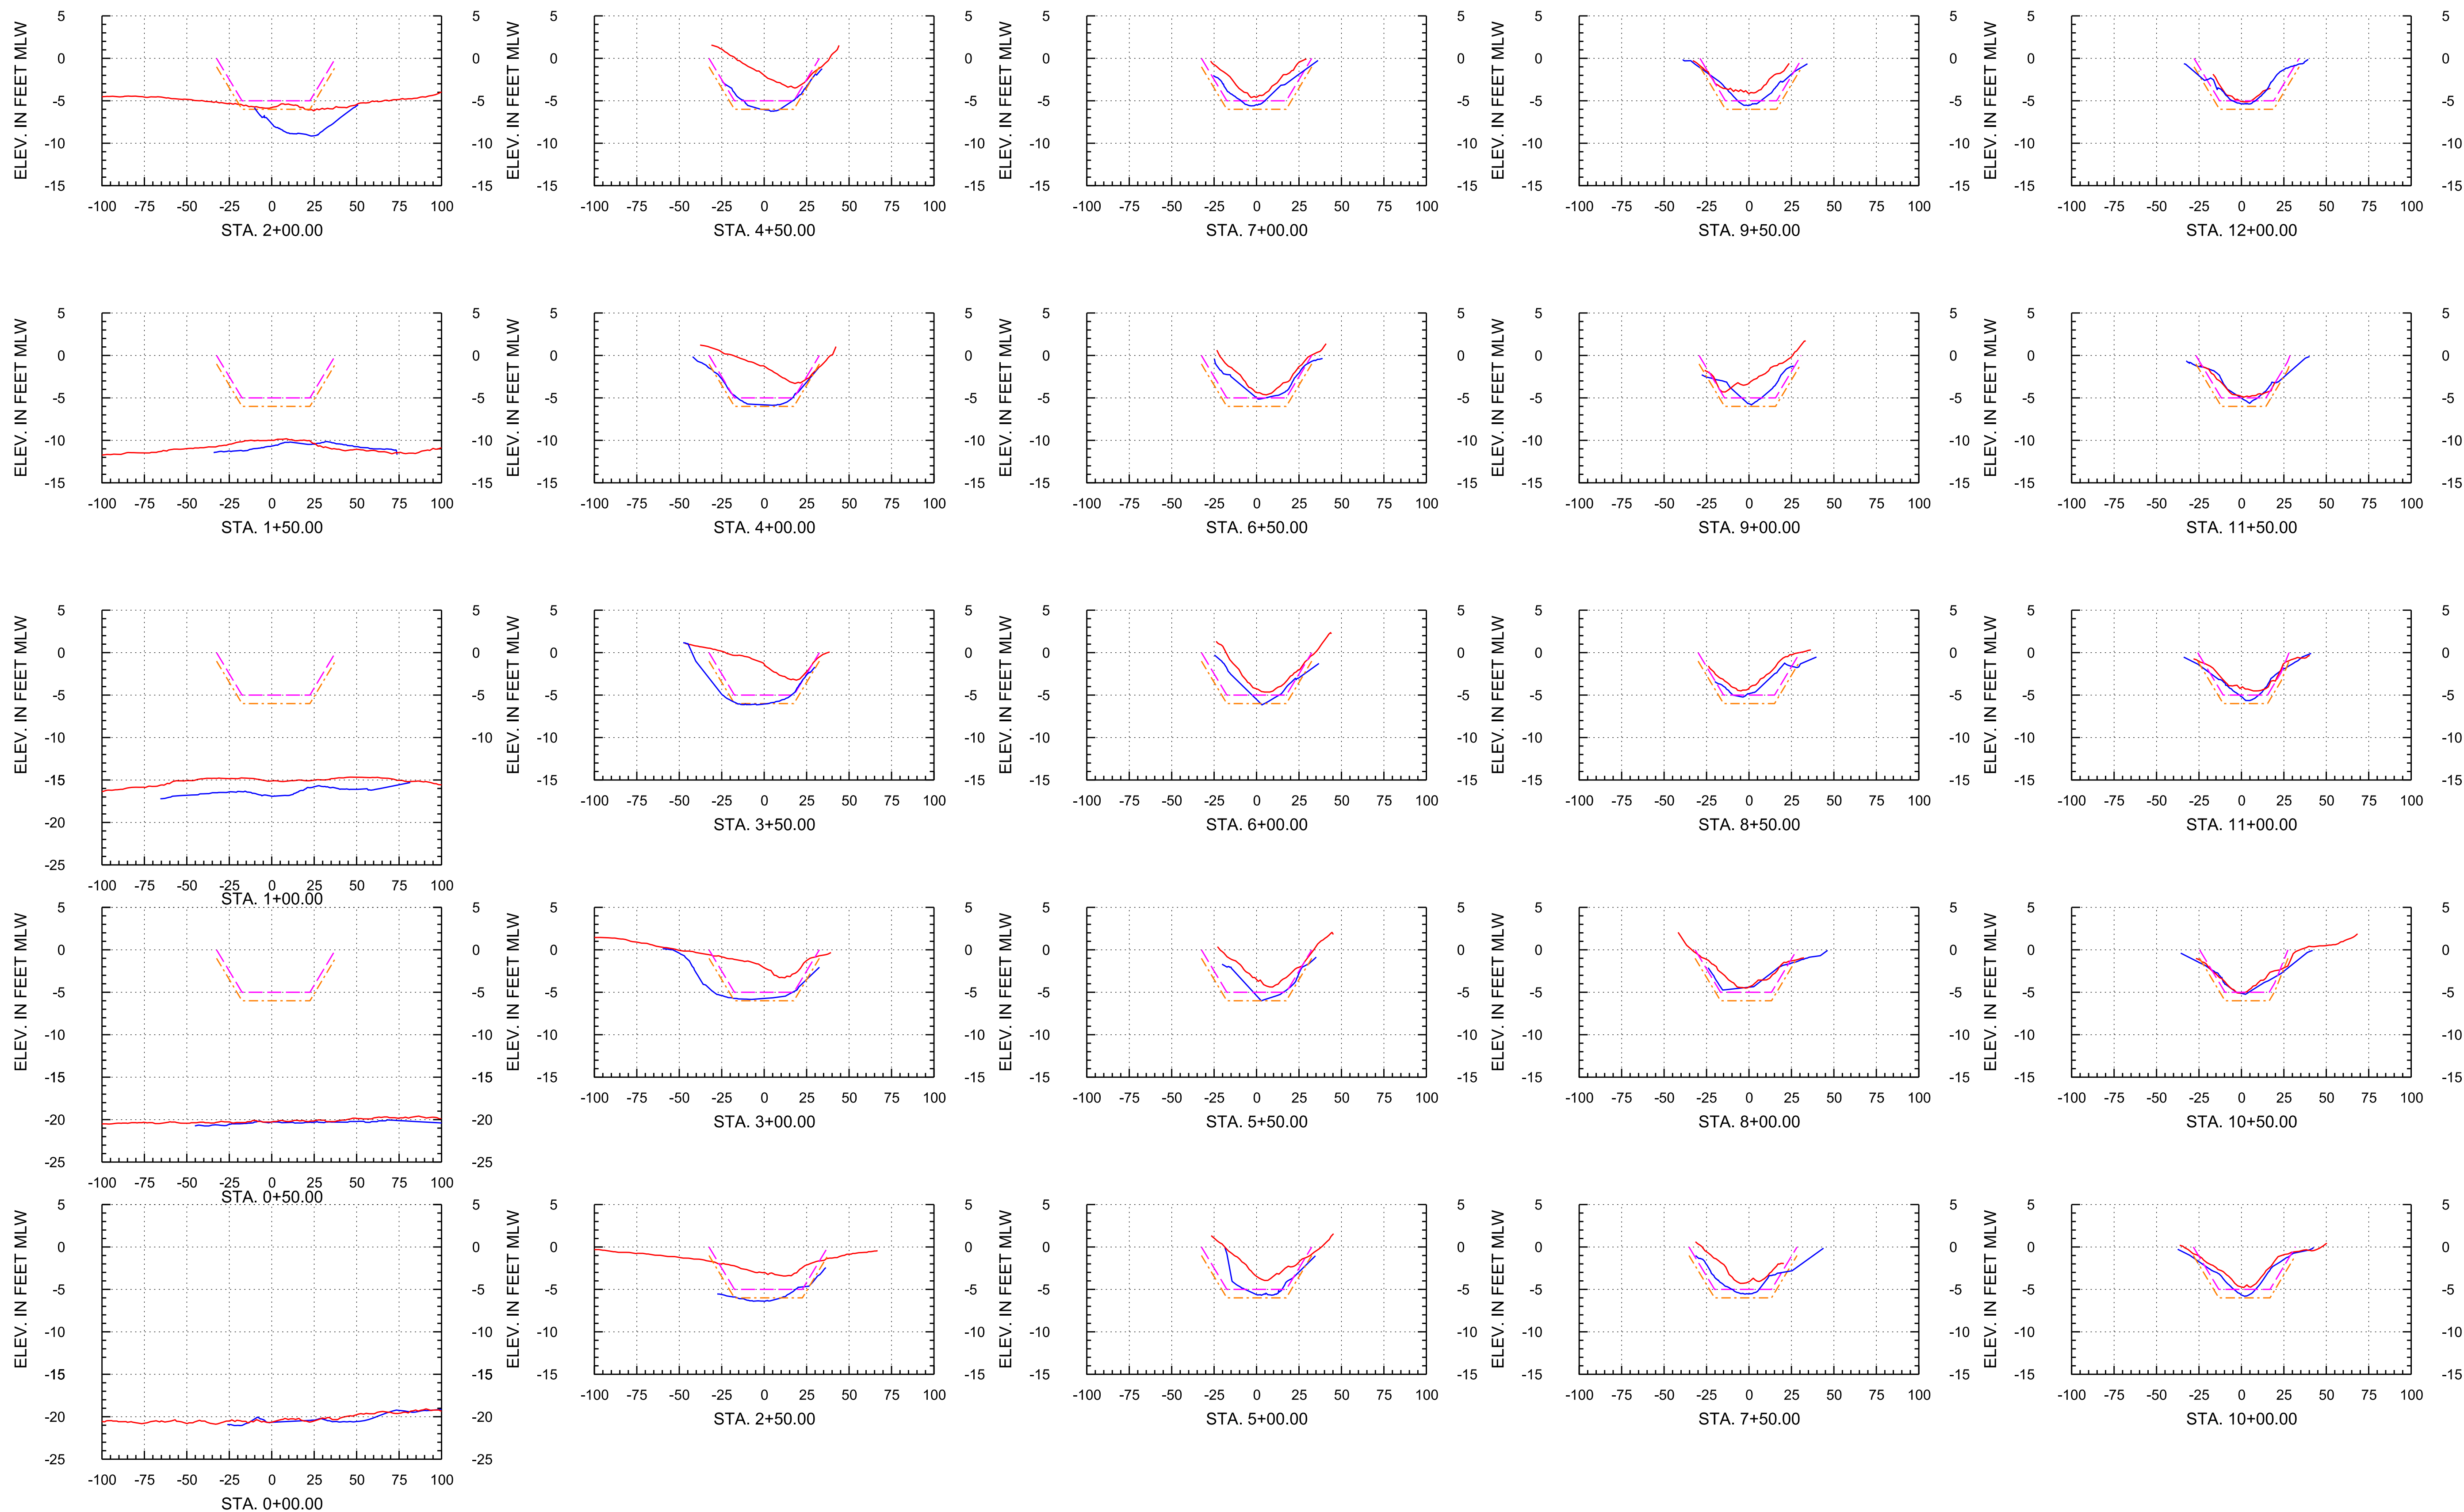

Arc Surveying & Mapping, Inc.
Professional Hydrographers • Surveyors • Mappers
5202 San Juan Avenue
Jacksonville, Florida 32210
904.384.8377

Prepared For:
Isle of Palms Special District
501 Riverside Avenue
Jacksonville, FL 32202

Project Title:
**Isle of Palms North
Hydrographic After-Dredge #4 Survey**

— = ARC SURVEY HYDROGRAPHIC SURVEY AUGUST 10, 2021
— = ARC SURVEY HYDROGRAPHIC SURVEY JUNE 23-JULY 6, 2020



MLW = MEAN LOW WATER
STA. = STATION

— = TEMPLATE AT -5' MLW (REVISED PER CLIENT)
— = TEMPLATE AT -6' MLW (REVISED PER CLIENT)

DATE	BY	REVISION

LB No. 6487
Drawn By: D. Trubits
Scale: see map
Plot Date: 08/16/21
File Name:
Fld Bk / Pg:
ARC Project No.:
2020-0077 AD4
SHEET: 17 OF: 20

ISLE OF PALMS NORTH, SURVEY BASELINE 7

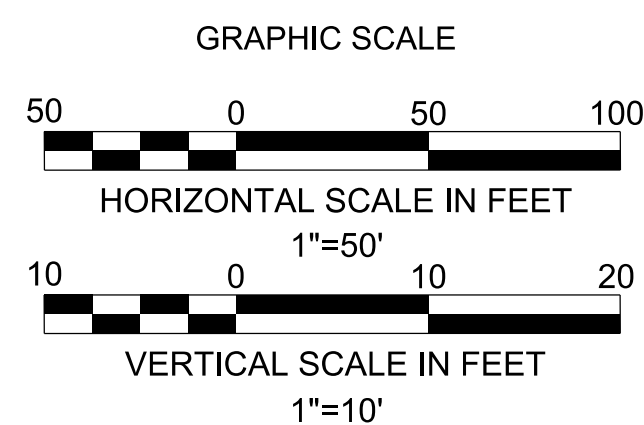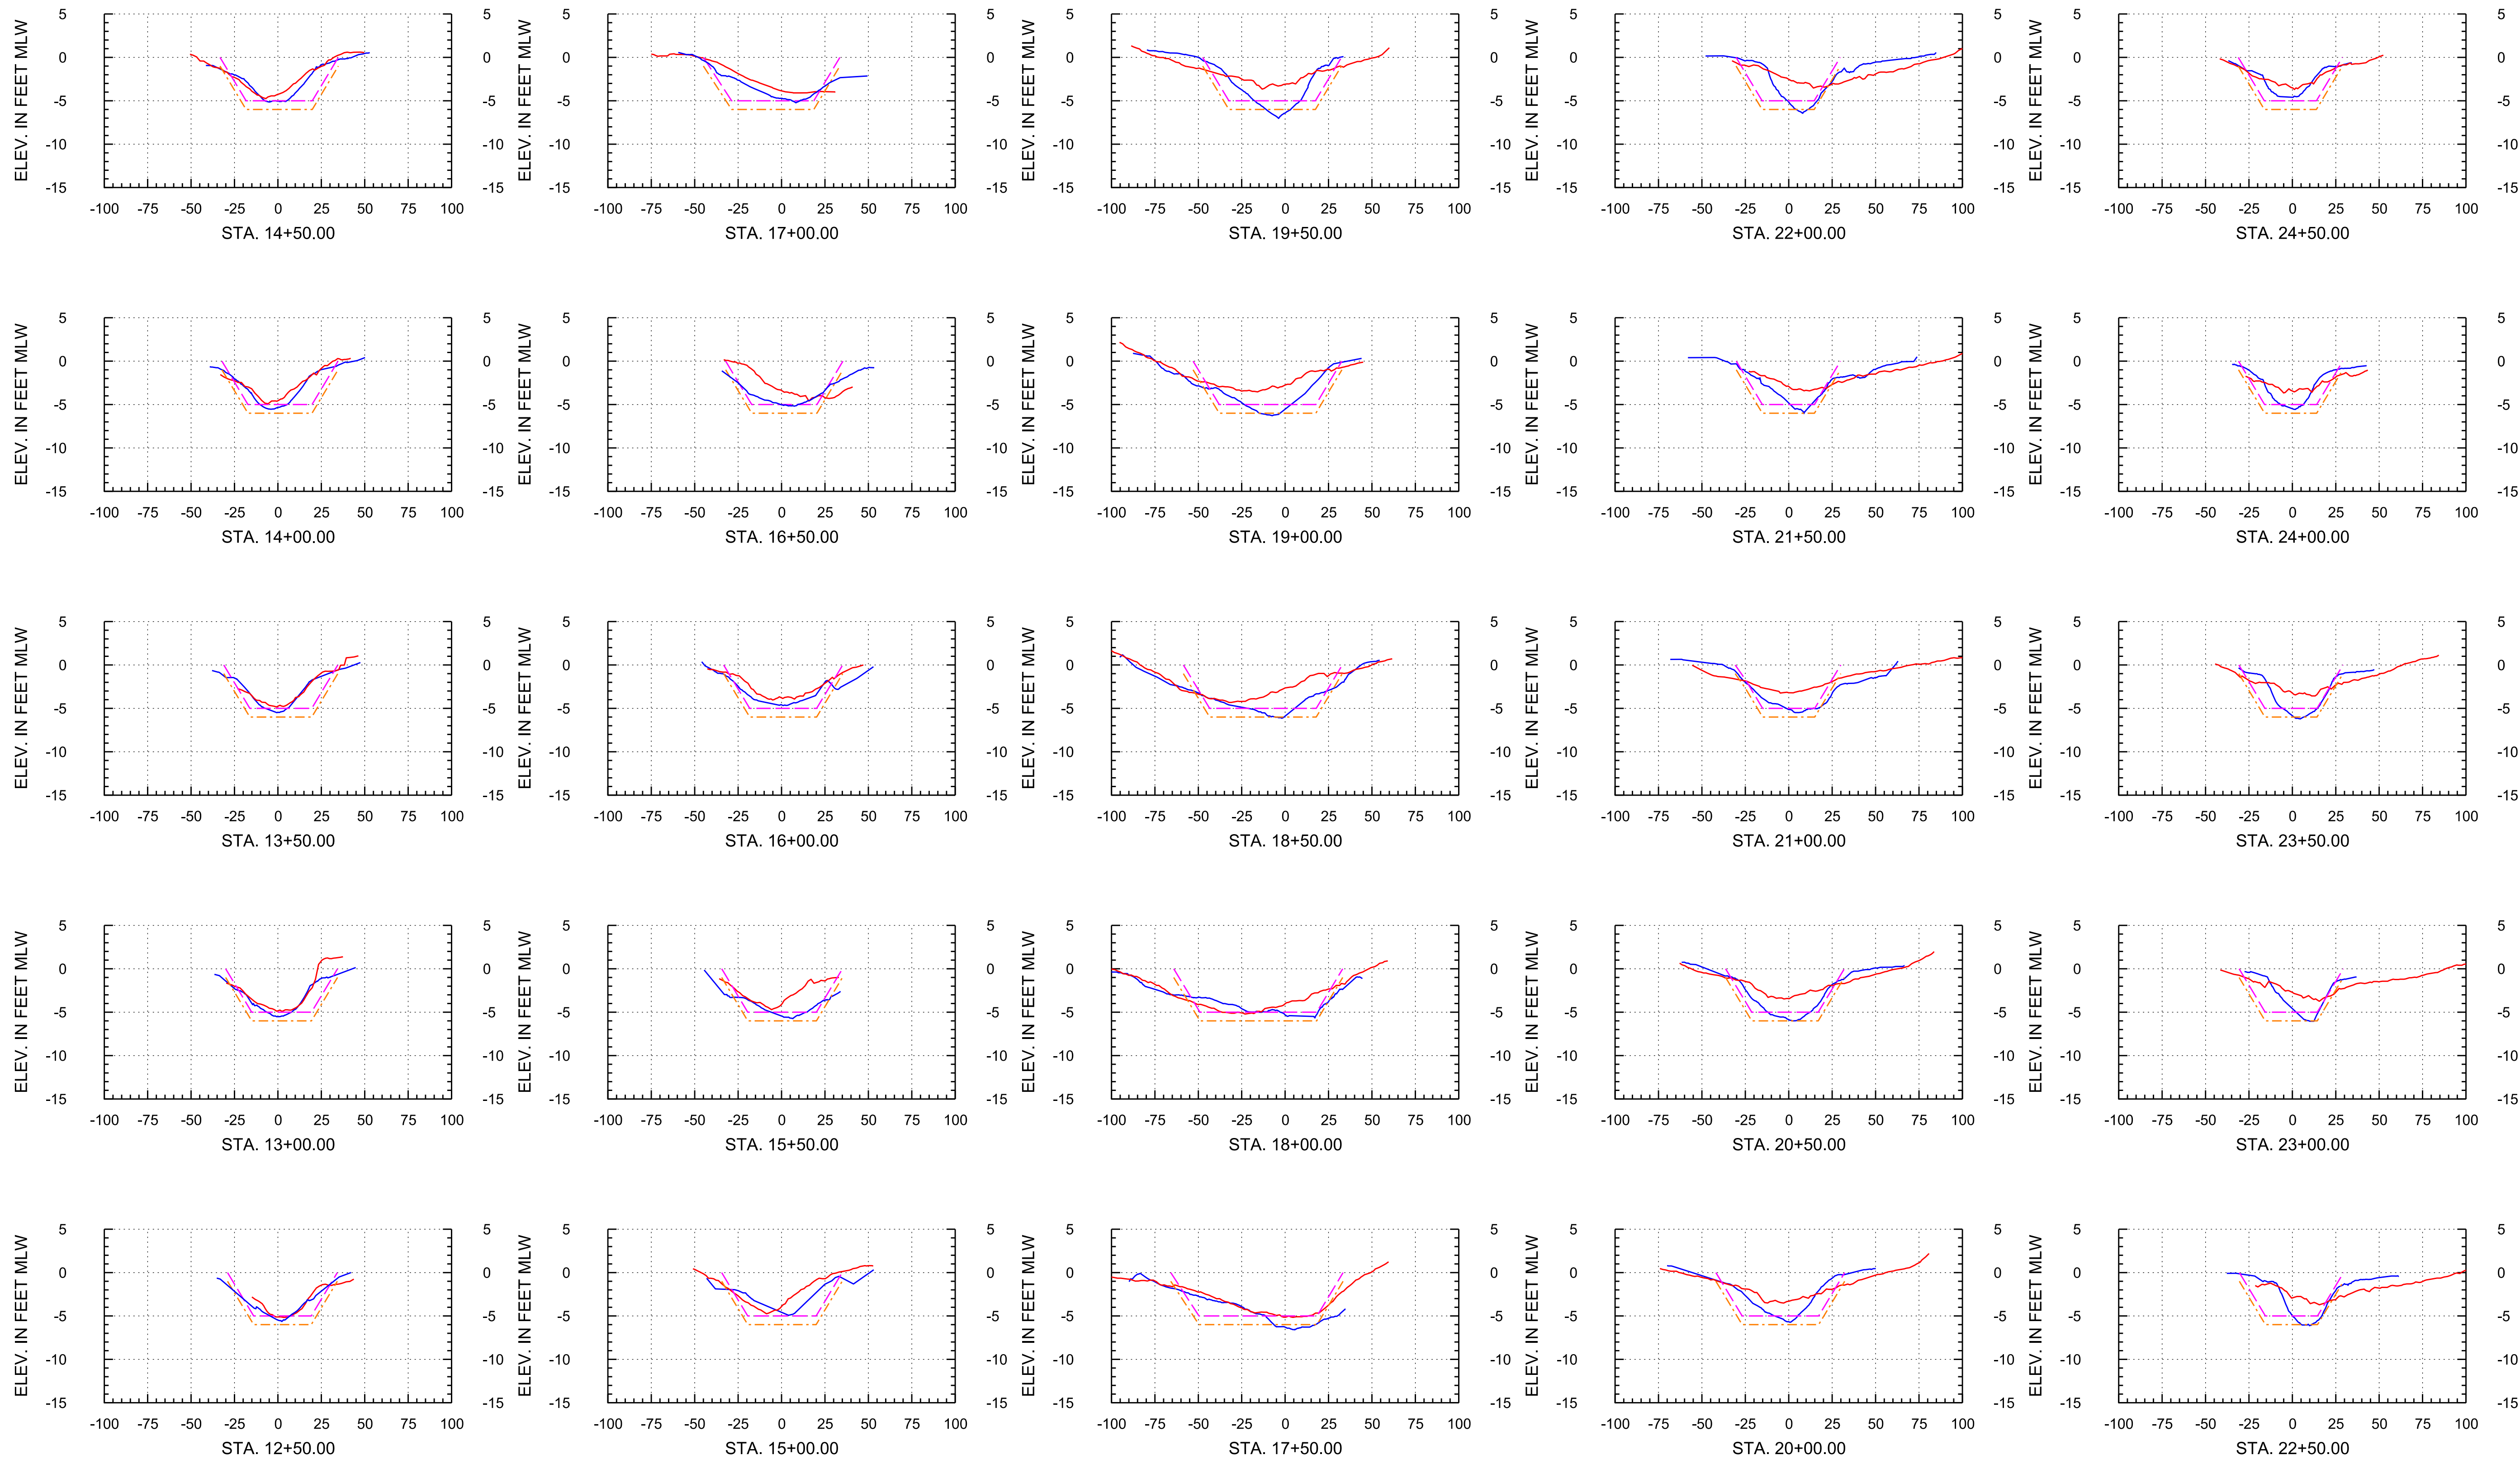

Arc Surveying & Mapping, Inc.
Professional Hydrographers • Surveyors • Mappers
5202 San Juan Avenue
Jacksonville, Florida 32210
904.384.8377

Prepared For:
Isle of Palms Special District
501 Riverside Avenue
Jacksonville, FL 32202

Project Title:
Isle of Palms North
Hydrographic After-Dredge #4 Survey

— = ARC SURVEY HYDROGRAPHIC SURVEY AUGUST 10, 2021
— = ARC SURVEY HYDROGRAPHIC SURVEY JUNE 23-JULY 6, 2020



MLW = MEAN LOW WATER
STA. = STATION

--- = TEMPLATE AT -5' MLW (REVISED PER CLIENT)
--- = TEMPLATE AT -6' MLW (REVISED PER CLIENT)

DATE	BY	REVISION

LB No. 6487
Drawn By: D. Trabits
Scale: see map
Plot Date: 08/16/21
File Name:
Fld Bk / Pg:
ARC Project No.:
2020-0077 AD4
SHEET: 18 OF: 20

ISLE OF PALMS NORTH, SURVEY BASELINE 7

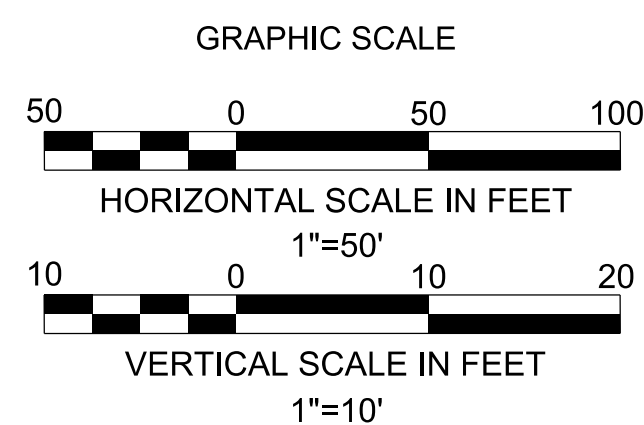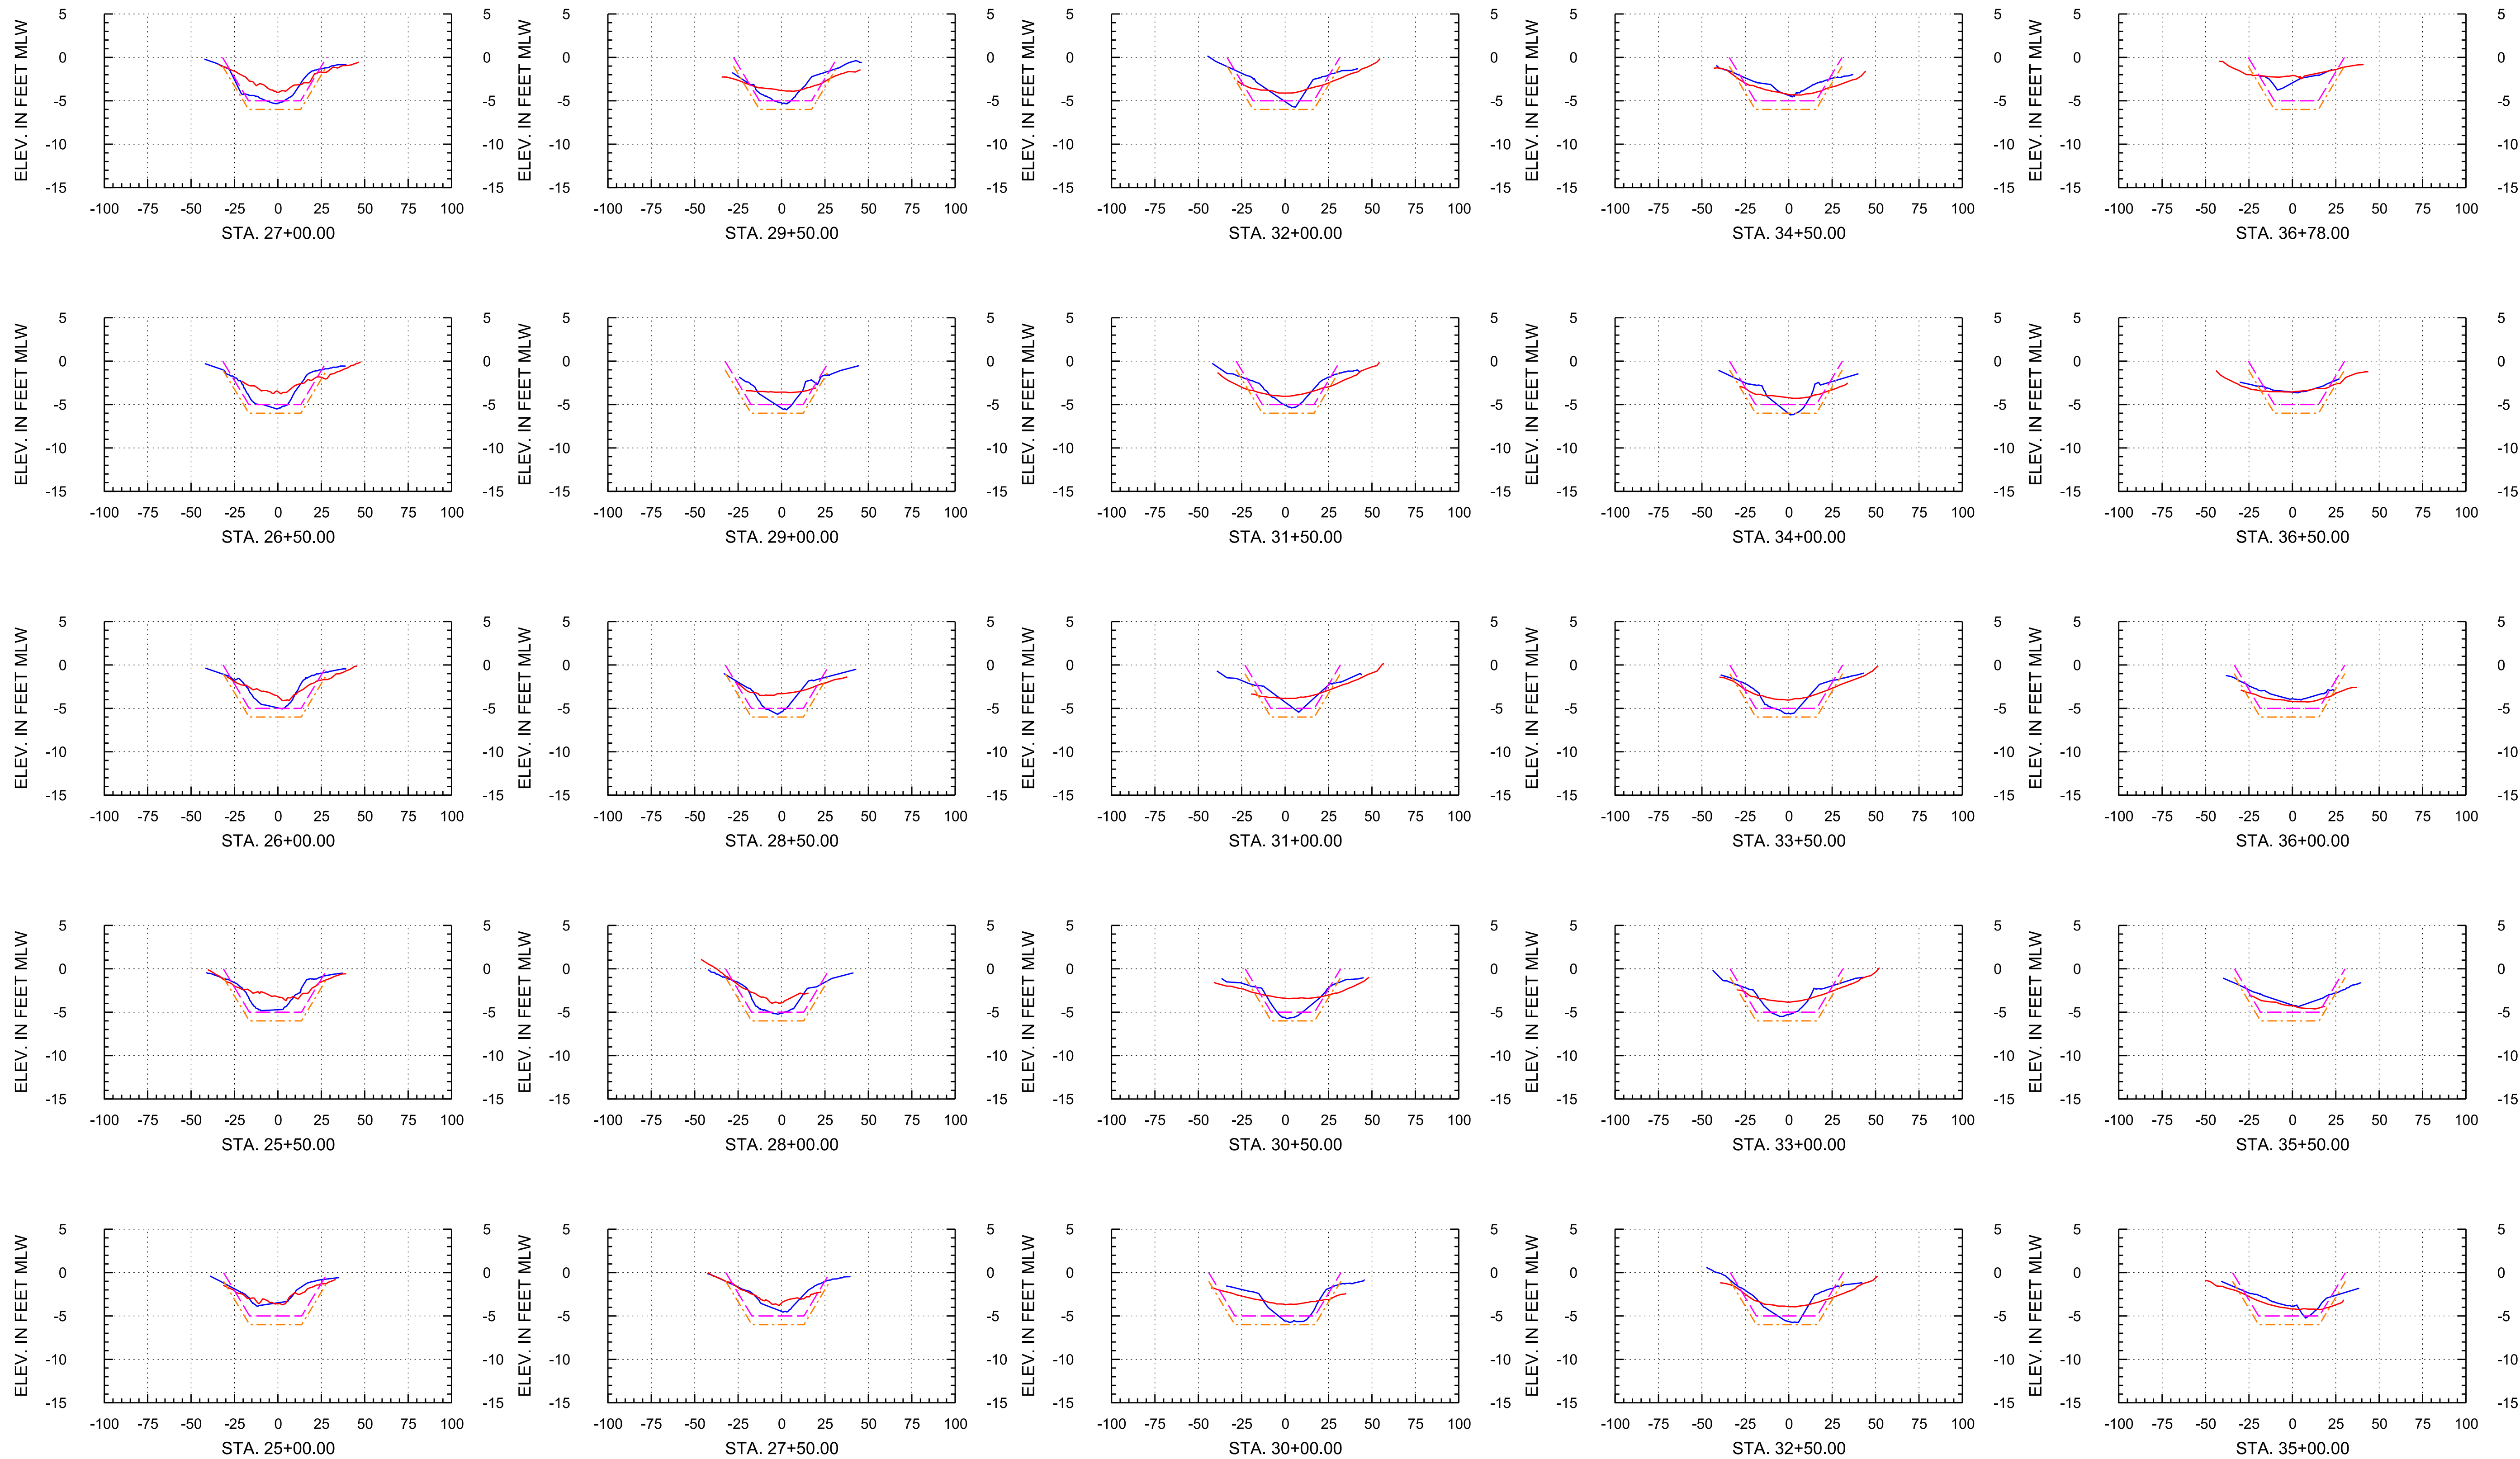

Arc Surveying & Mapping, Inc.
Professional Hydrographers • Surveyors • Mappers
5202 San Juan Avenue
Jacksonville, Florida 32210
904.384.8377

Prepared For:
Isle of Palms Special District
501 Riverside Avenue
Jacksonville, FL 32202

Project Title:
Isle of Palms North
Hydrographic After-Dredge #4 Survey

— = ARC SURVEY HYDROGRAPHIC SURVEY AUGUST 10, 2021
— = ARC SURVEY HYDROGRAPHIC SURVEY JUNE 23-JULY 6, 2020








MLW = MEAN LOW WATER
STA. = STATION

— = TEMPLATE AT -5' MLW (REVISED PER CLIENT)
— = TEMPLATE AT -6' MLW (REVISED PER CLIENT)

DATE	BY	REVISION

LB No. 6487
Drawn By: D. Trubits
Scale: see map
Plot Date: 08/16/21
File Name:
Fld Bk / Pg:
ARC Project No.:
2020-0077 AD4
SHEET: 19 OF: 20

ISLE OF PALMS NORTH, SURVEY BASELINE 8

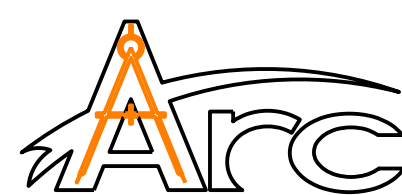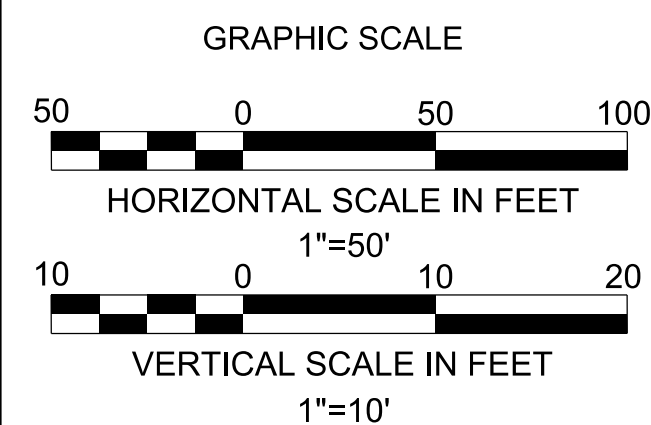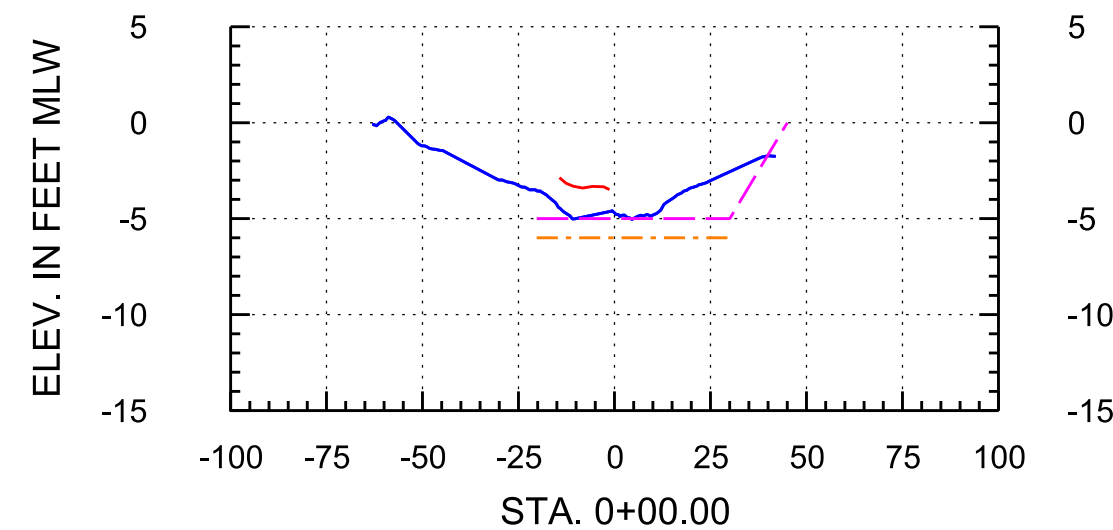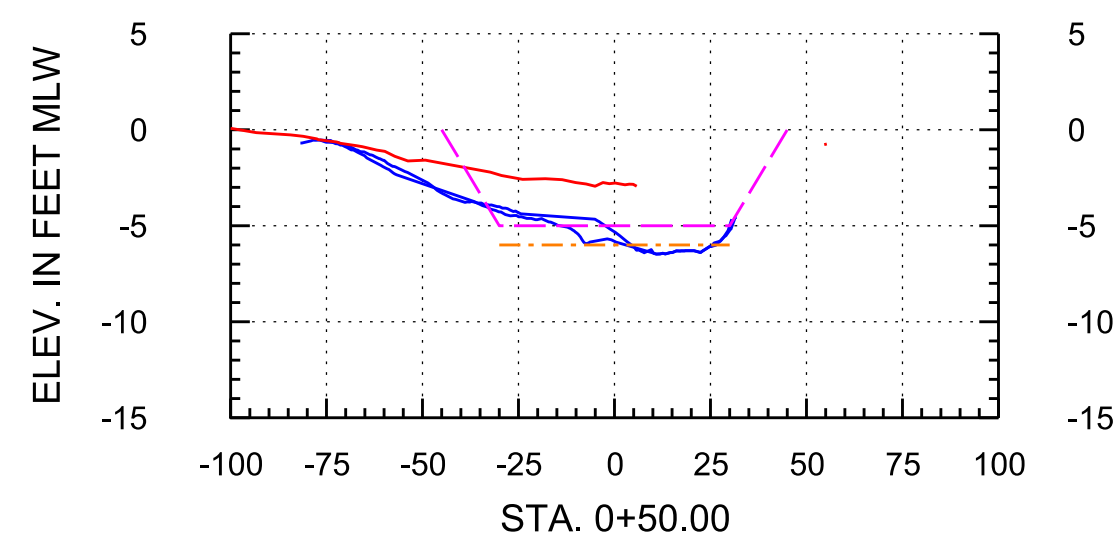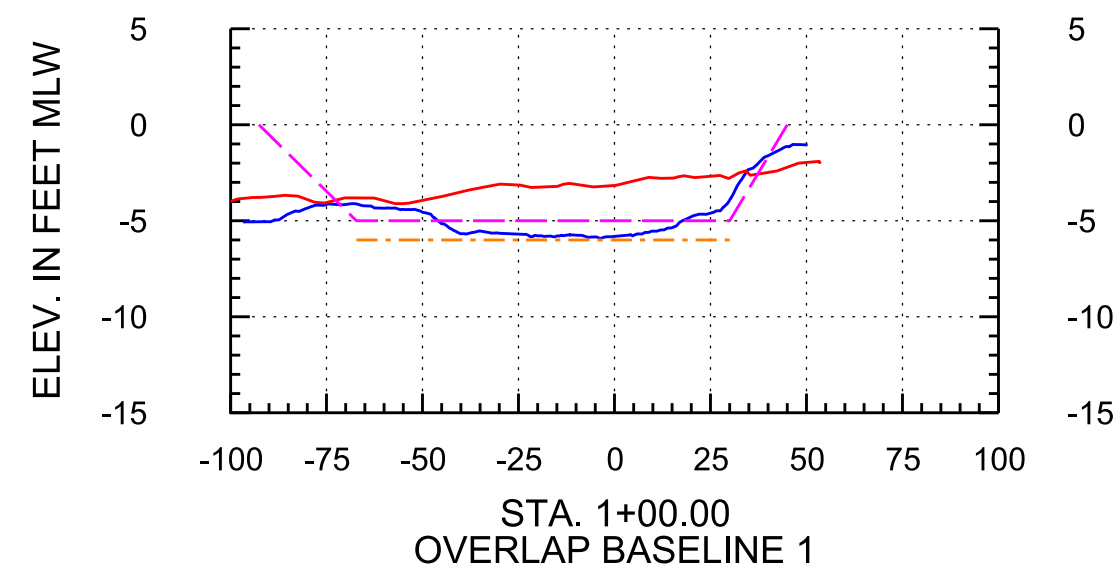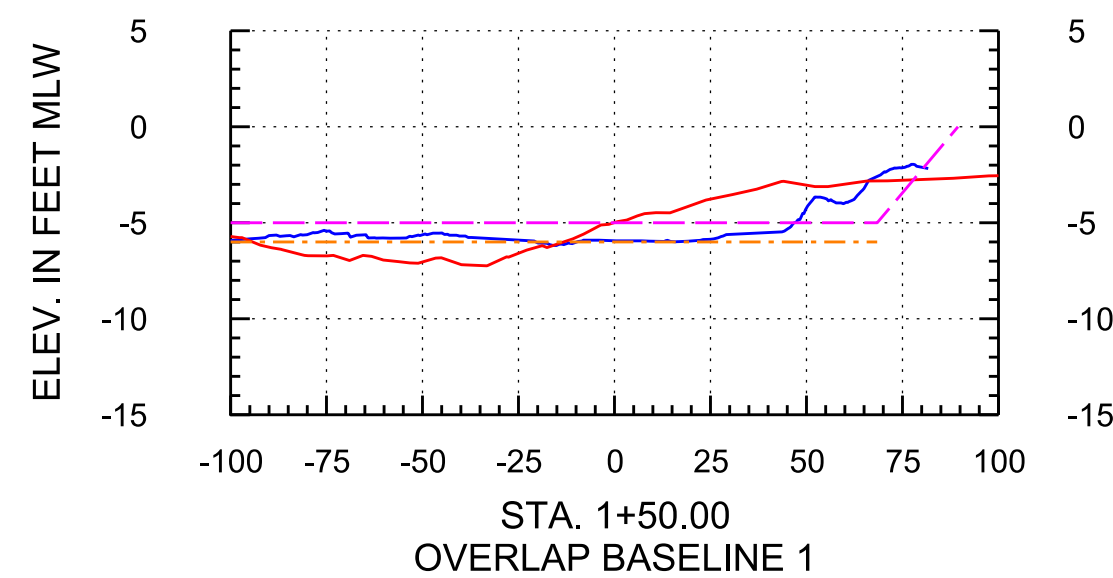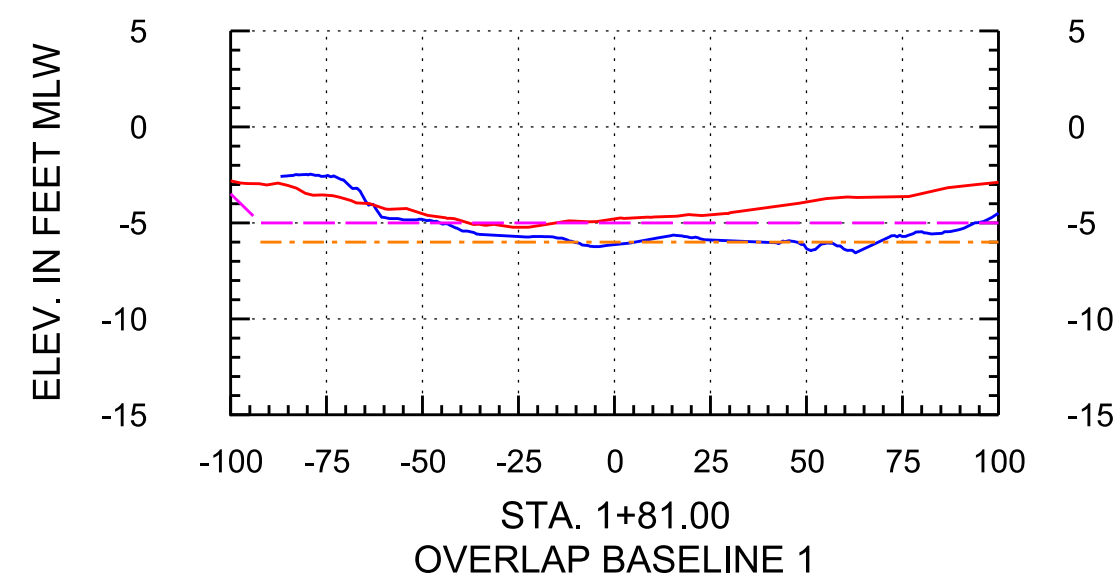

Arc Surveying & Mapping, Inc.
Professional Hydrographers • Surveyors • Mappers
5202 San Juan Avenue
Jacksonville, Florida 32210
904.384.8377

Prepared For:
Isle of Palms Special District
501 Riverside Avenue
Jacksonville, FL 32202

Project Title:
Isle of Palms North
Hydrographic After-Dredge #4 Survey

— = ARC SURVEY HYDROGRAPHIC SURVEY AUGUST 10, 2021
— = ARC SURVEY HYDROGRAPHIC SURVEY JUNE 23-JULY 6, 2020

MLW = MEAN LOW WATER
STA. = STATION

— = TEMPLATE AT -5' MLW (REVISED PER CLIENT)
— = TEMPLATE AT -6' MLW (REVISED PER CLIENT)

DATE	BY	REVISION

LB No. 6487
Drawn By: D. Trubits
Scale: see map
Plot Date: 08/16/21
File Name:
Fld Bk / Pg:
ARC Project No.:
2020-0077 AD4
SHEET: 20 OF: 20