


A MAP SHOWING A HYDROGRAPHIC SURVEY OF  
A PORTION OF ISLE OF PALMS NORTH CANAL SYSTEM  
LOCATED IN DUVAL COUNTY, FLORIDA



LEGEND/ABBREVIATIONS


- = CHANNEL CENTERLINE  
——— = CHANNEL TOE
- MLW = MEAN LOW WATER  
NO. = NUMBER  
P.I. = POINT OF INTERSECTION  
POB = POINT OF BEGINNING  
STA. = STATION  
NAVD 88 = NORTH AMERICAN  
VERTICAL DATUM 1988  
ELEV. = ELEVATION  
CGS = COASTAL GEODETIC SURVEY

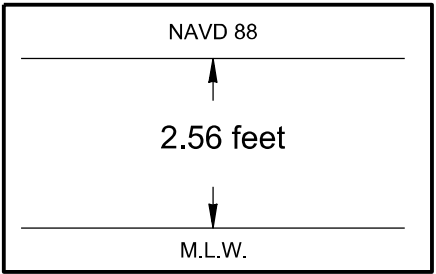

Relationship between NAVD 88  
and Mean Low Water

| BENCHMARKS   | NAVD88<br>ELEV. (FT) | PLANE COORDINATES |              | DESCRIPTION                                   |
|--------------|----------------------|-------------------|--------------|-----------------------------------------------|
|              |                      | X                 | Y            |                                               |
| Y 323        | 15.82                | 528,089.59        | 2,165,028.44 | CGS BRASS DISK IN CONCRETE STAMPED Y 323 1970 |
| PALM NORTH 1 | 4.60                 | 521,064.20        | 2,163,201.96 | SET 1/2" IRON PIPE W/ CAP LB# 6488            |

Richard J. Sawyer  
Professional Surveyor and Mapper No. 6131  
NOT VALID WITHOUT THE SIGNATURE AND THE ORIGINAL RAISED  
SEAL OF A FLORIDA LICENSED SURVEYOR AND MAPPER


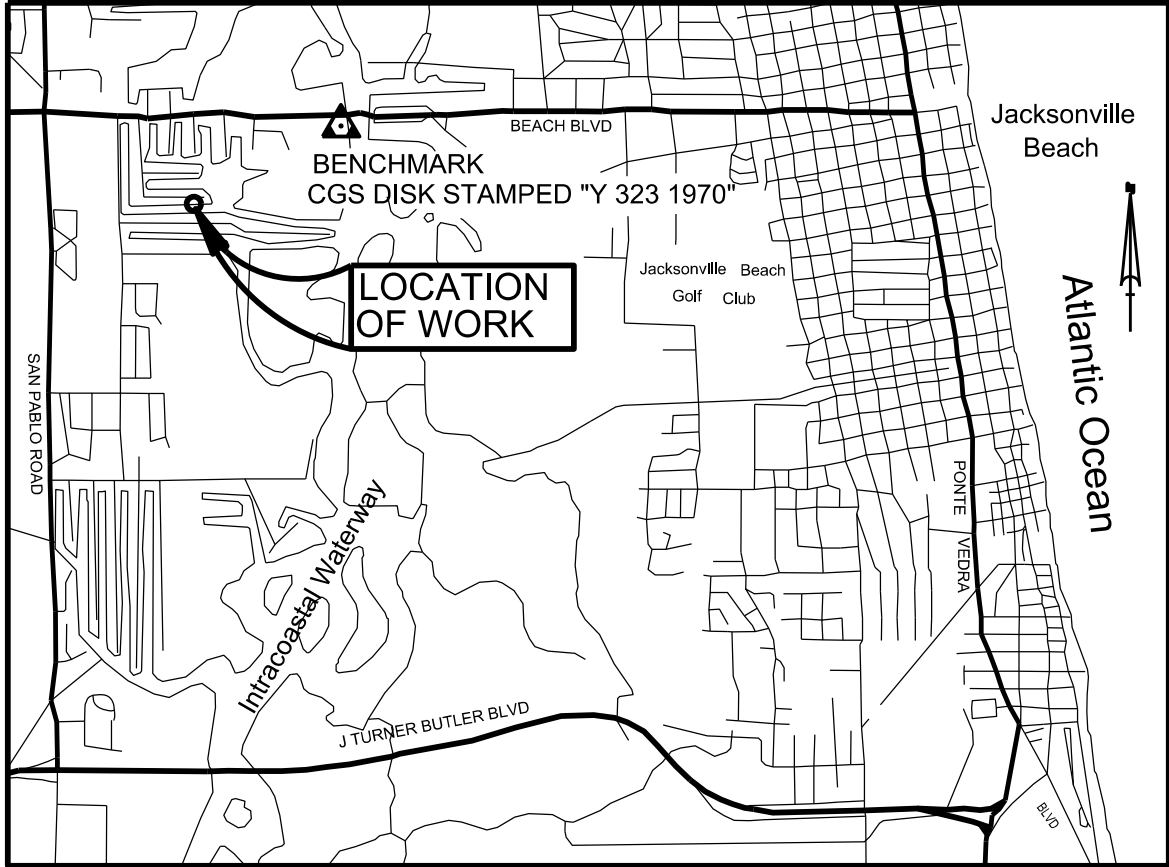


VICINITY MAP  
NOT TO SCALE

SURVEY NOTES:

- HORIZONTAL DATUM: NORTH AMERICAN DATUM OF 1983/88, STATE PLANE COORDINATES, FLORIDA EAST ZONE.
  - VERTICAL DATUM: MEAN LOW WATER (MLW). SOUNDINGS ARE IN FEET AND TENTHS. MLW DATUM OBTAINED FROM LABINS POINT IDENTIFICATION NUMBER 3723.
  - UNITS: U.S SURVEY FEET.
  - CONTOUR INTERVAL: 1 FOOT.
  - THIS HYDROGRAPHIC SURVEY WAS PERFORMED UTILIZING DIFFERENTIAL GPS (DGPS) SURVEYING METHODS FOR HORIZONTAL POSITIONING.
  - SOUNDINGS WERE COLLECTED USING AN ODOM CV-100 SINGLE BEAM SONAR. DATA PROCESSING WAS COMPLETED USING HYPACK HYSWEEP SOFTWARE.
  - THE INFORMATION DEPICTED ON THIS MAP REPRESENTS THE RESULTS OF A SURVEY PERFORMED ON THE INDICATED DATES BELOW AND CAN ONLY BE CONSIDERED AS INDICATING THE GENERAL CONDITIONS AT THAT TIME.
- | VESSEL   | DATE OF SURVEY | LOCATION      |
|----------|----------------|---------------|
| JON BOAT | MARCH 15-29    | BASELINES 1-7 |
- SURVEY QUALITY CONTROL STANDARDS AND FIELD EQUIPMENT CALIBRATIONS WERE FOLLOWED DURING THIS SURVEY IN ACCORDANCE WITH EM 1110-2-1003 FOR CLASS 1 HYDROGRAPHIC SURVEYS.
  - INTRACOASTAL CHANNEL LIMITS OBTAINED FROM A U.S. ARMY CORPS OF ENGINEERS MAP LABELED "INTRACOASTAL WATERWAY JACKSONVILLE TO MIAMI AND MIAMI TO KEY WEST, PROJECT CONDITION SURVEY 7, 10 & 12-FOOT PROJECT DEPTH" JOB NUMBER 04-021. NO ATTEMPT WAS MADE TO VERIFY INFORMATION. IT IS NOT TO BE USED FOR NAVIGATION.
  - BACKGROUND PHOTOGRAPHY WAS OBTAINED FROM WWW.LABINS.ORG, DATED 2017.
  - SURVEY BASELINES AND TEMPLATE REVISIONS PER CLIENT MARKUPS, JULY 22, 2021

SHEET INDEX

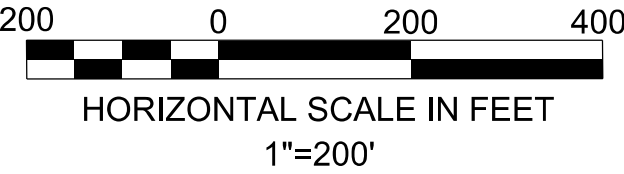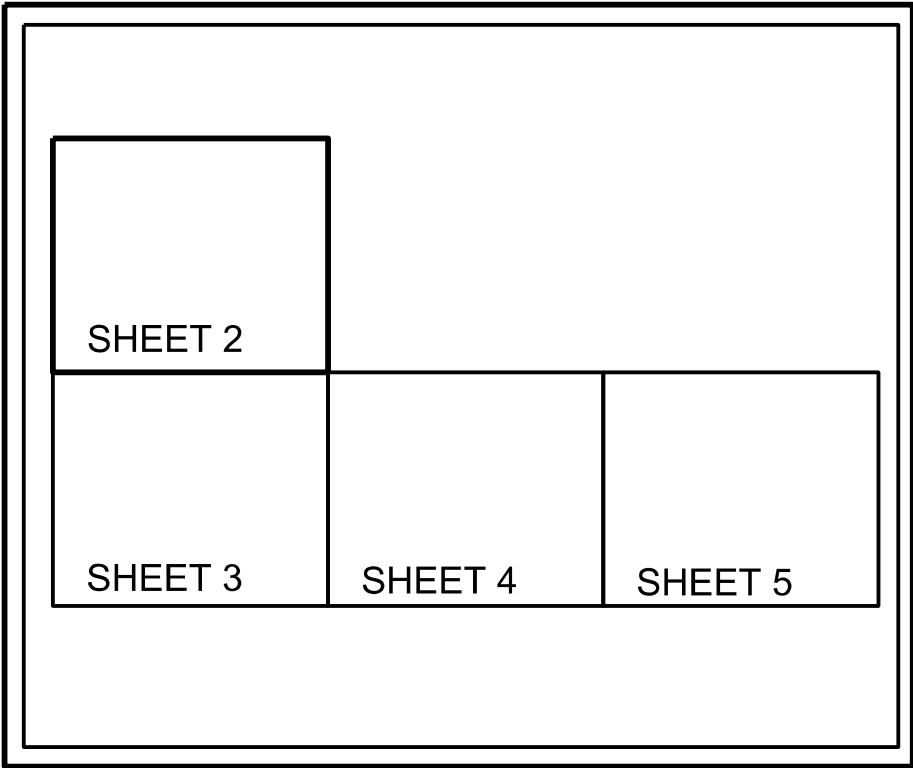

Project Title:


Isle of Palms North  
Hydrographic After-Dredge Survey

Prepared For:

Isle of Palms Special District  
501 Riverside Avenue  
Jacksonville, FL 32202

Arc Surveying & Mapping, Inc.

Professional Hydrographers • Surveyors • Mappers  
5202 San Juan Avenue  
Jacksonville, Florida 32210  
904.394.6377

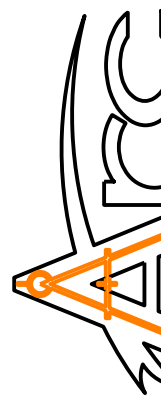

LB No. 6487

Drawn By: D. Trabits

Scale: see map

Plot Date: 04/07/22

File Name:

Fld Bk / Pg:NA

ARC Project No.:

21-272



SHEET: 1 OF: 18

DATE


BY

REVISION



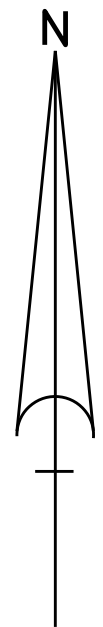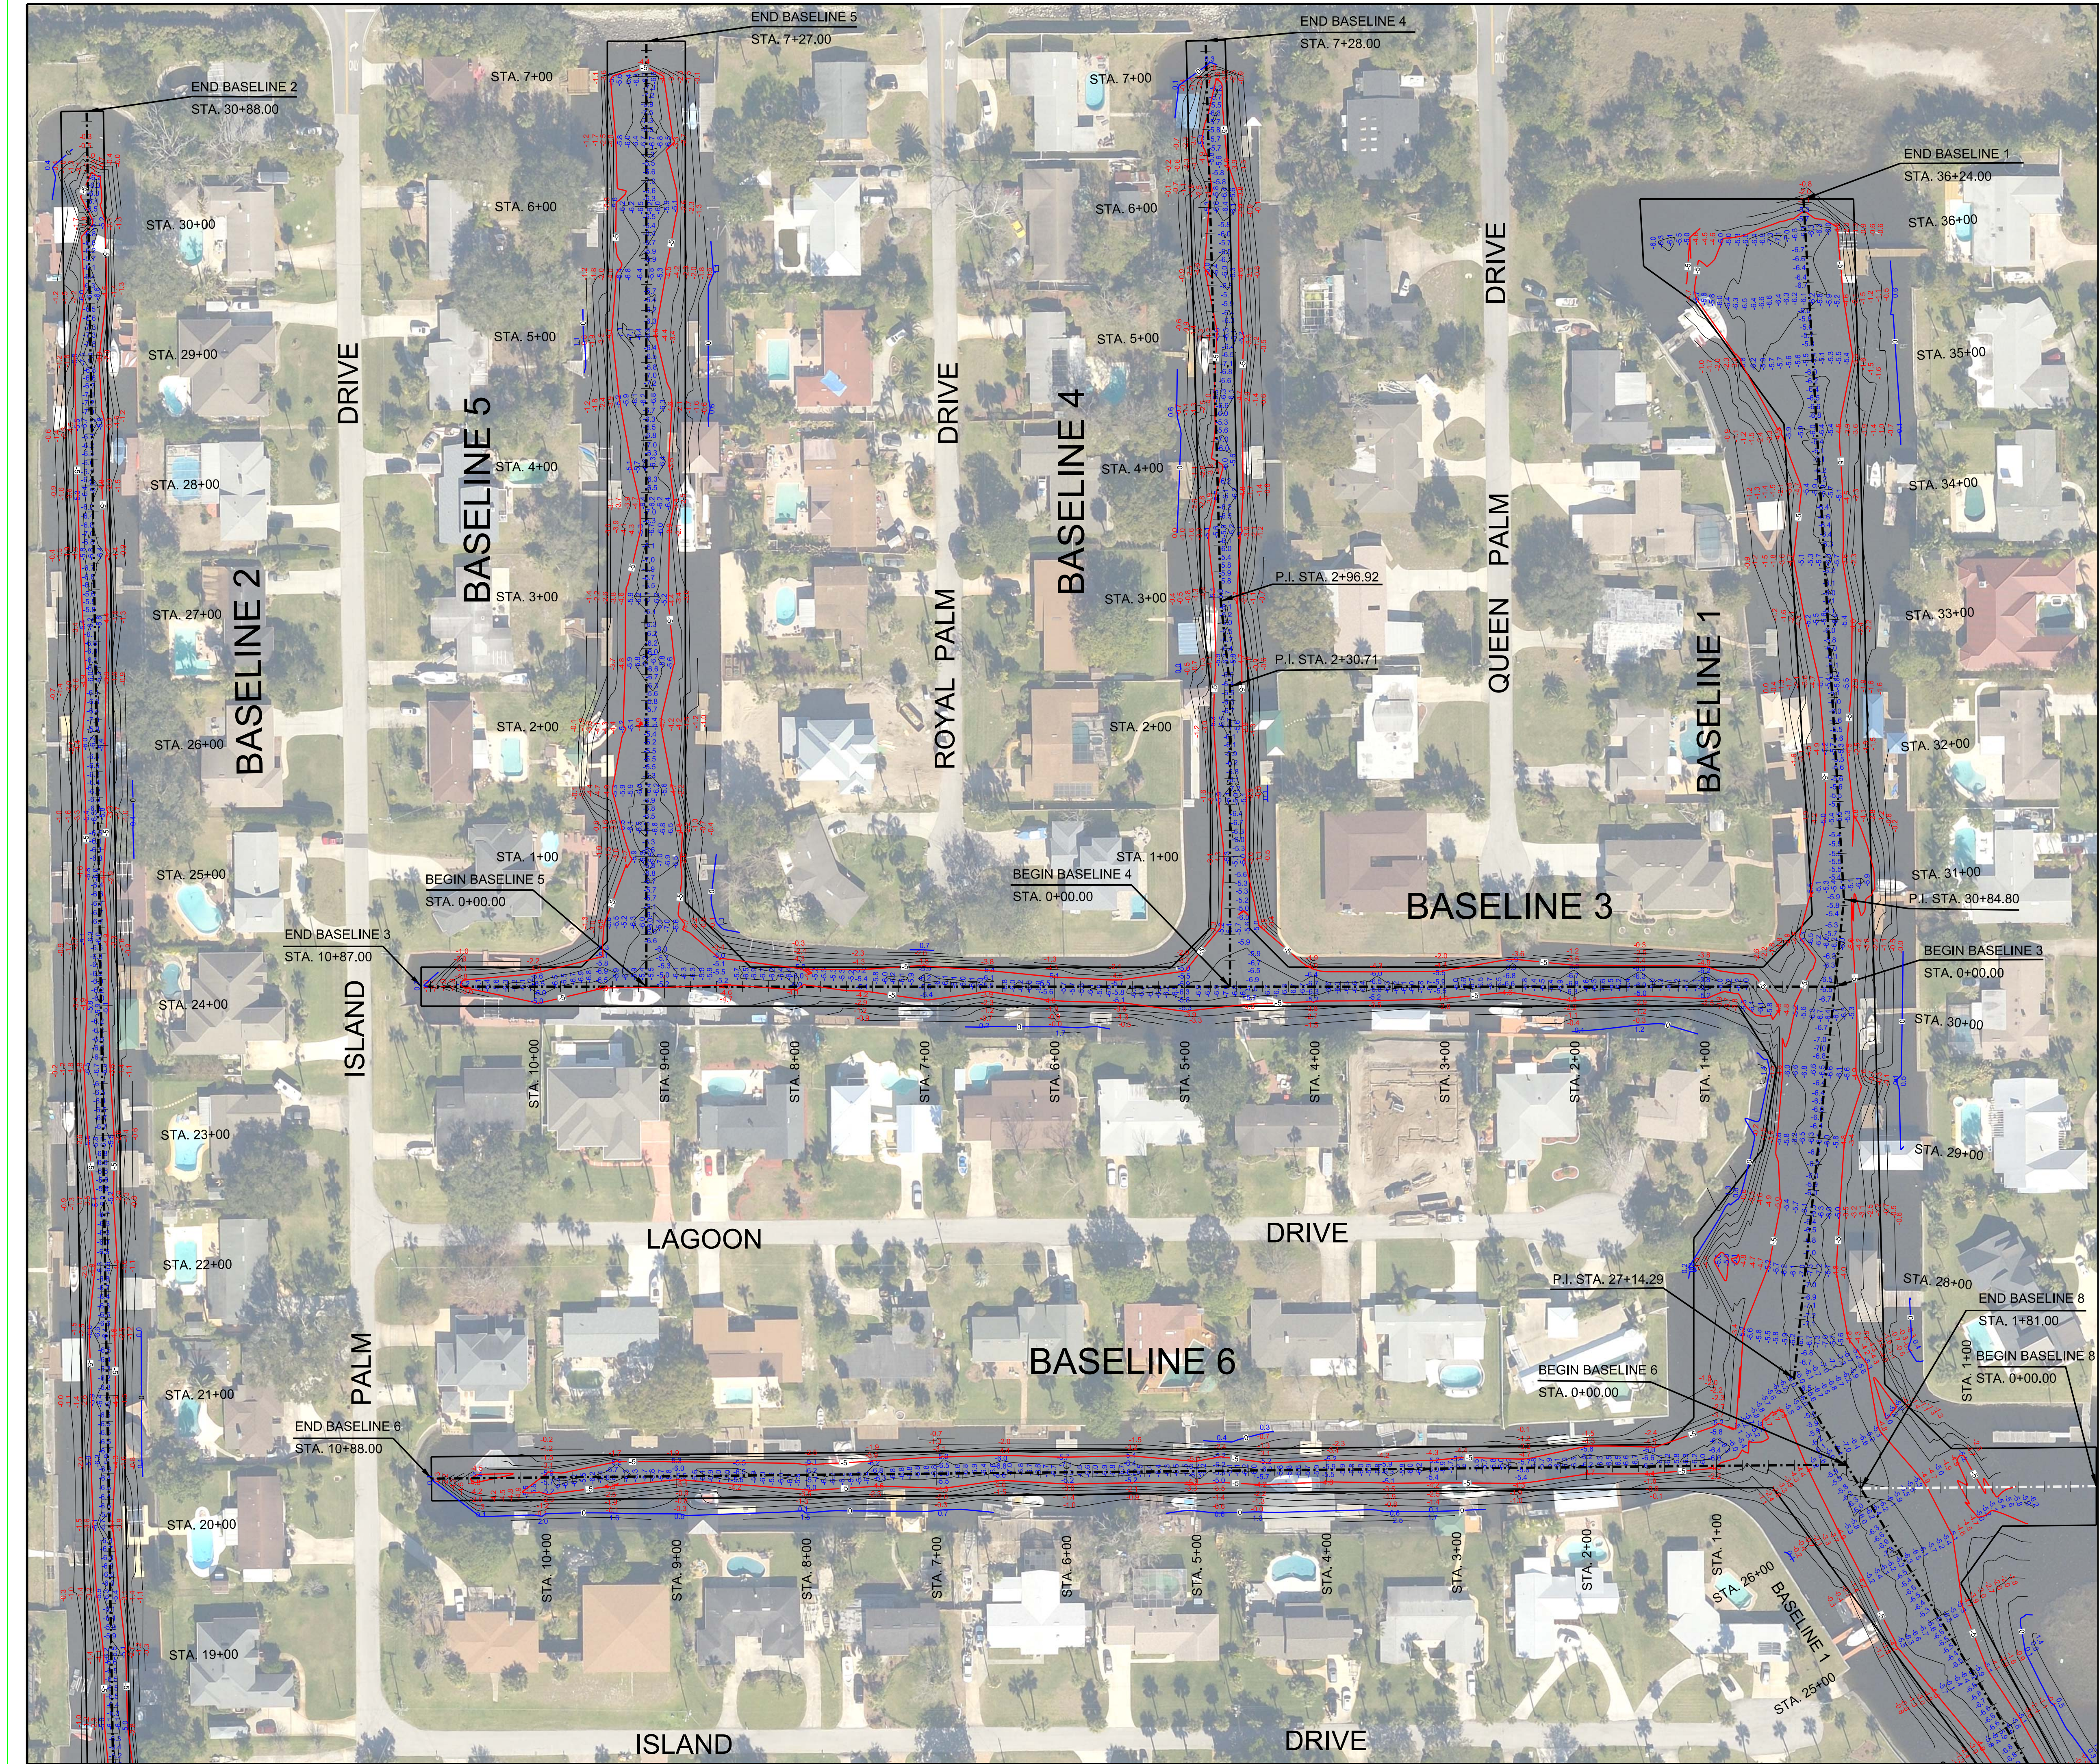


SHEET INDEX

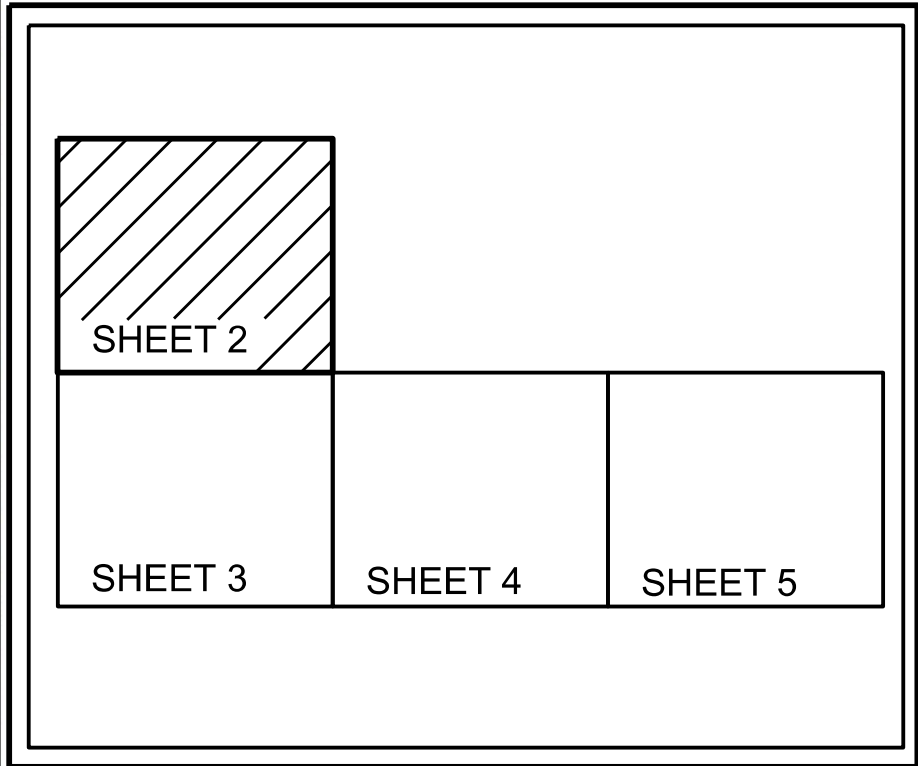

LEGEND/ABBREVIATIONS

- = CHANNEL CENTERLINE
- = CHANNEL TOE
- MLW = MEAN LOW WATER
- NO. = NUMBER
- P.I. = POINT OF INTERSECTION
- POB = POINT OF BEGINNING
- STA. = STATION
- NGVD = NATIONAL GEODETIC VERTICAL DATUM
- ELEV. = ELEVATION

- NOTES:
1. REFER TO SURVEY NO. 21-272
  2. SEE SHEET NO.1 FOR SURVEY NOTES.

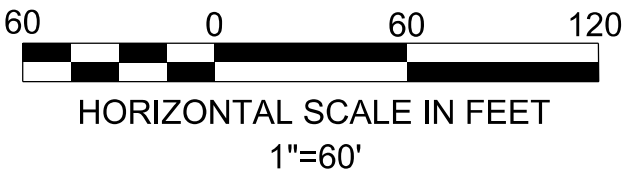


| DATE | BY | REVISION |
|------|----|----------|
|      |    |          |
|      |    |          |
|      |    |          |
|      |    |          |

Project Title:  
Isle of Palms North  
Hydrographic After-Dredge Survey


Prepared For:  
Isle of Palms Special District  
501 Riverside Avenue  
Jacksonville, FL 32202

Arc Surveying & Mapping, Inc.  
Professional Hydrographers • Surveyors • Mappers  
5202 San Juan Avenue  
Florida 32210  
Jacksonville, FL 32210  
904.394.8377

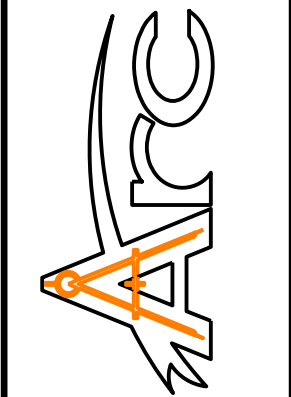


LB No. 6487  
Drawn By: D. Trabits  
Scale: see map  
Plot Date: 04/07/22  
File Name:  
Fld Bk / Pg:NA  
ARC Project No.:  
21-272  
SHEET: 2 OF: 18



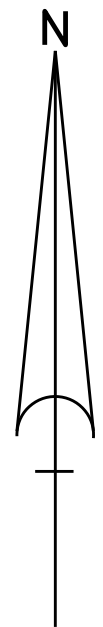


SHEET INDEX

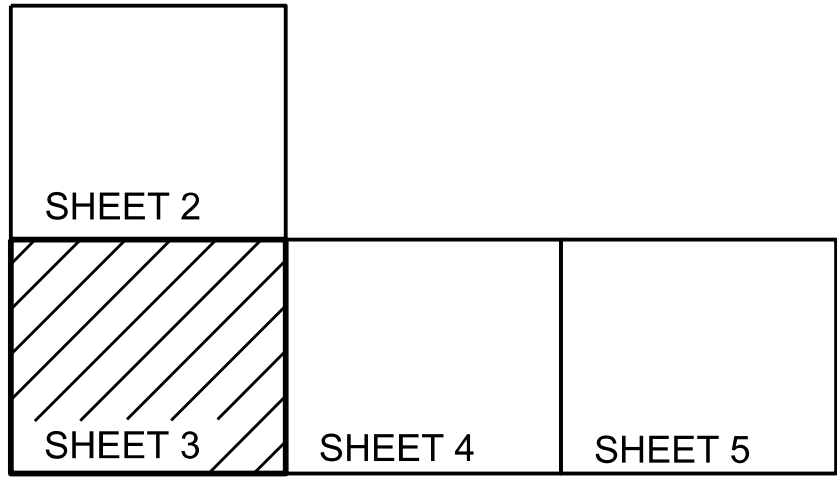

LEGEND/ABBREVIATIONS

- = CHANNEL CENTERLINE
- = CHANNEL TOE
- MLW = MEAN LOW WATER
- NO. = NUMBER
- P.I. = POINT OF INTERSECTION
- POB = POINT OF BEGINNING
- STA. = STATION
- NGVD = NATIONAL GEODETIC VERTICAL DATUM
- ELEV. = ELEVATION

- NOTES:
1. REFER TO SURVEY NO. 21-272
  2. SEE SHEET NO.1 FOR SURVEY NOTES.

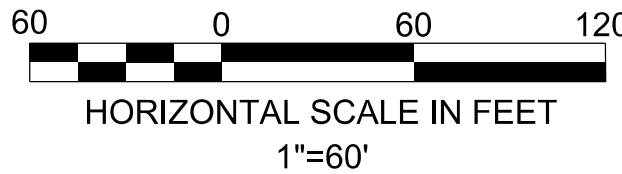

| DATE | BY | REVISION |
|------|----|----------|
|      |    |          |
|      |    |          |
|      |    |          |
|      |    |          |



Project Title:  
Isle of Palms North  
Hydrographic After-Dredge Survey

Prepared For:  
Isle of Palms Special District  
501 Riverside Avenue  
Jacksonville, FL 32202


Arc Surveying & Mapping, Inc.  
Professional Hydrographers • Surveyors • Mappers  
5202 San Juan Avenue  
Jacksonville, Florida 32210  
904.394.8377

LB No. 6487  
Drawn By: D. Trabis  
Scale: see map  
Plot Date: 04/07/22  
File Name:  
Fld Bk / Pg:NA  
ARC Project No.:  
21-272  
SHEET: 3 OF: 18



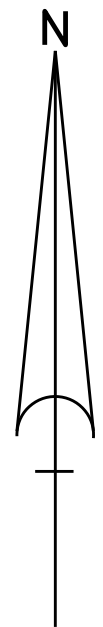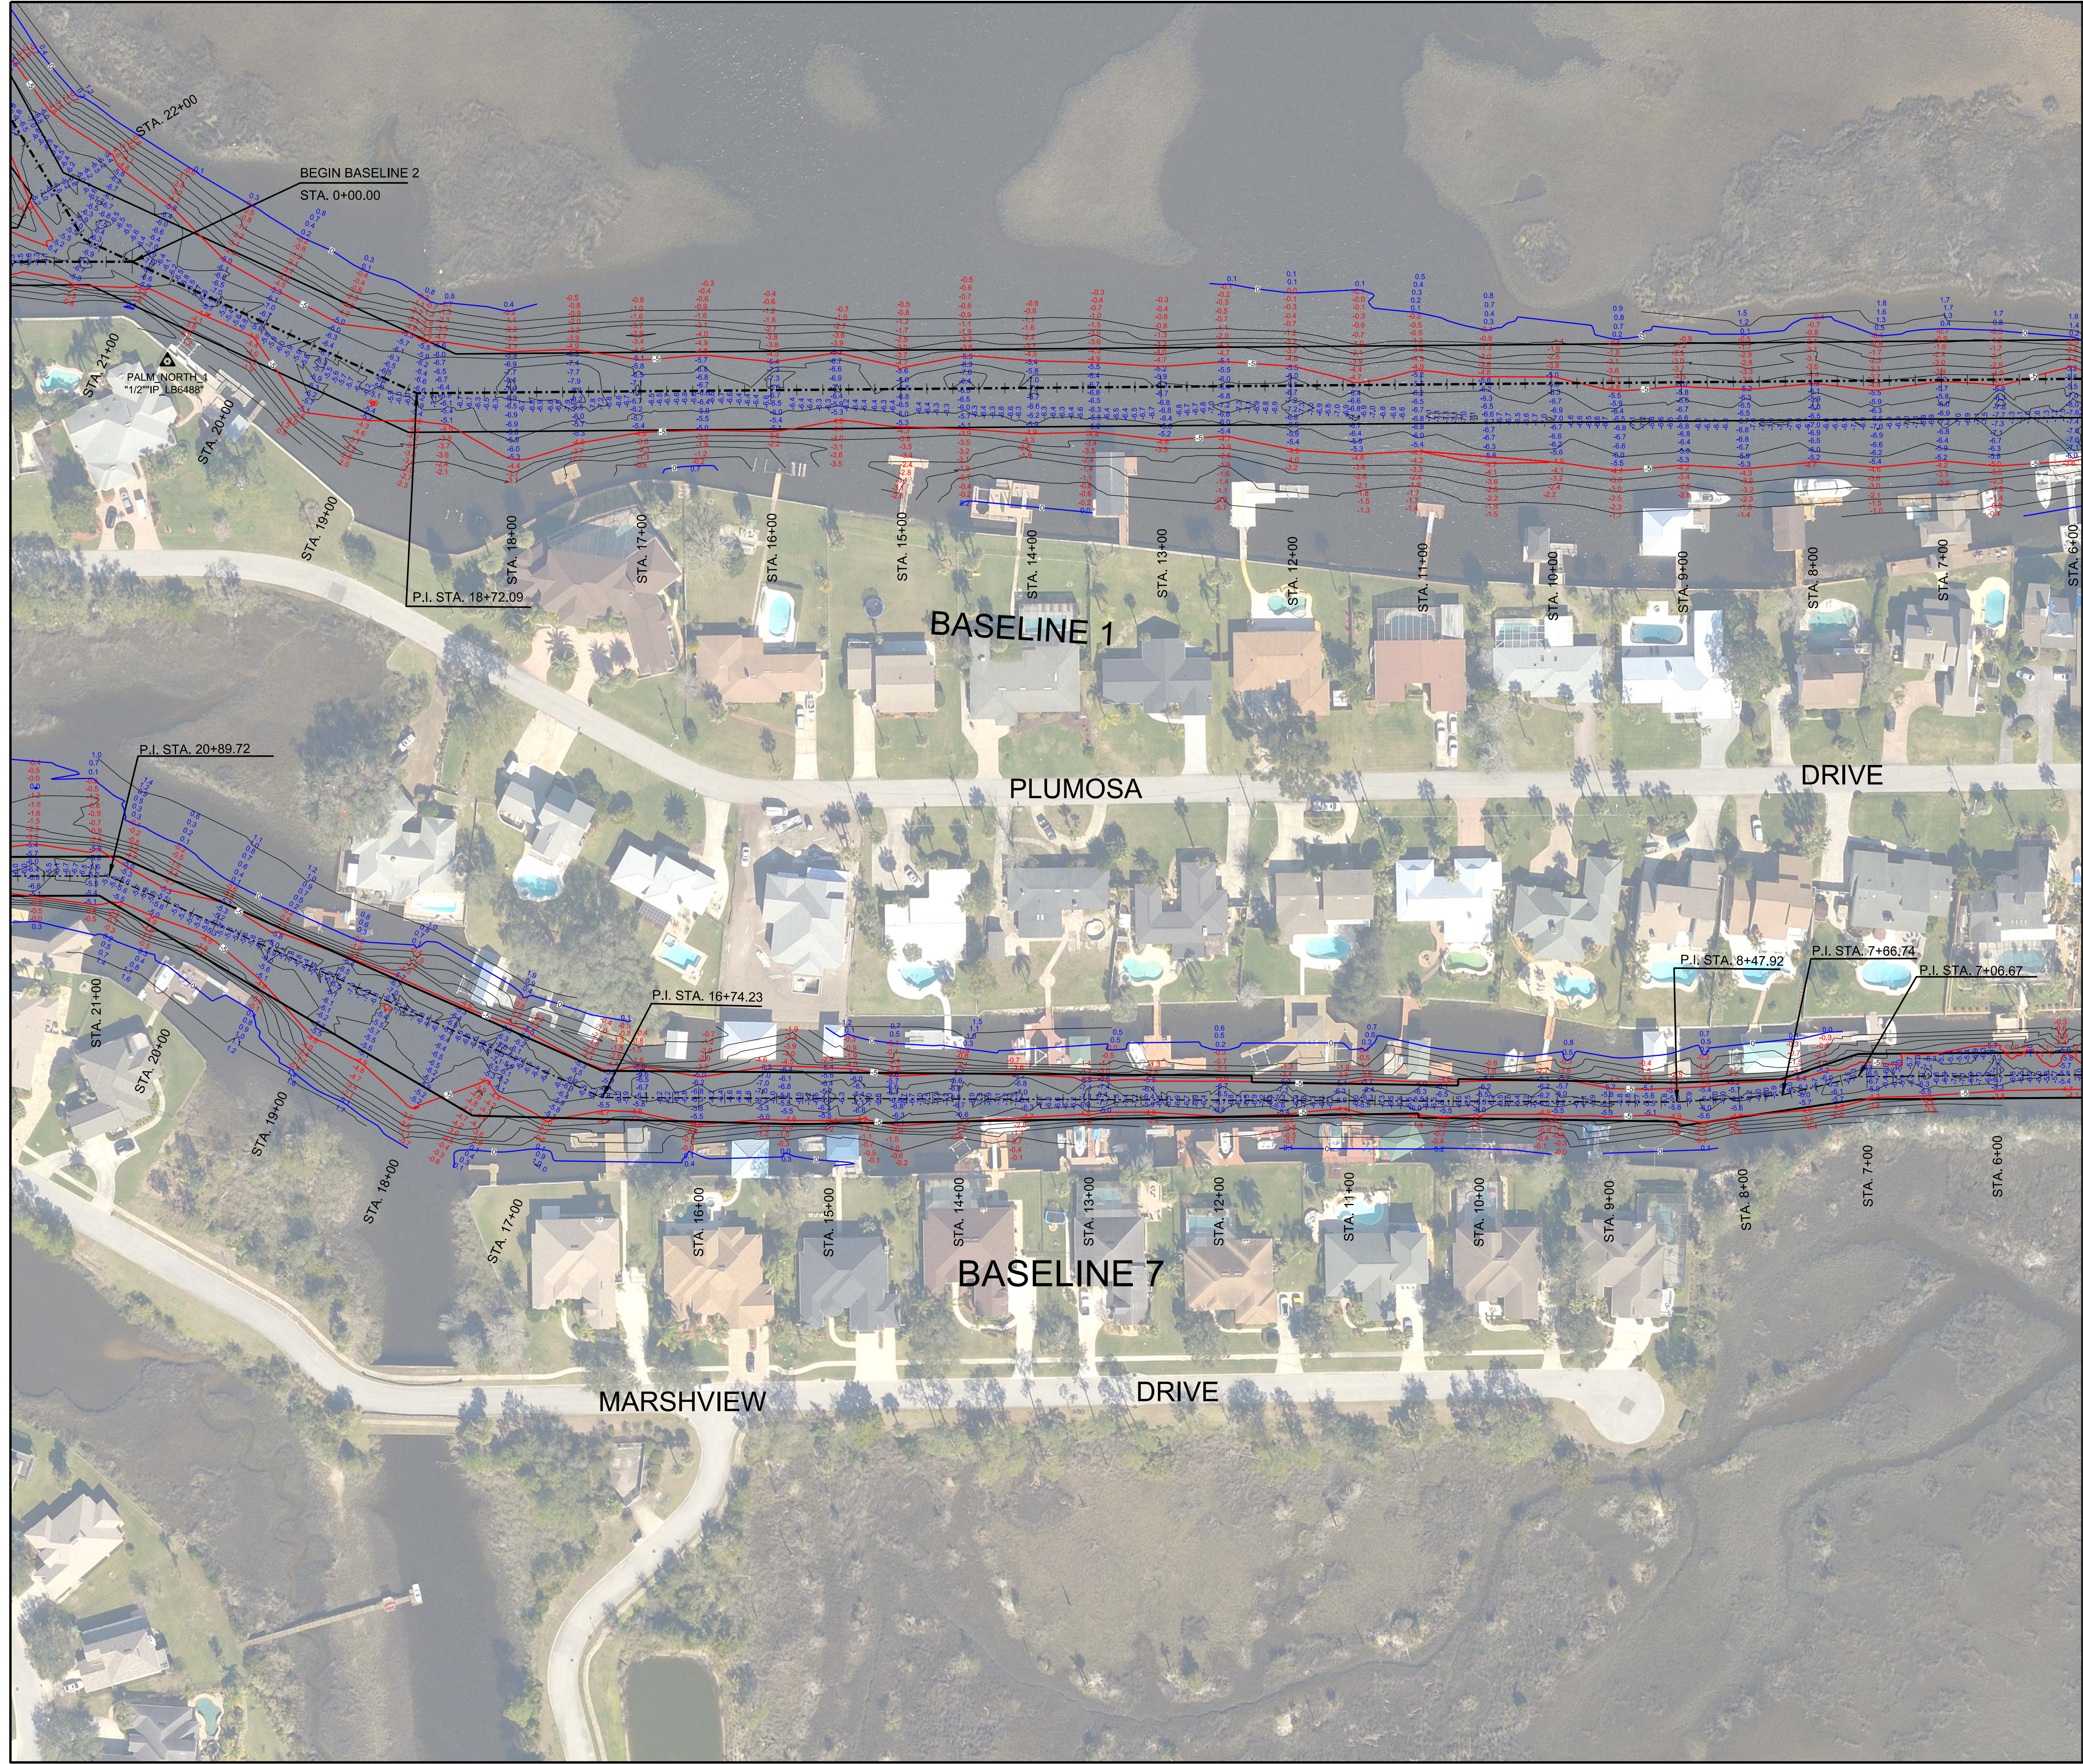


SHEET INDEX

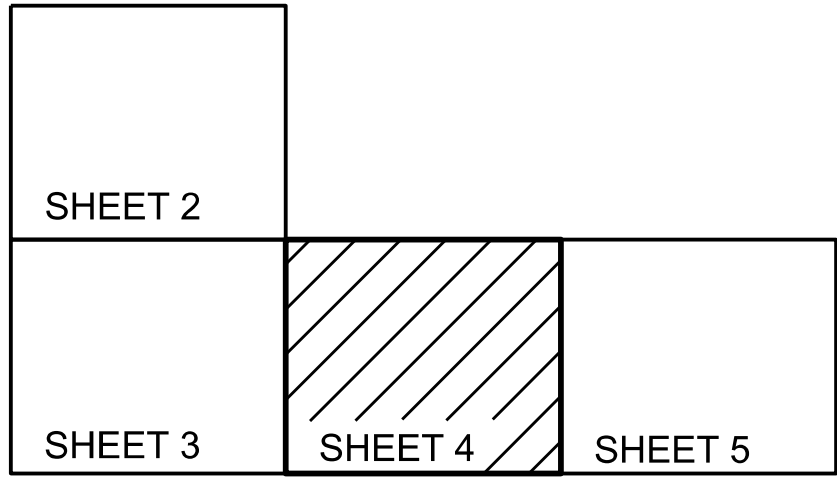

LEGEND/ABBREVIATIONS

- = CHANNEL CENTERLINE
- = CHANNEL TOE
- MLW = MEAN LOW WATER
- NO. = NUMBER
- P.I. = POINT OF INTERSECTION
- POB = POINT OF BEGINNING
- STA. = STATION
- NGVD = NATIONAL GEODETIC VERTICAL DATUM
- ELEV. = ELEVATION

- NOTES:
1. REFER TO SURVEY NO. 21-272
  2. SEE SHEET NO.1 FOR SURVEY NOTES.

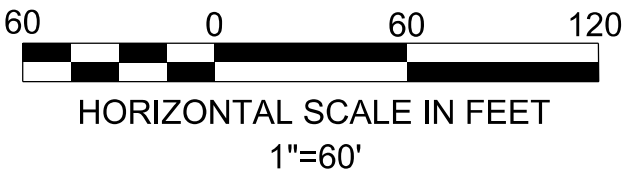


| DATE | BY | REVISION |
|------|----|----------|
|      |    |          |
|      |    |          |
|      |    |          |
|      |    |          |

Project Title:  
Isle of Palms North  
Hydrographic After-Dredge Survey



Prepared For:  
Isle of Palms Special District  
501 Riverside Avenue  
Jacksonville, FL 32202

Arc Surveying & Mapping, Inc.  
Professional Hydrographers • Surveyors • Mappers  
5202 San Juan Avenue  
Florida 32210  
Jacksonville, FL 32210  
904.394.8377

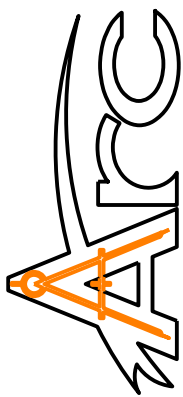


|                         |
|-------------------------|
| LB No. 6487             |
| Drawn By: D. Trabits    |
| Scale: see map          |
| Plot Date: 04/07/22     |
| File Name:              |
| Fld Bk / Pg:NA          |
| ARC Project No.: 21-272 |
| SHEET: 4 OF: 18         |



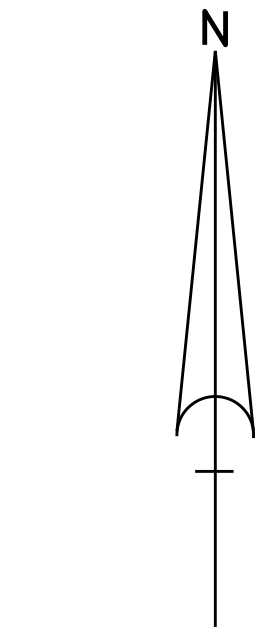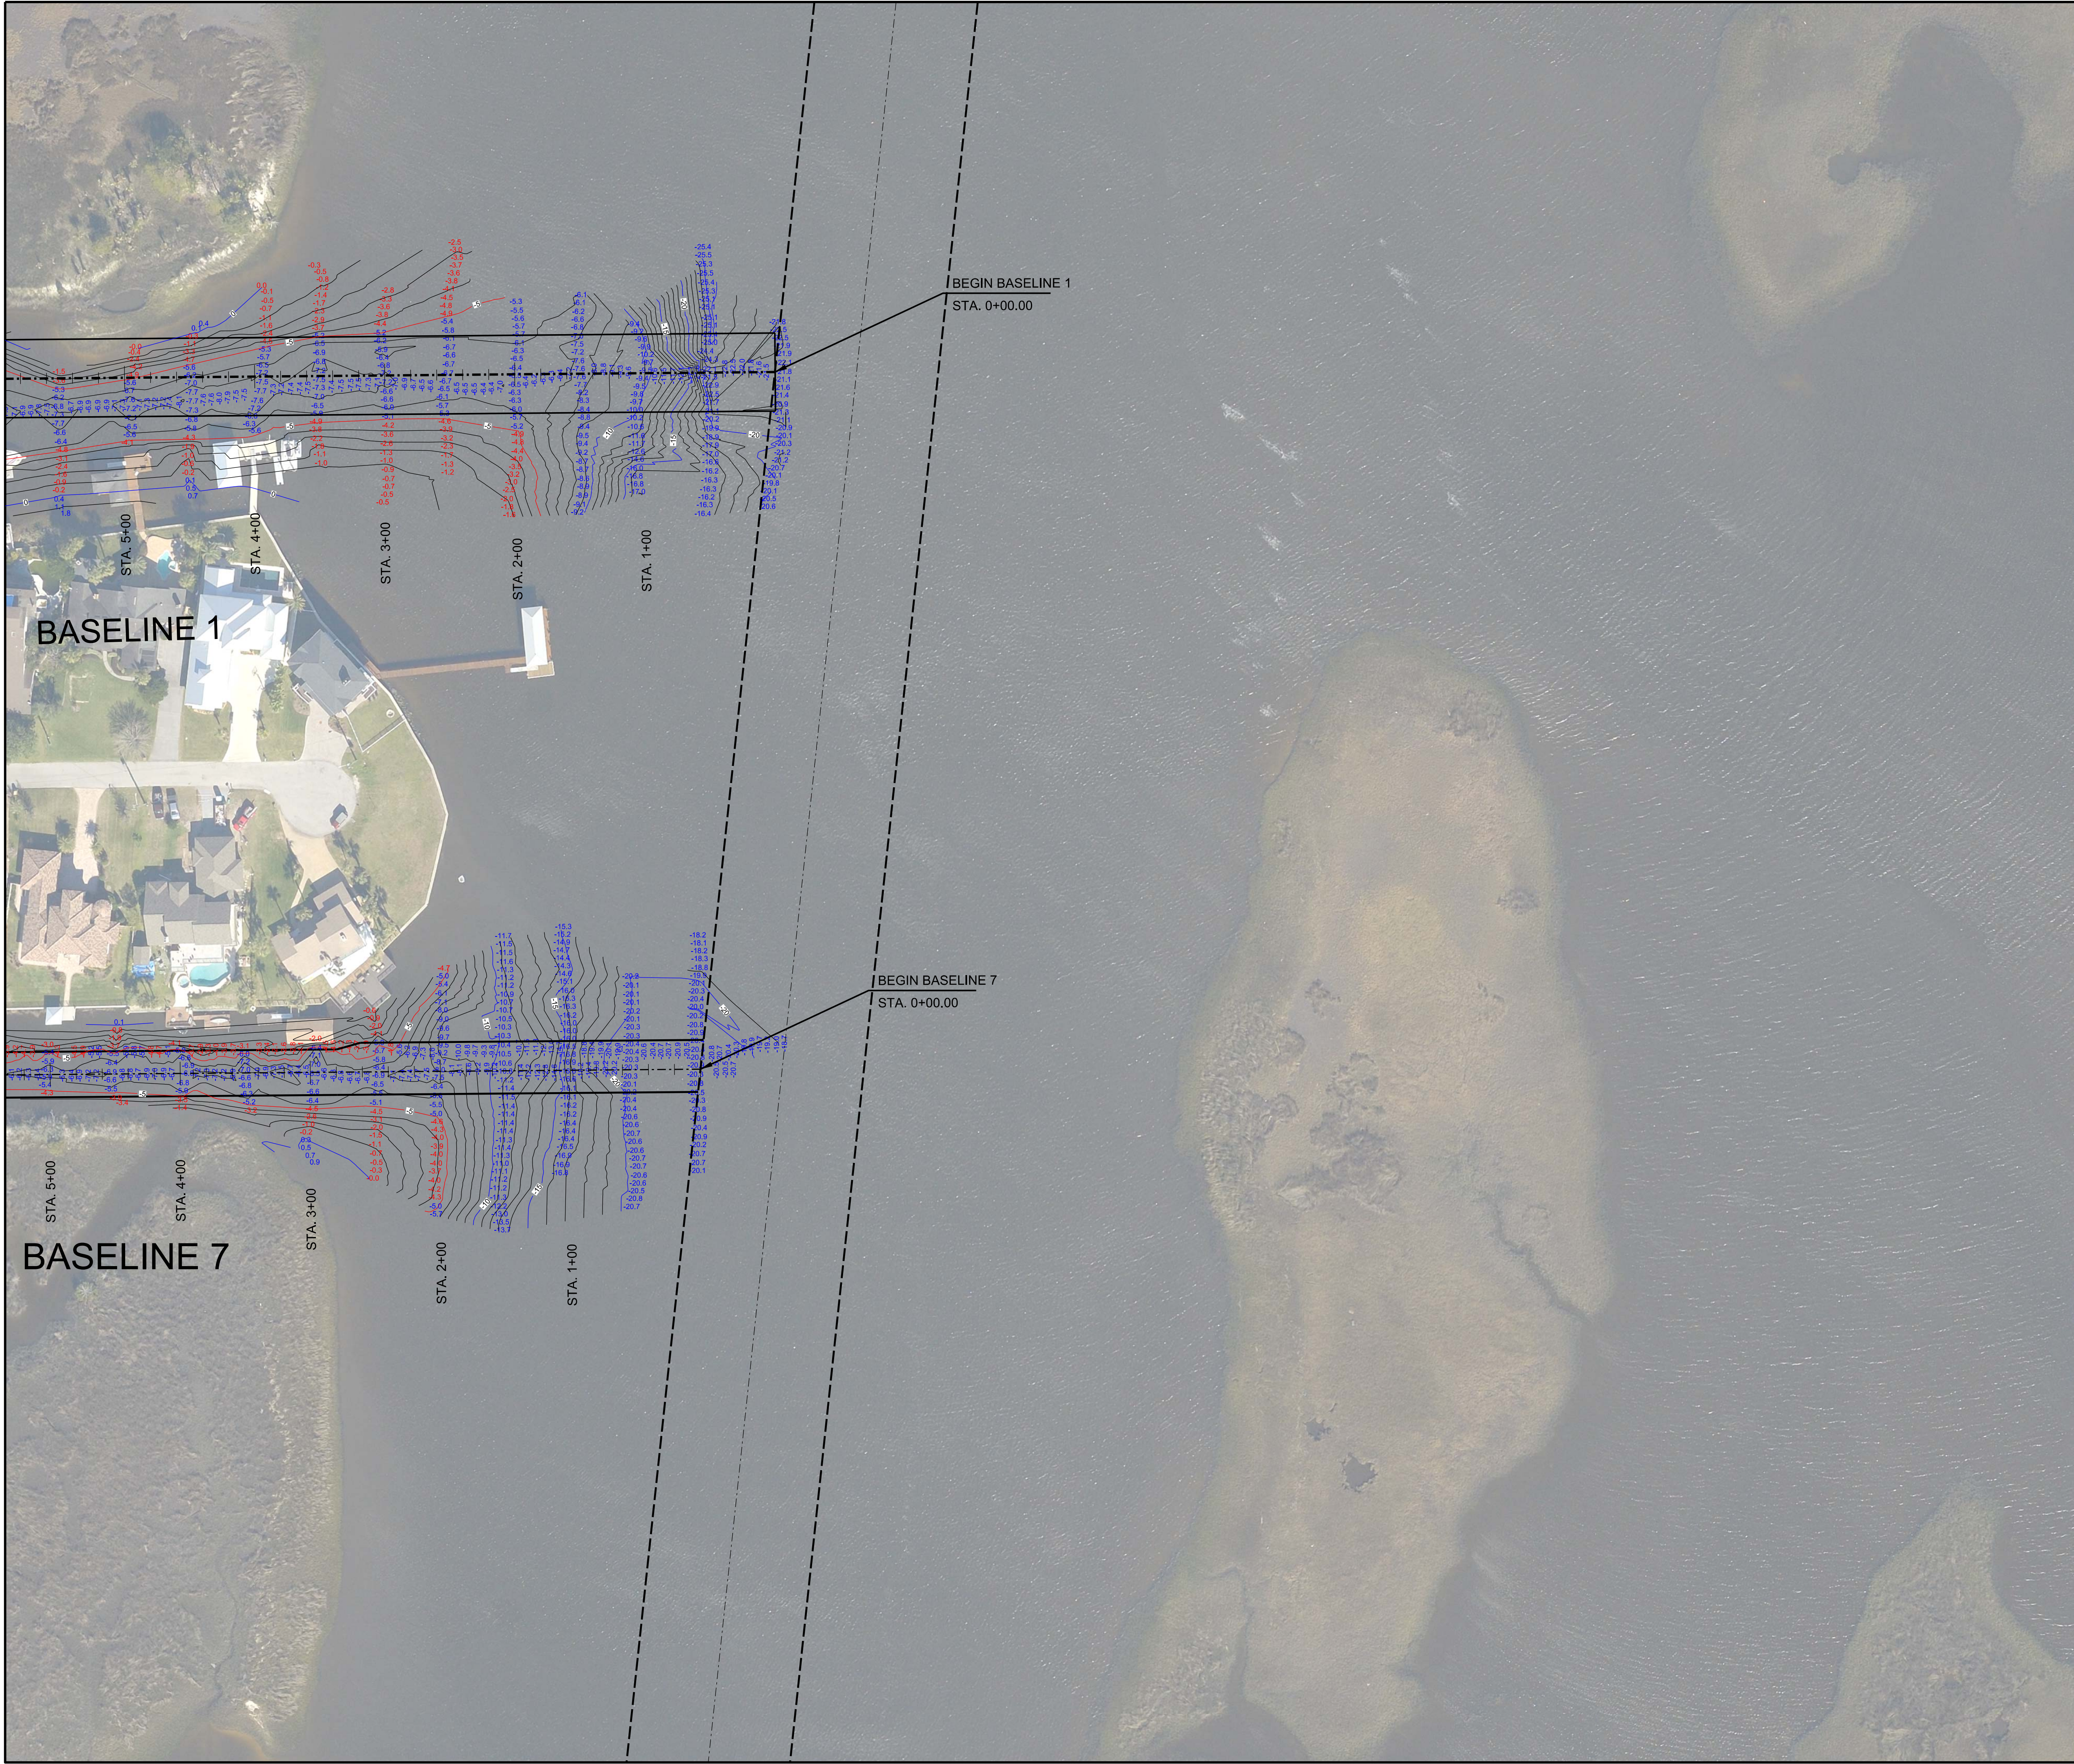


SHEET INDEX

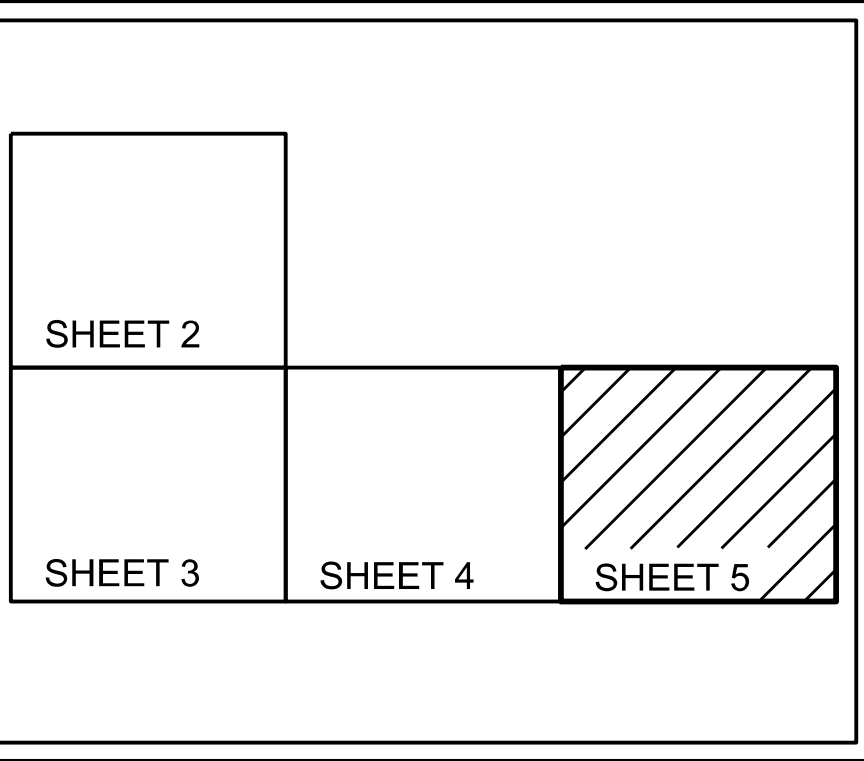

LEGEND/ABBREVIATIONS

- = CHANNEL CENTERLINE
- = CHANNEL TOE
- MLW = MEAN LOW WATER
- NO. = NUMBER
- P.I. = POINT OF INTERSECTION
- POB = POINT OF BEGINNING
- STA. = STATION
- NGVD = NATIONAL GEODETIC VERTICAL DATUM
- ELEV. = ELEVATION

- NOTES:
1. REFER TO SURVEY NO. 21-272
  2. SEE SHEET NO.1 FOR SURVEY NOTES.

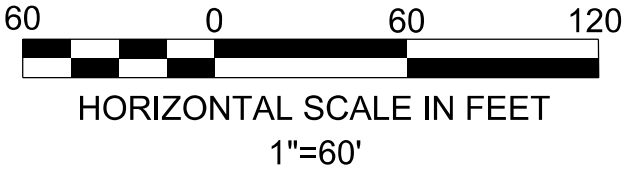

| DATE | BY | REVISION |
|------|----|----------|
|      |    |          |
|      |    |          |
Project Title:  
Isle of Palms North  
Hydrographic After-Dredge Survey

Prepared For:  
Isle of Palms Special District  
501 Riverside Avenue  
Jacksonville, FL 32202



Arc Surveying & Mapping, Inc.  
Professional Hydrographers • Surveyors • Mappers  
5202 San Juan Avenue  
Jacksonville, Florida 32210  
904.394.6377

LB No. 6487  
Drawn By: D. Trabis  
Scale: see map  
Plot Date: 04/07/22  
File Name:  
Fld Bk / Pg:NA  
ARC Project No.:  
21-272

SHEET: 5 OF: 18



# Baseline 1

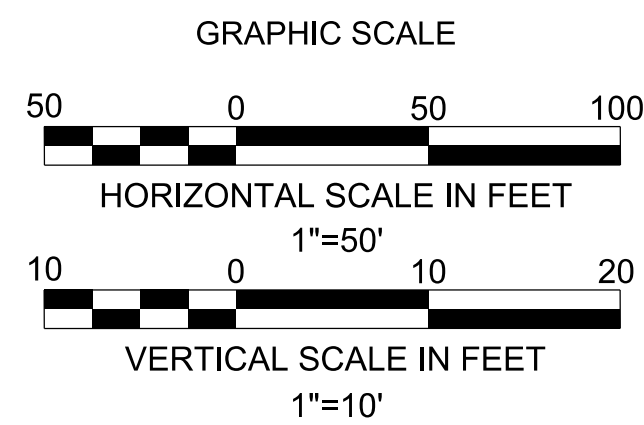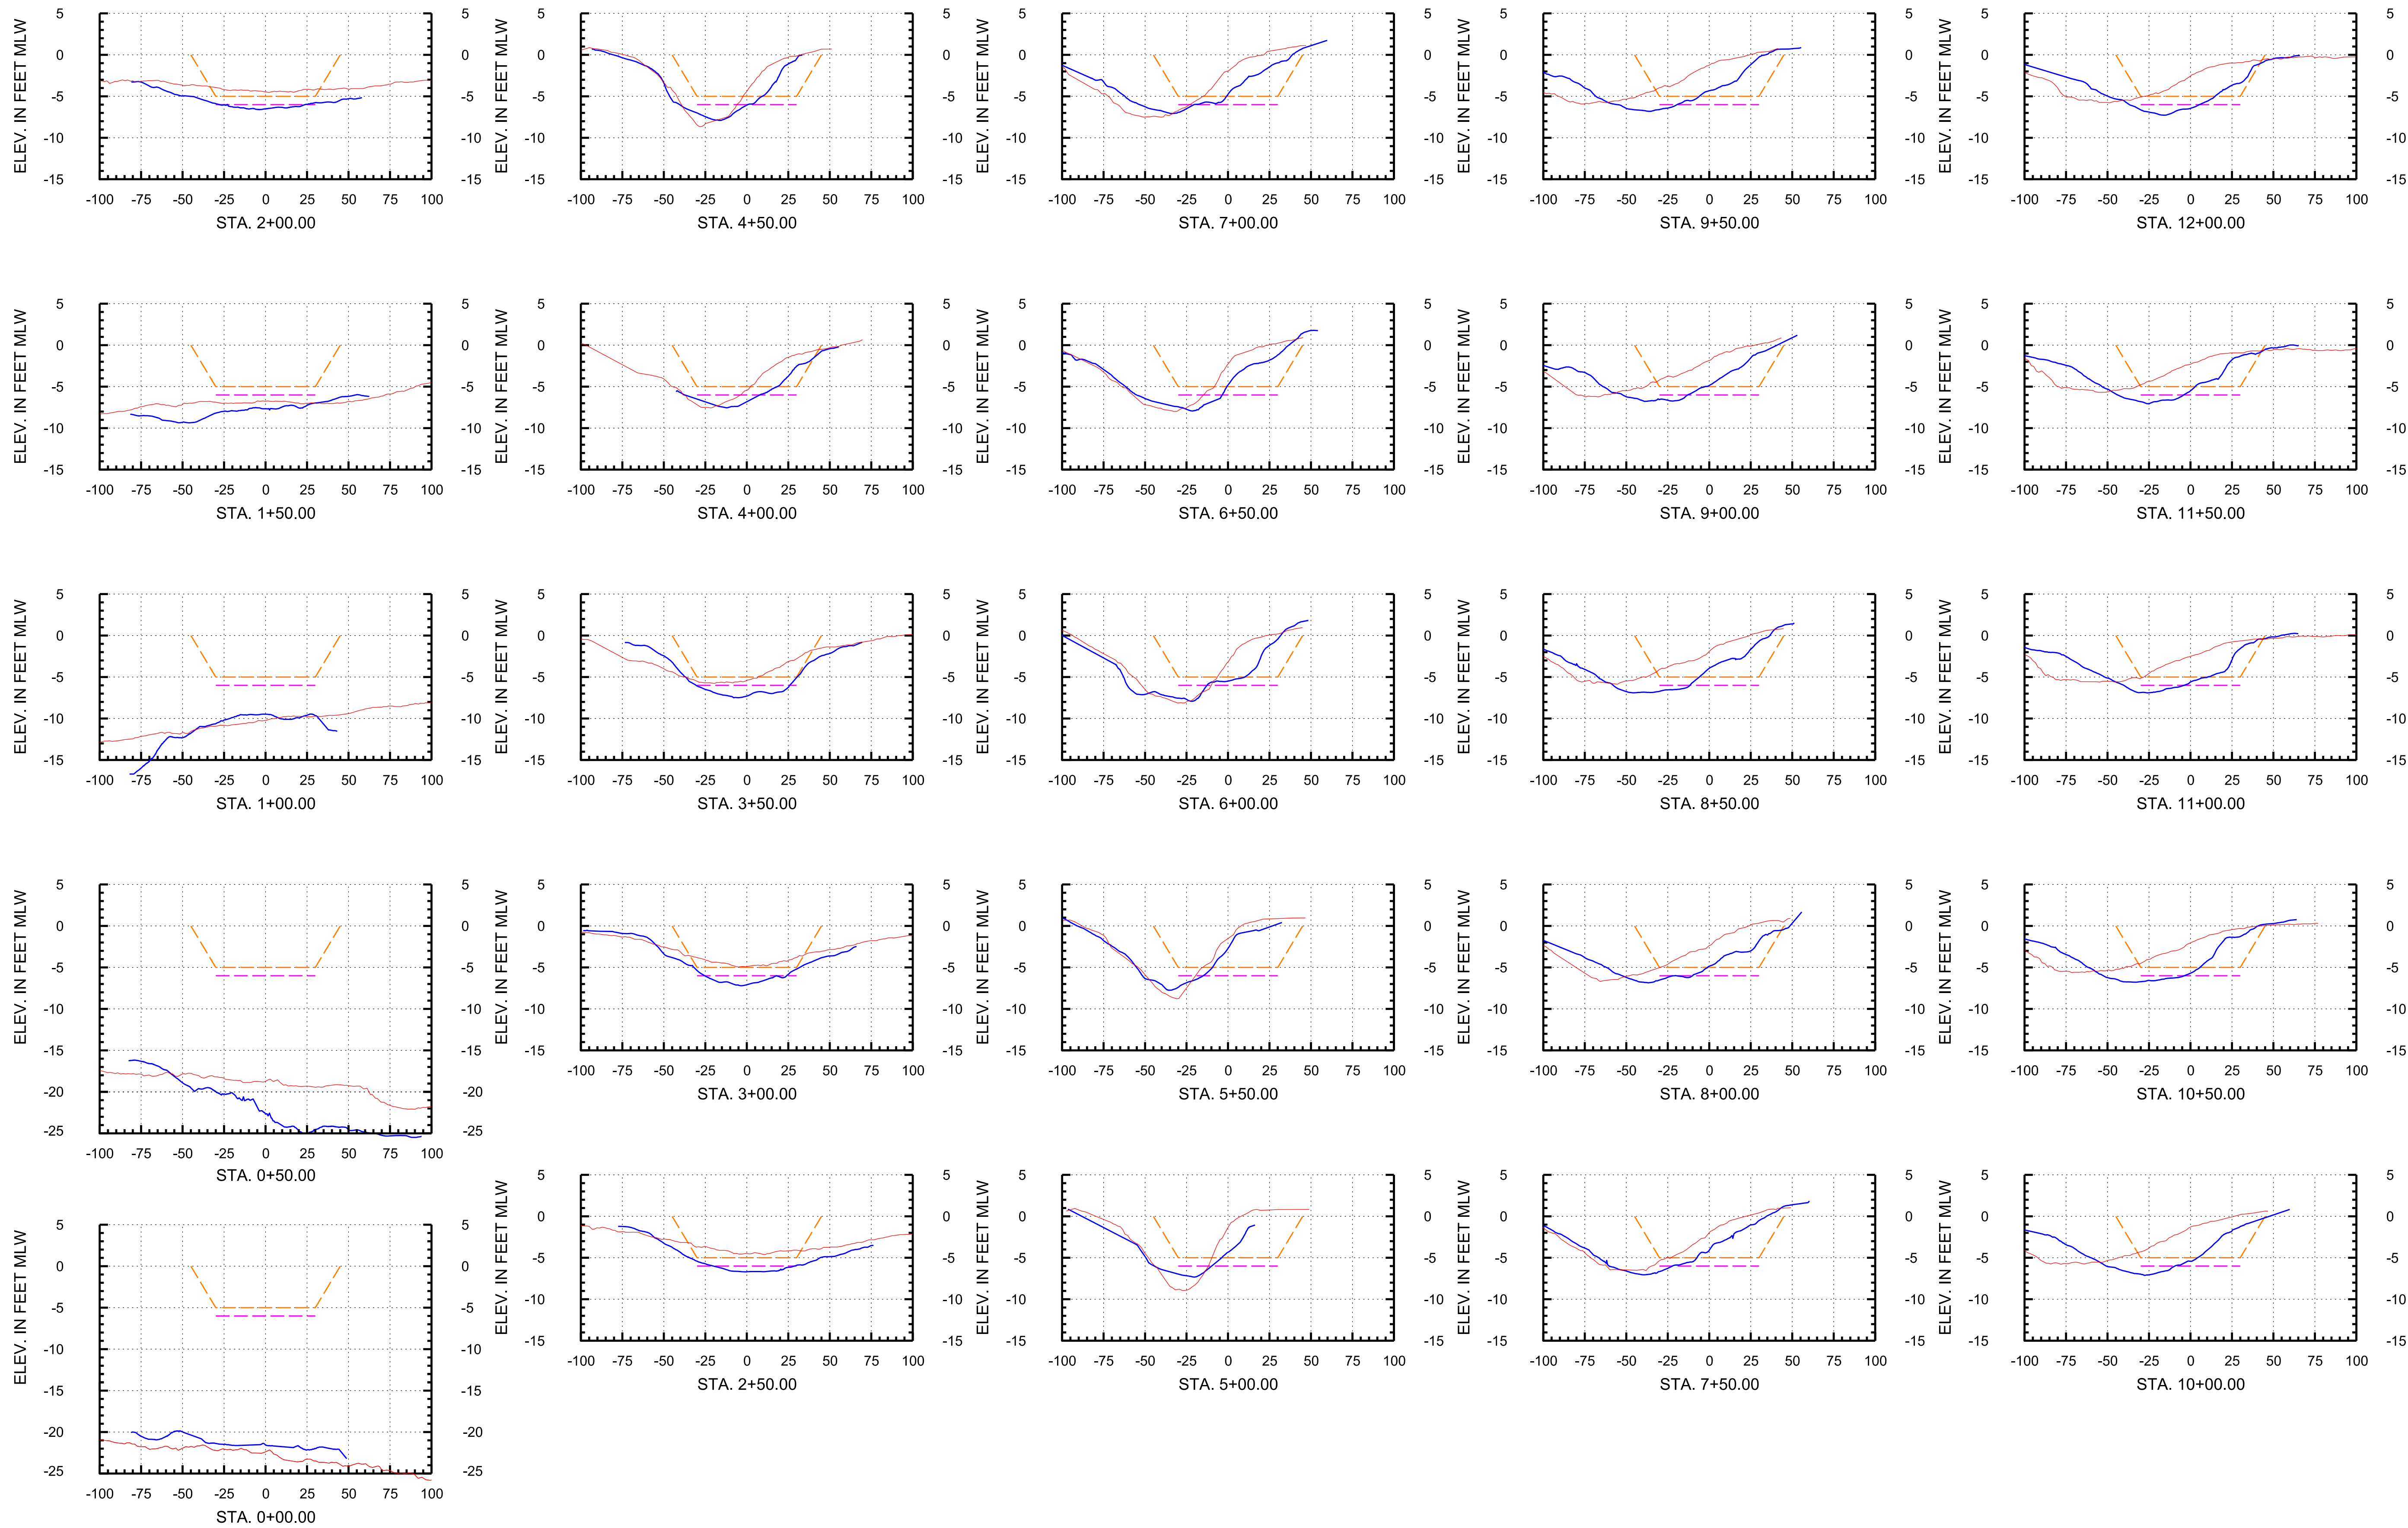

**Arc Surveying & Mapping, Inc.**  
Professional Hydrographers • Surveyors • Mappers  
5202 San Juan Avenue  
Jacksonville, Florida 32210  
904.384.8377

Prepared For:  
**Isle of Palms Special District**  
501 Riverside Avenue  
Jacksonville, FL 32202

Project Title:  
Isle of Palms North  
Hydrographic After-Dredge Survey

— = ARC SURVEY HYDROGRAPHIC SURVEY MARCH 15-29, 2022  
— = ARC SURVEY HYDROGRAPHIC SURVEY JUNE 23-JULY 6, 2020

MLW = MEAN LOW WATER  
STA. = STATION



— = TEMPLATE AT -5' MLW (REVISED PER CLIENT)  
- - - = TEMPLATE AT -6' MLW (REVISED PER CLIENT)

| DATE | BY | REVISION |
|------|----|----------|
|      |    |          |
|      |    |          |
|      |    |          |
|      |    |          |

LB No. 6487  
Drawn By: D. Trabis  
Scale: see map  
Plot Date: 04/07/22  
File Name:  
Fld Bk / Pg:  
ARC Project No.:  
21-272  
SHEET: 6 OF: 18



# Baseline 1

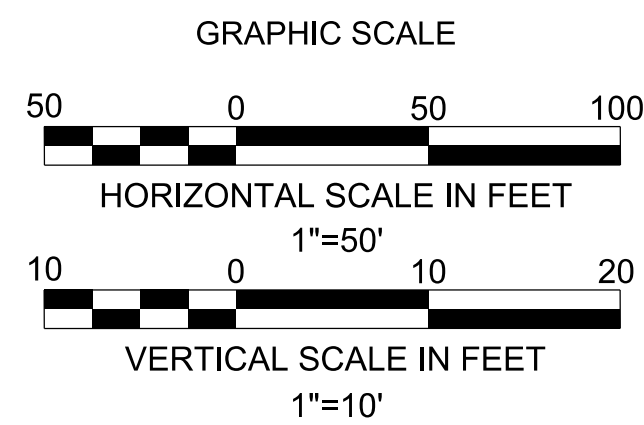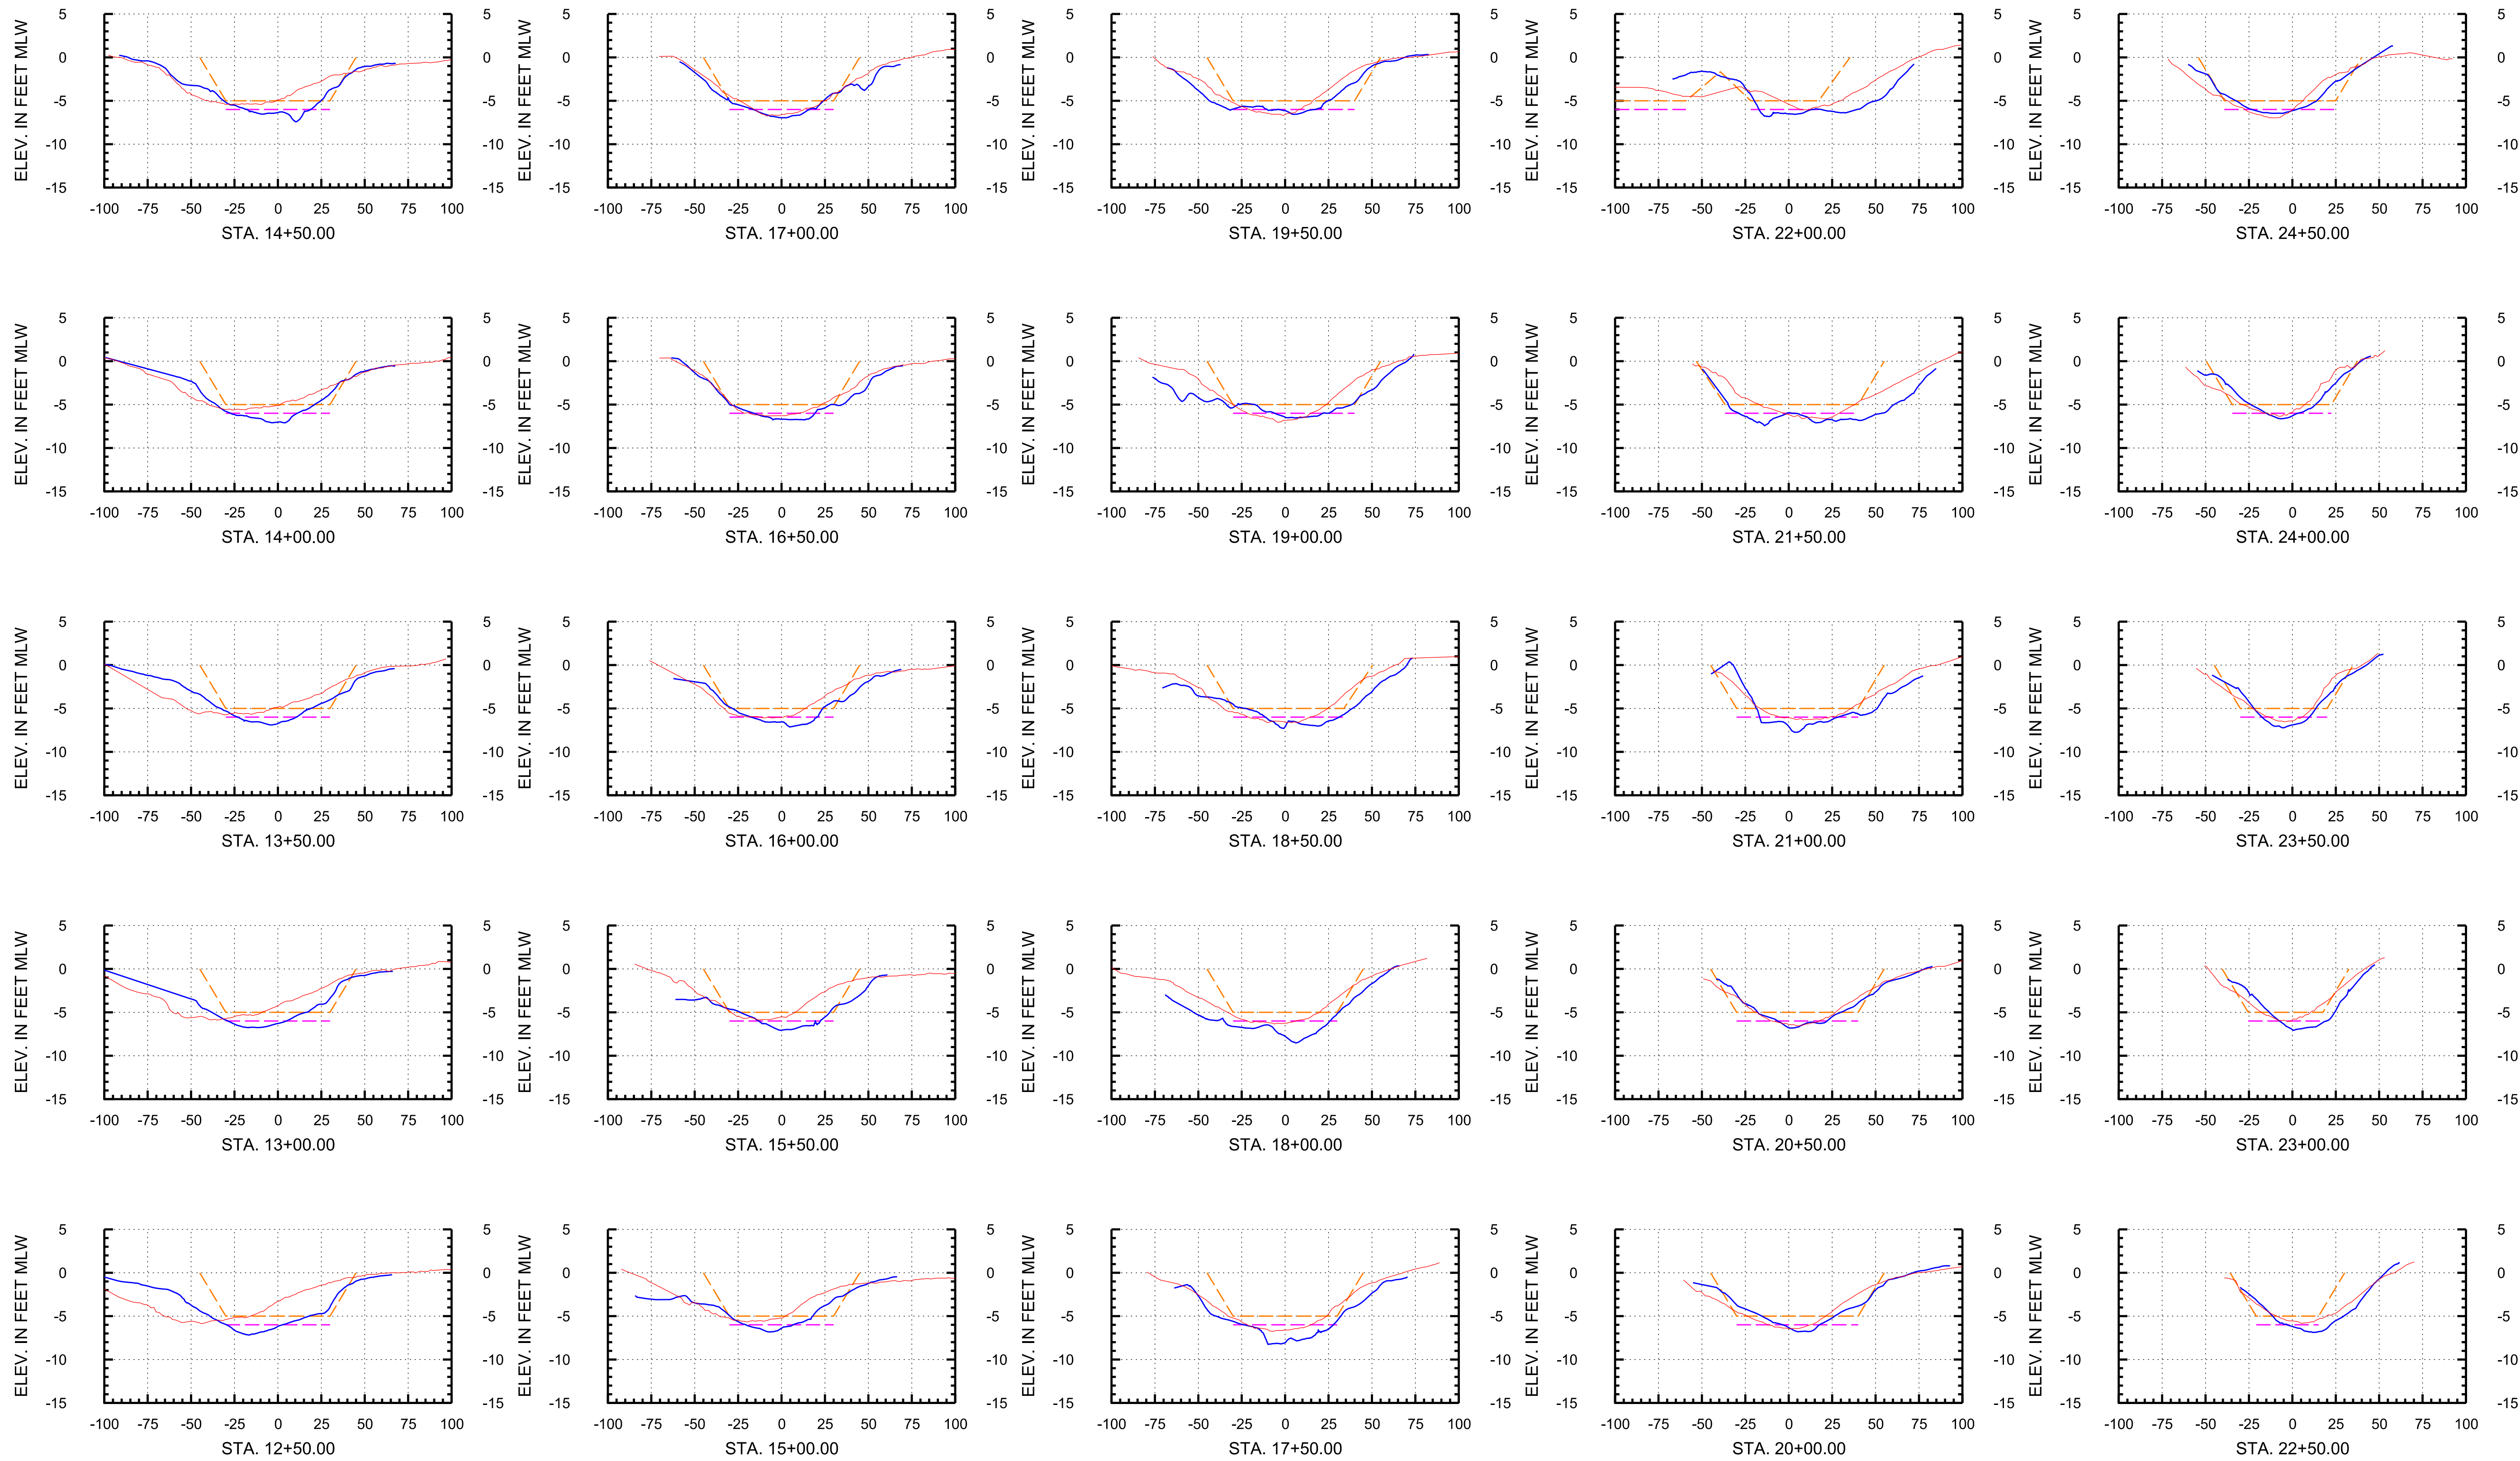

**Arc Surveying & Mapping, Inc.**  
Professional Hydrographers • Surveyors • Mappers  
5202 San Juan Avenue  
Jacksonville, Florida 32210  
904.384.8377

Prepared For:  
**Isle of Palms Special District**  
501 Riverside Avenue  
Jacksonville, FL 32202

Project Title:  
Isle of Palms North  
Hydrographic After-Dredge Survey

— = ARC SURVEY HYDROGRAPHIC SURVEY MARCH 15-29, 2022  
— = ARC SURVEY HYDROGRAPHIC SURVEY JUNE 23-JULY 6, 2020

MLW = MEAN LOW WATER  
STA. = STATION



— = TEMPLATE AT -5' MLW (REVISED PER CLIENT)  
— = TEMPLATE AT -6' MLW (REVISED PER CLIENT)

|      |    |          |
|------|----|----------|
|      |    |          |
|      |    |          |
|      |    |          |
|      |    |          |
| DATE | BY | REVISION |

LB No. 6487  
Drawn By: D. Trabits  
Scale: see map  
Plot Date: 04/07/22  
File Name:  
Fld Bk / Pg:  
ARC Project No.:  
21-272  
SHEET: 7 OF: 18



# Baseline 1

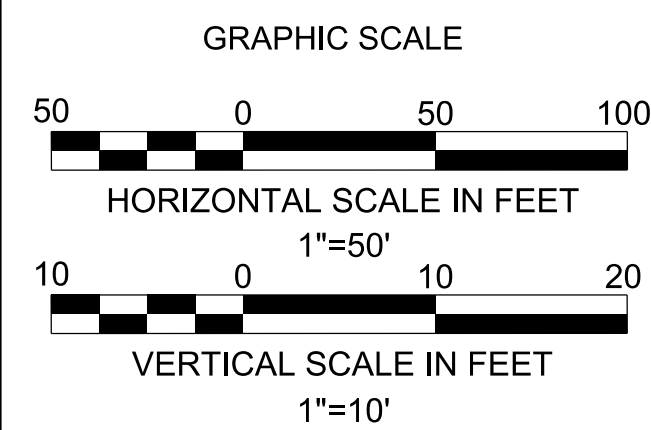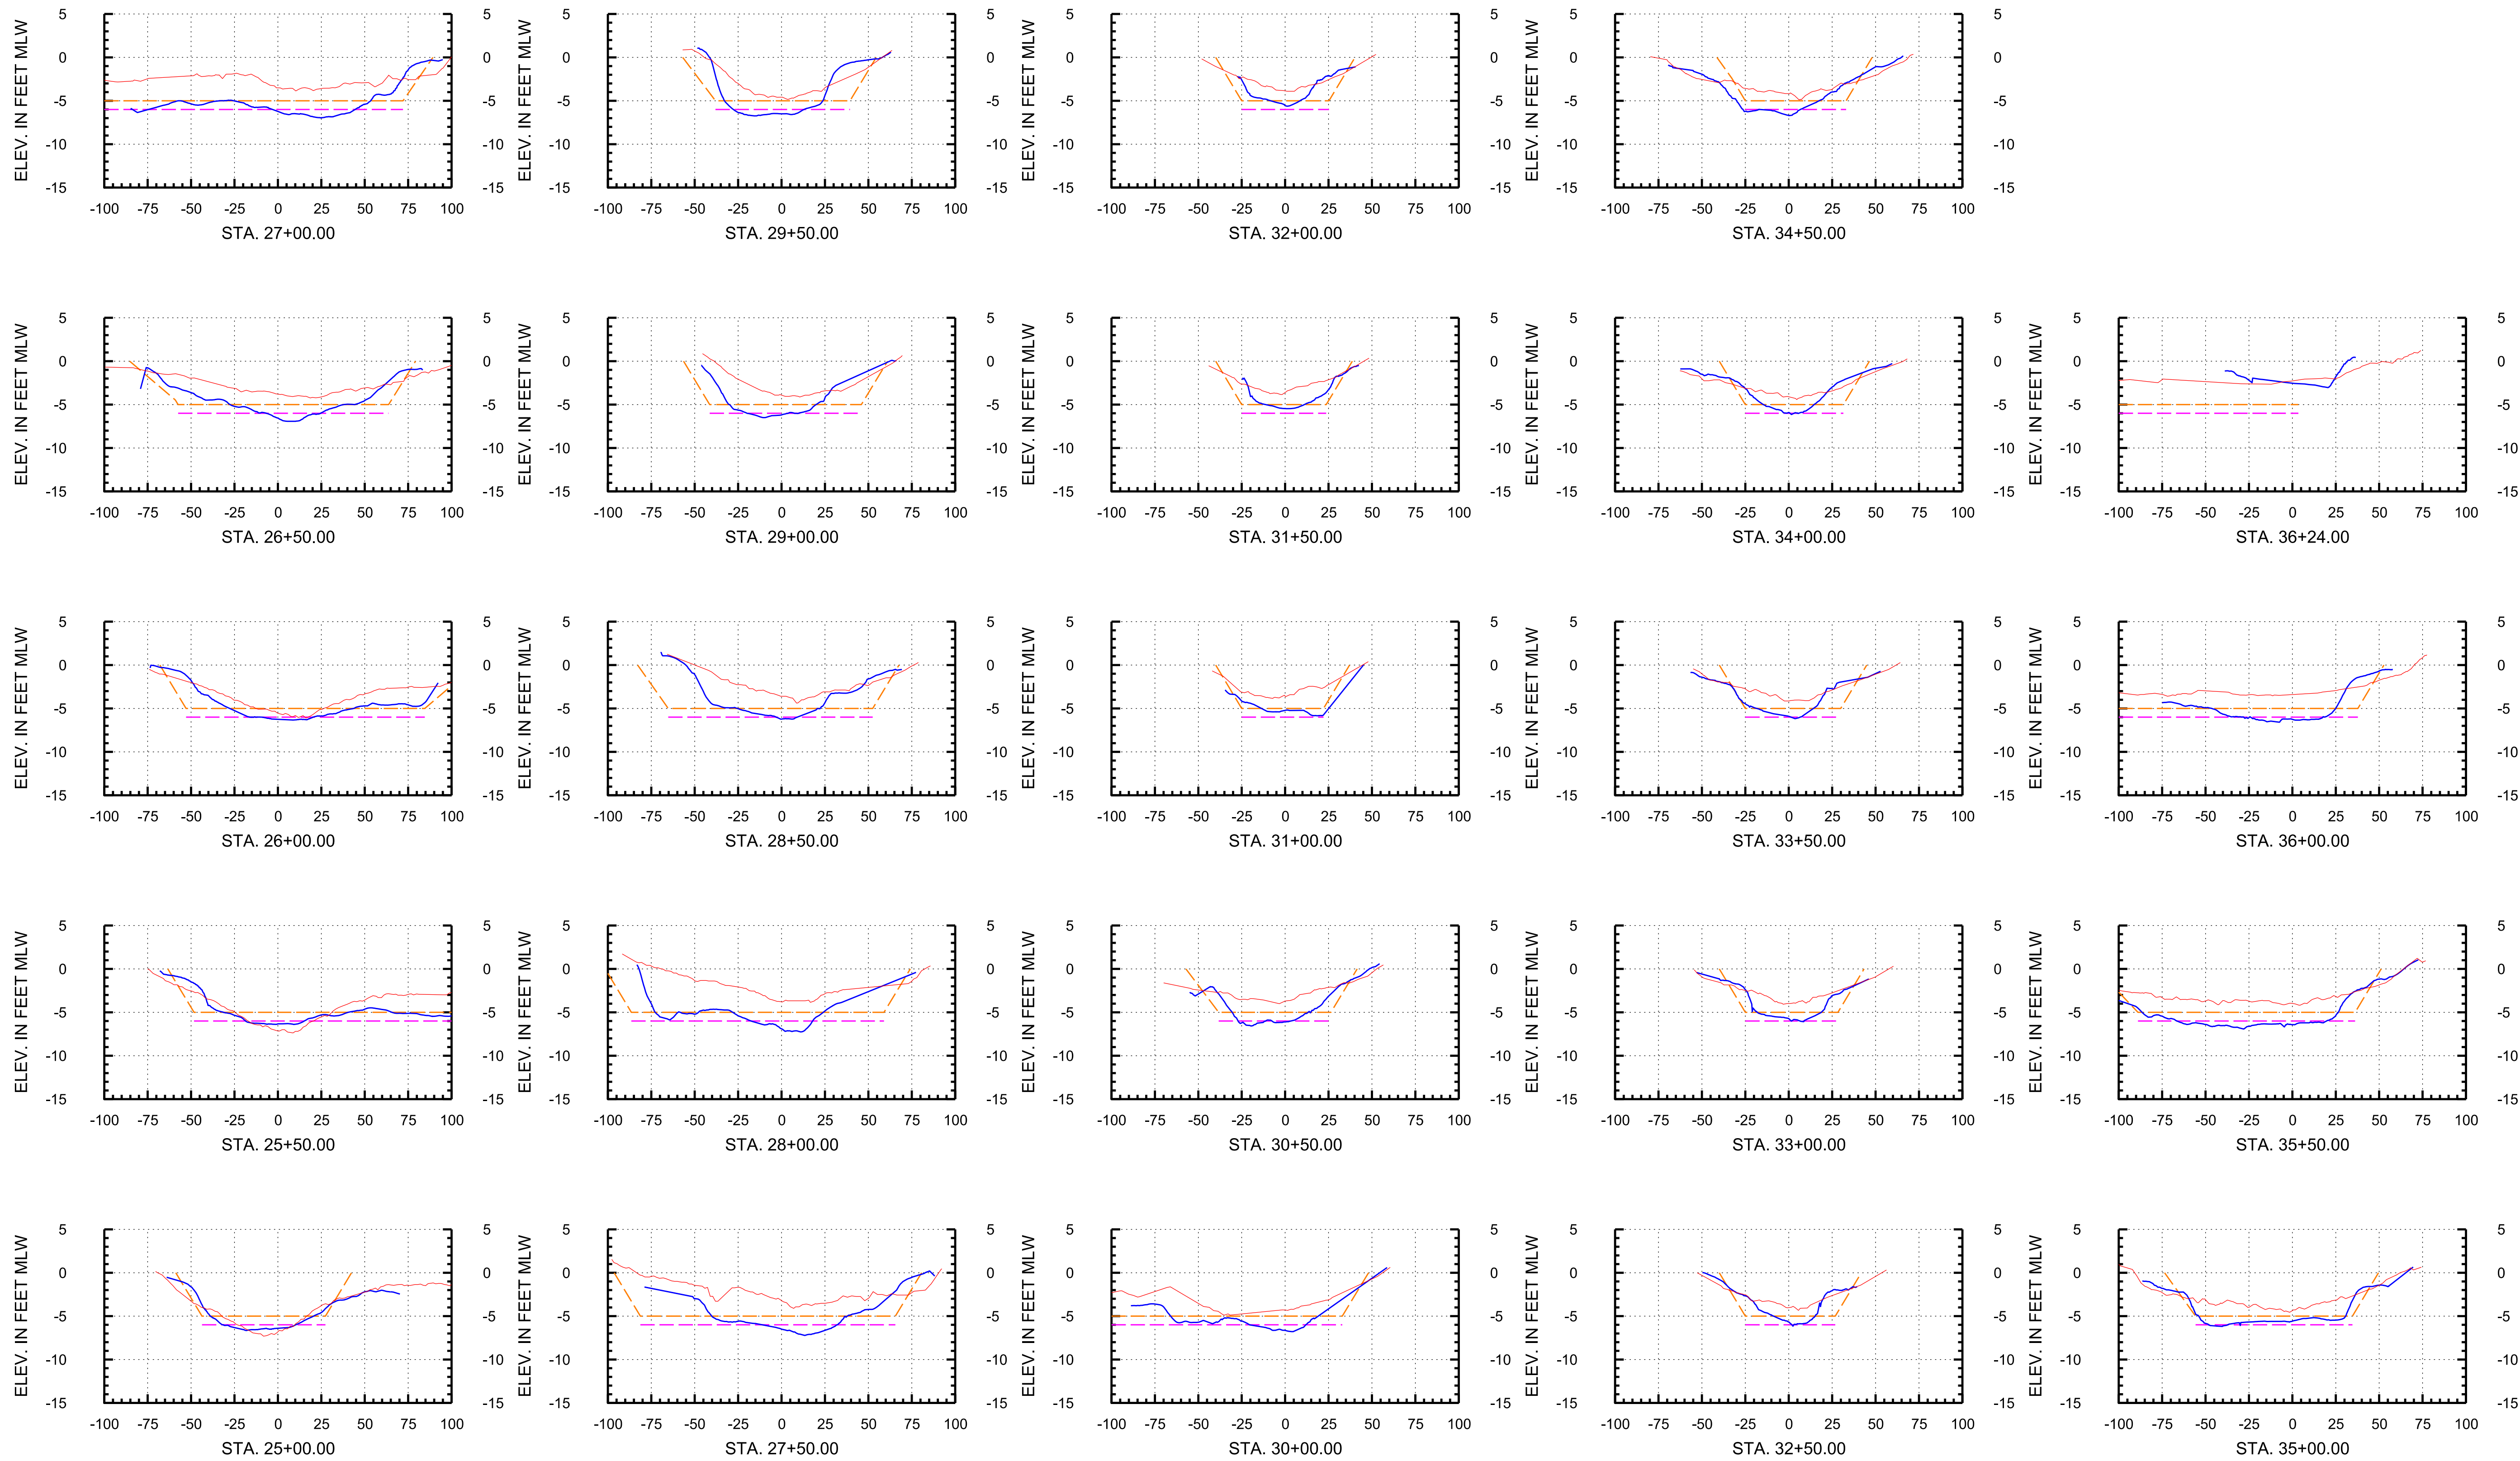

**Arc Surveying & Mapping, Inc.**  
Professional Hydrographers • Surveyors • Mappers  
5202 San Juan Avenue  
Jacksonville, Florida 32210  
904.384.8377

Prepared For:  
**Isle of Palms Special District**  
501 Riverside Avenue  
Jacksonville, FL 32202

Project Title:  
**Isle of Palms North  
Hydrographic After-Dredge Survey**

— = ARC SURVEY HYDROGRAPHIC SURVEY MARCH 15-29, 2022  
— = ARC SURVEY HYDROGRAPHIC SURVEY JUNE 23-JULY 6, 2020

MLW = MEAN LOW WATER  
STA. = STATION




— = TEMPLATE AT -5' MLW (REVISED PER CLIENT)  
— = TEMPLATE AT -6' MLW (REVISED PER CLIENT)

| DATE | BY | REVISION |
|------|----|----------|
|      |    |          |
|      |    |          |
|      |    |          |

LB No. 6487  
Drawn By: D. Trubits  
Scale: see map  
Plot Date: 04/07/22  
File Name:  
Fld Bk / Pg:  
ARC Project No.:  
21-272  
SHEET: 8 OF: 18



# Baseline 2

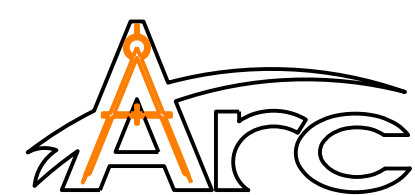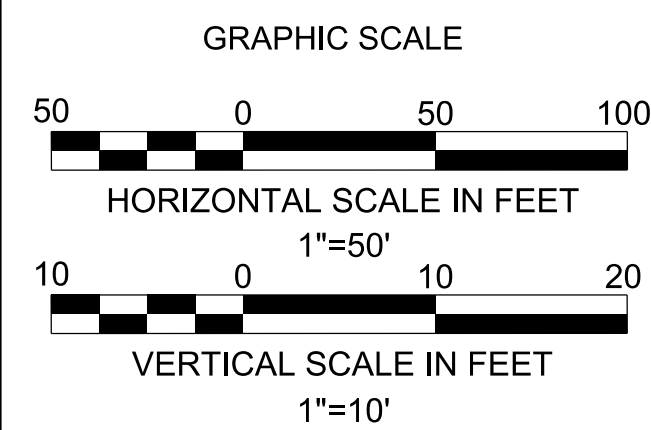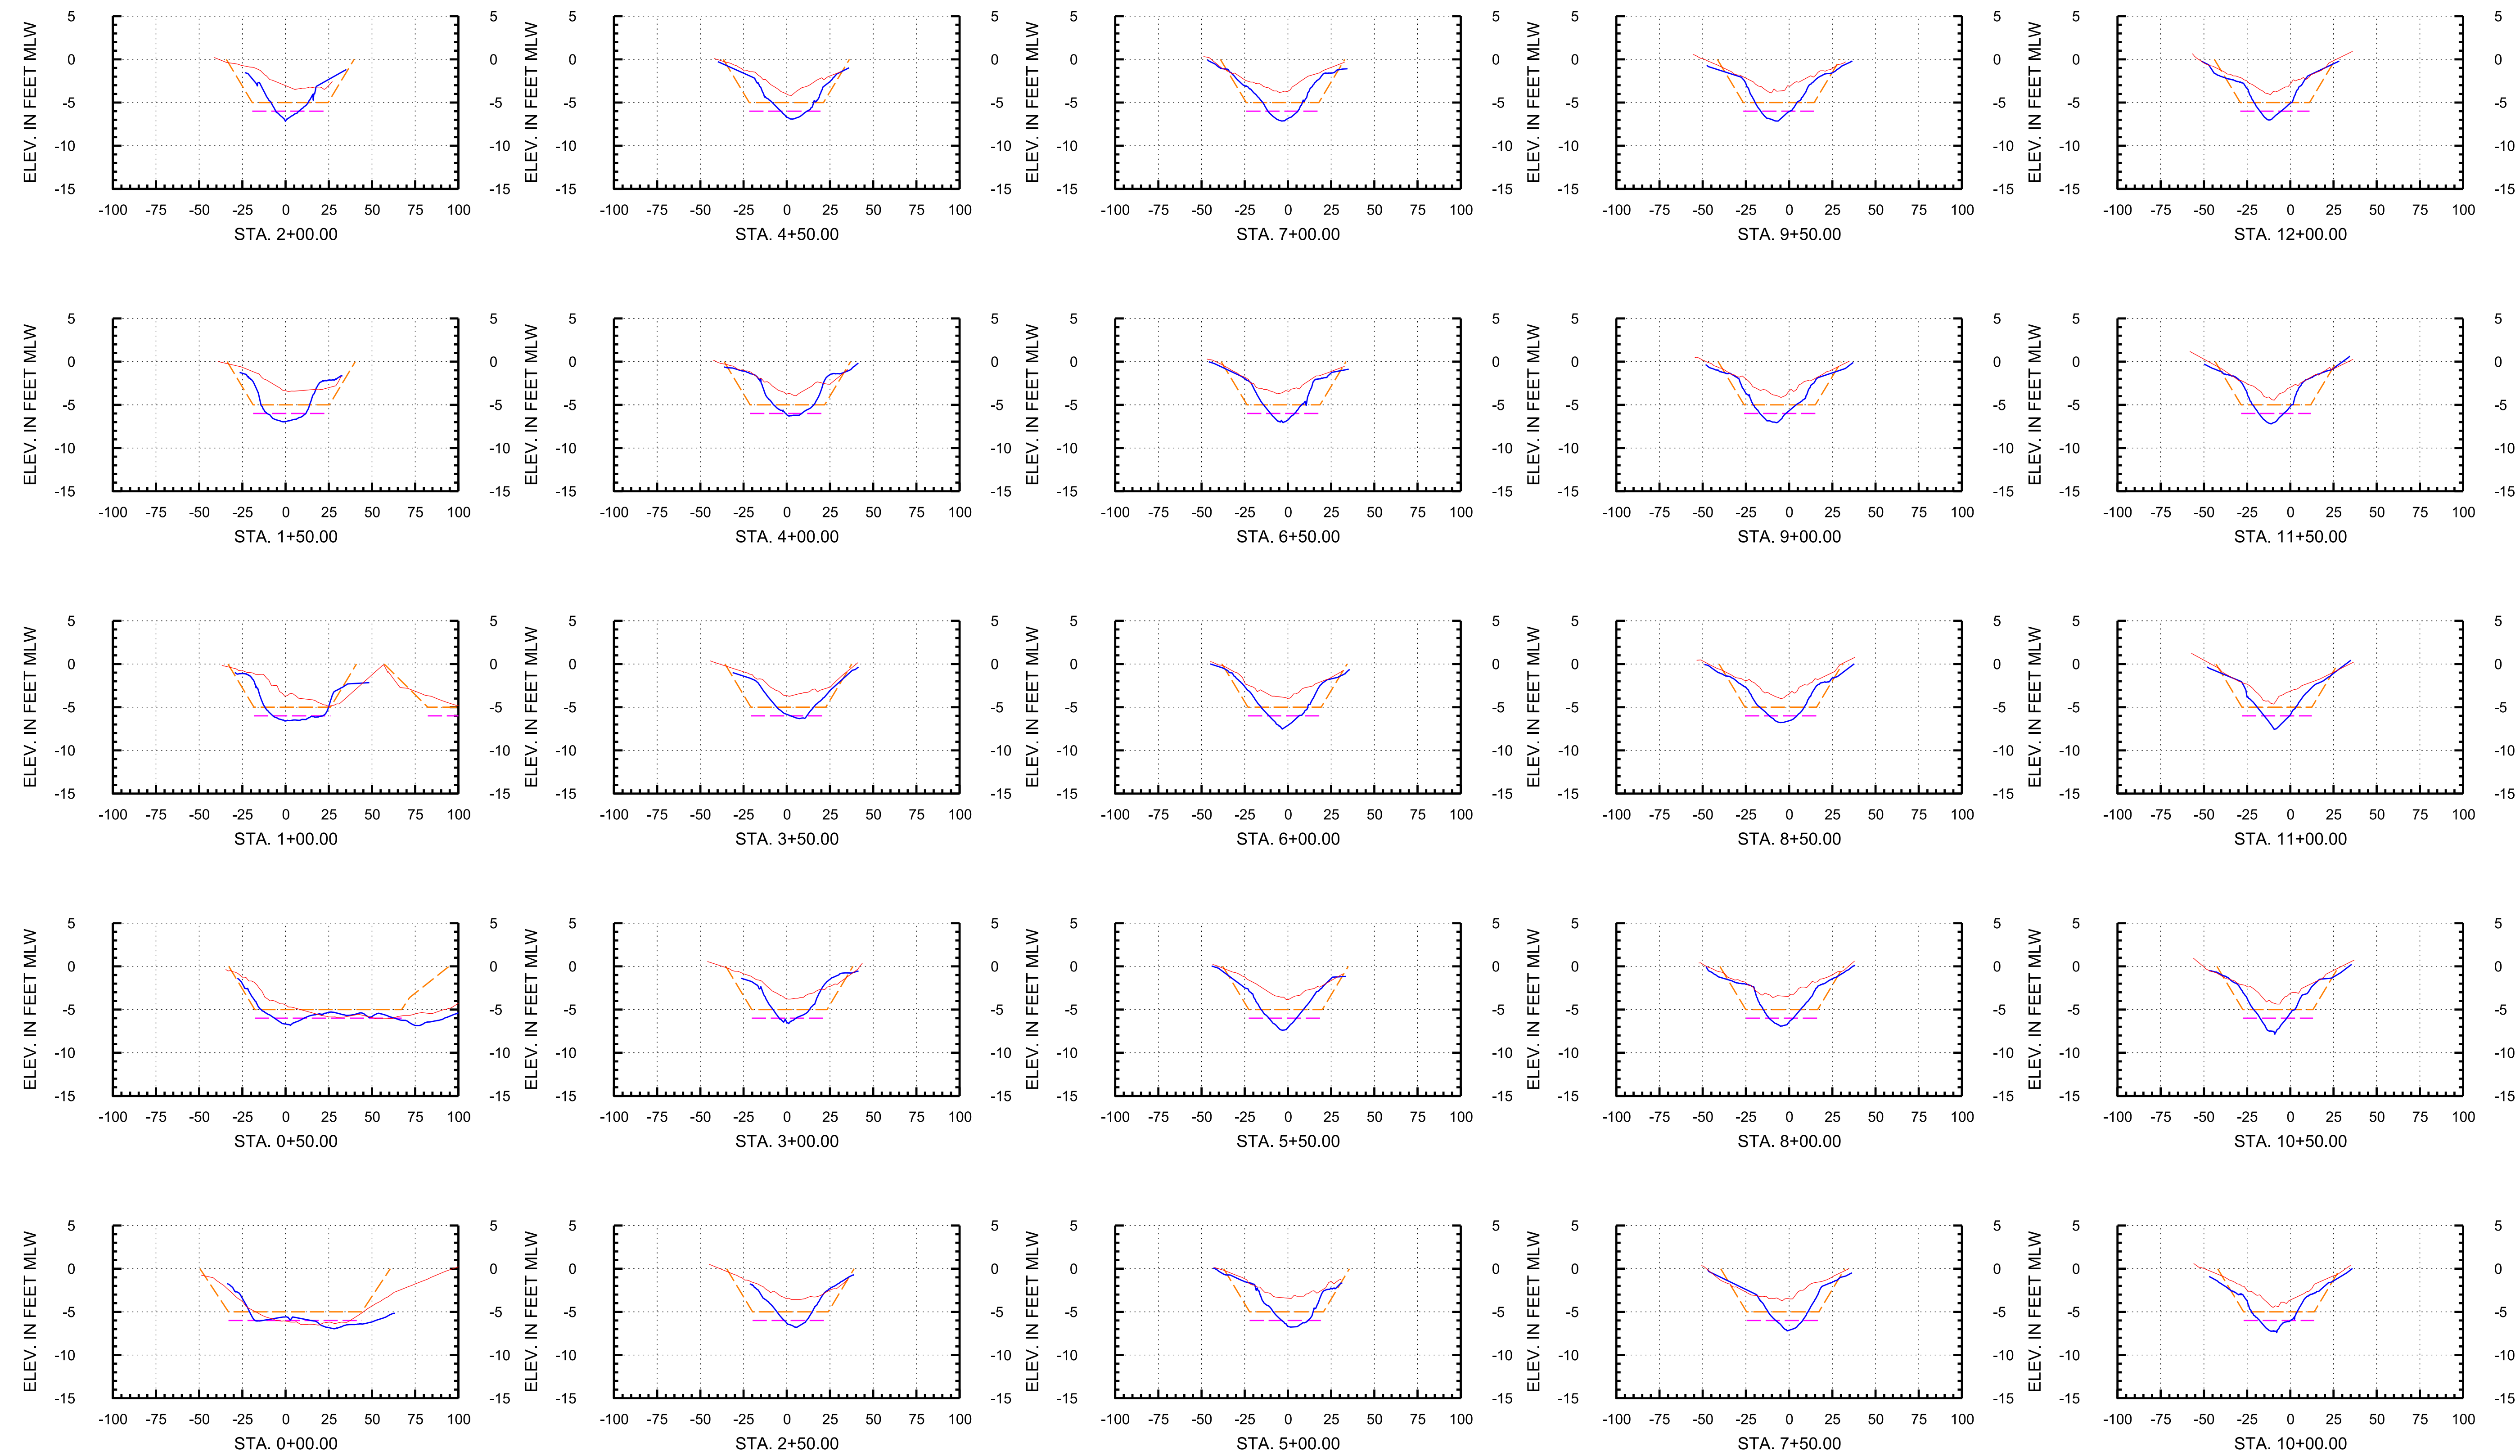

**Arc Surveying & Mapping, Inc.**  
Professional Hydrographers • Surveyors • Mappers  
5202 San Juan Avenue  
Jacksonville, Florida 32210  
904.384.8377

Prepared For:  
**Isle of Palms Special District**  
501 Riverside Avenue  
Jacksonville, FL 32202

Project Title:  
Isle of Palms North  
Hydrographic After-Dredge Survey

— = ARC SURVEY HYDROGRAPHIC SURVEY MARCH 15-29, 2022  
— = ARC SURVEY HYDROGRAPHIC SURVEY JUNE 23-JULY 6, 2020

MLW = MEAN LOW WATER  
STA. = STATION



— = TEMPLATE AT -5' MLW (REVISED PER CLIENT)  
— = TEMPLATE AT -6' MLW (REVISED PER CLIENT)

| DATE | BY | REVISION |
|------|----|----------|
|      |    |          |
|      |    |          |
|      |    |          |
|      |    |          |

|                         |
|-------------------------|
| LB No. 6487             |
| Drawn By: D. Trabits    |
| Scale: see map          |
| Plot Date: 04/07/22     |
| File Name:              |
| Fld Bk / Pg:            |
| ARC Project No.: 21-272 |
| SHEET: 9 OF: 18         |



# Baseline 2

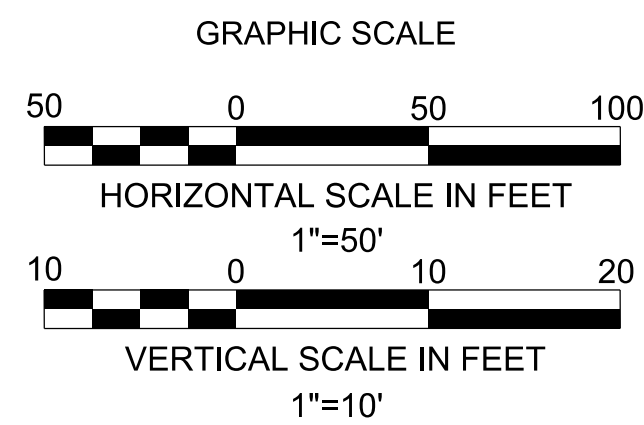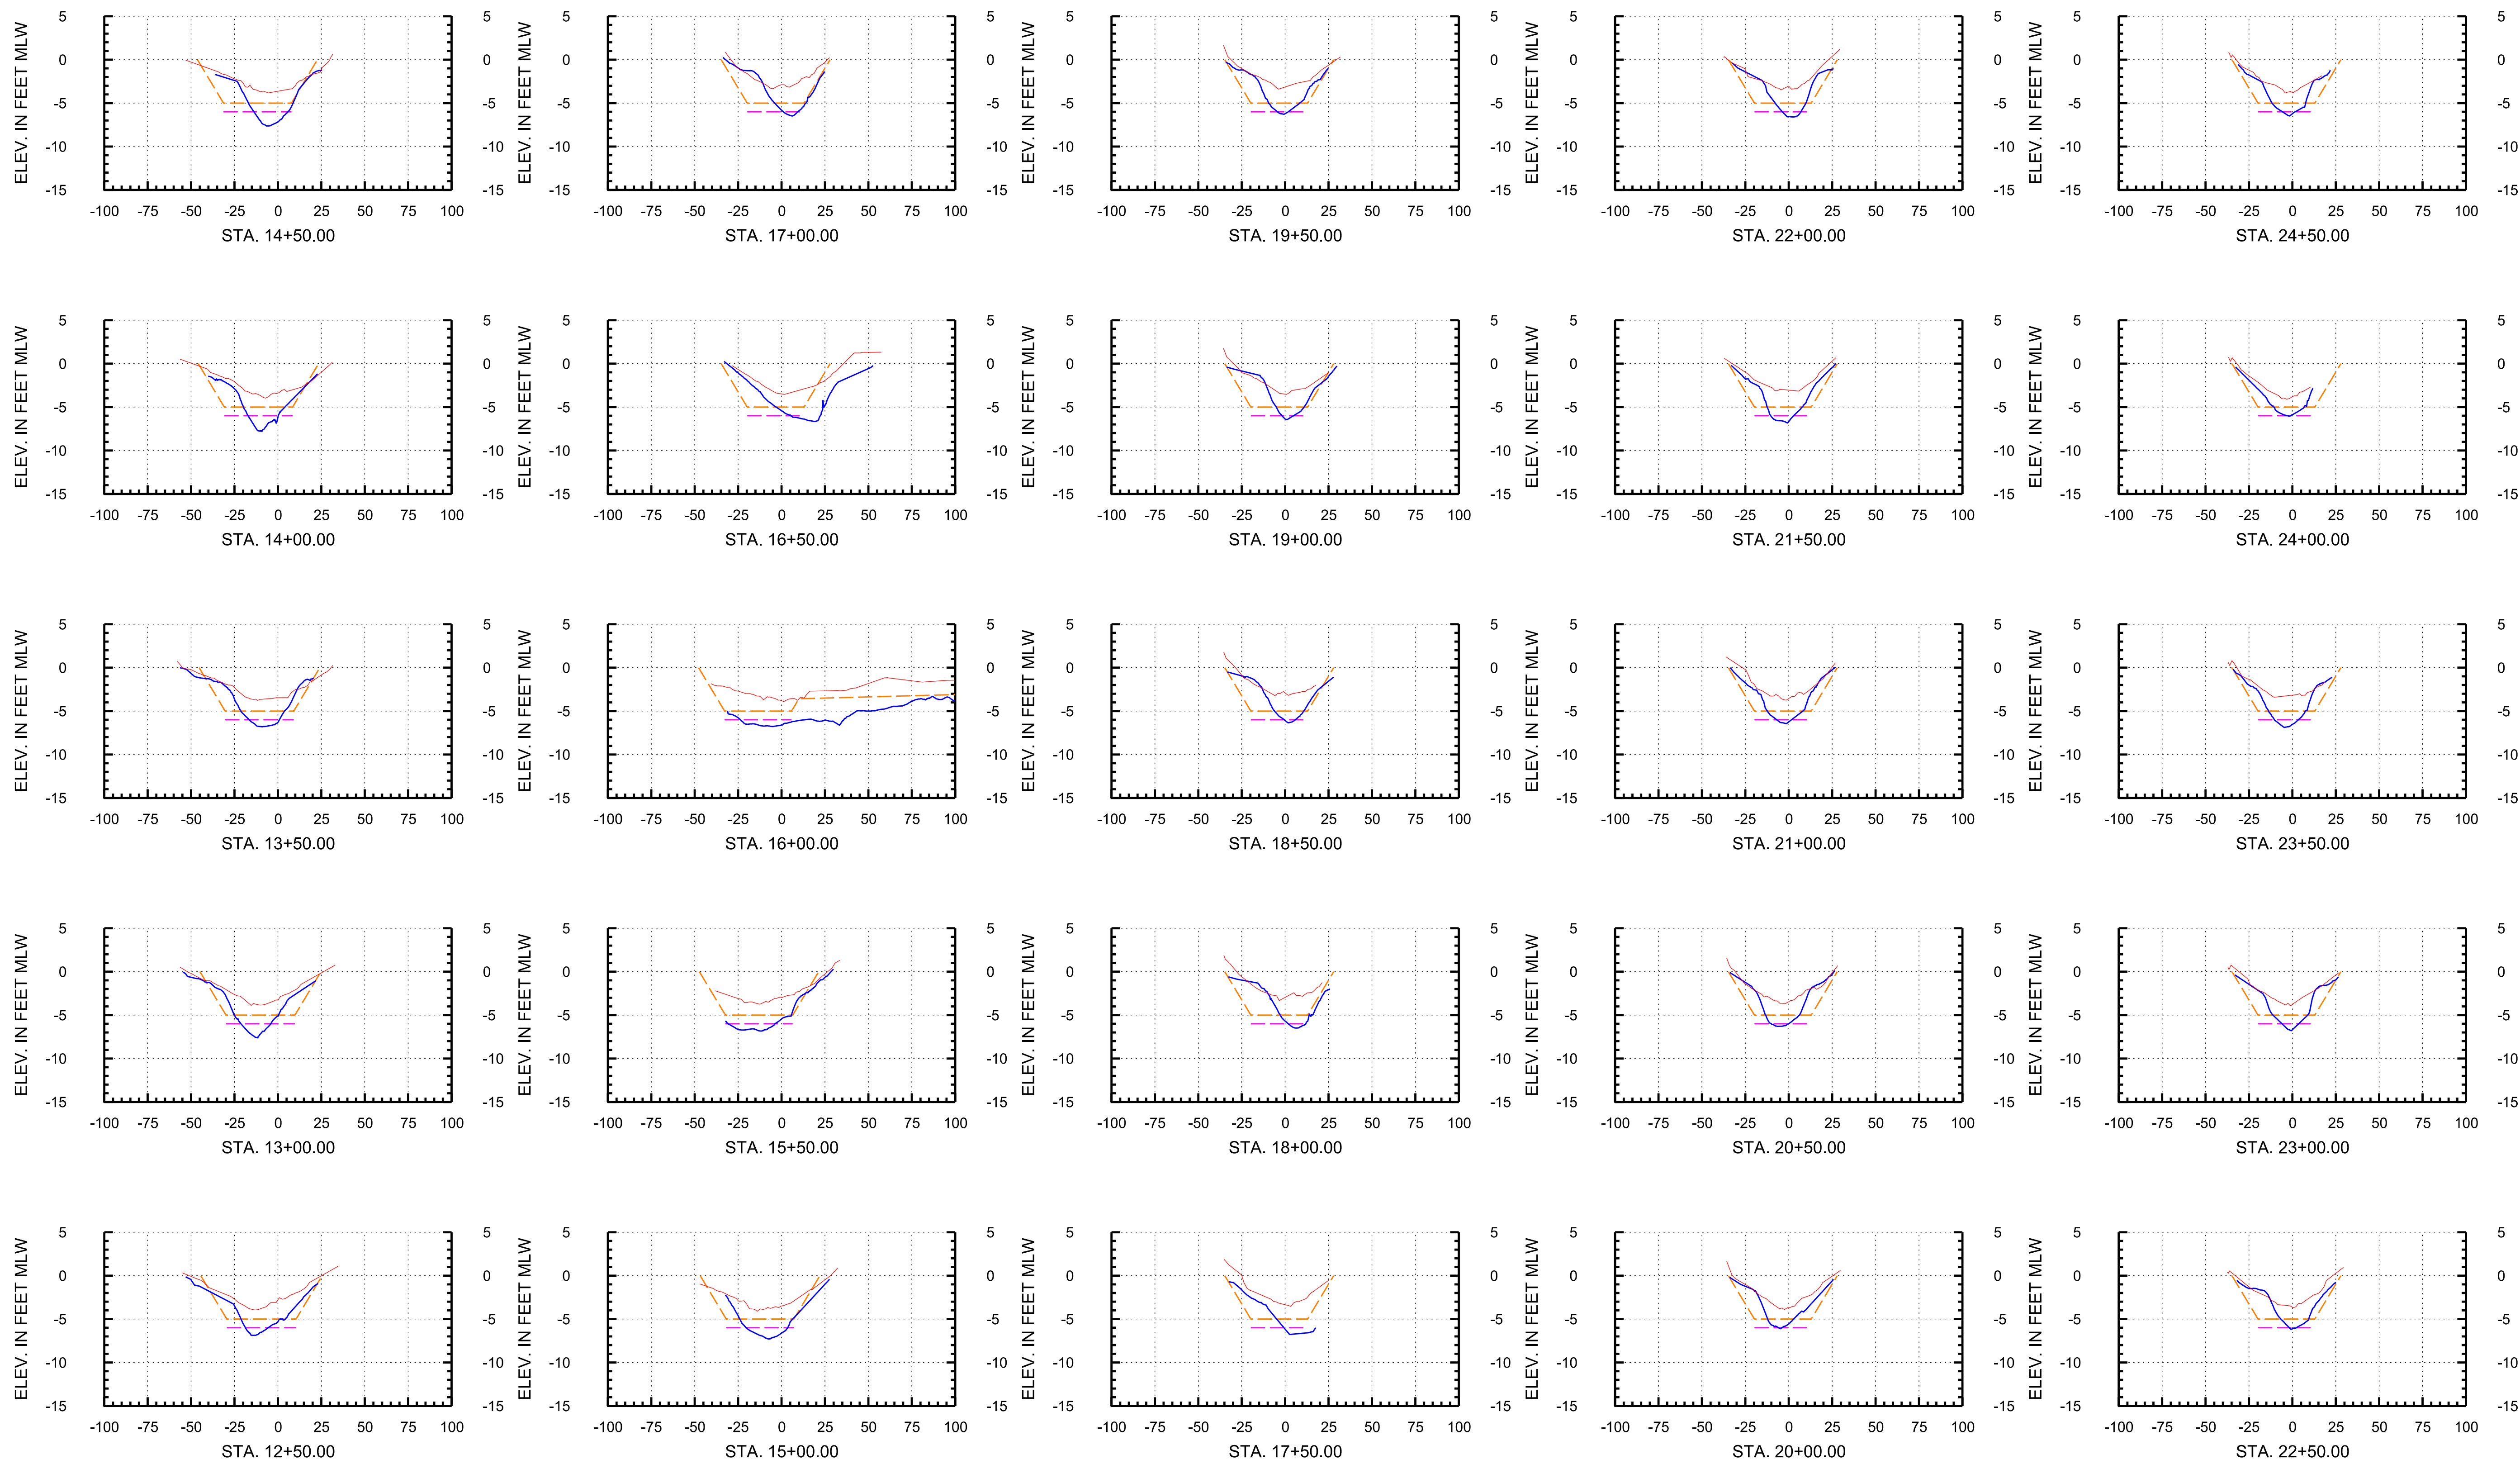

**Arc Surveying & Mapping, Inc.**  
Professional Hydrographers • Surveyors • Mappers  
5202 San Juan Avenue  
Jacksonville, Florida 32210  
904.384.8377

Prepared For:  
**Isle of Palms Special District**  
501 Riverside Avenue  
Jacksonville, FL 32202

Project Title:  
Isle of Palms North  
Hydrographic After-Dredge Survey

— = ARC SURVEY HYDROGRAPHIC SURVEY MARCH 15-29, 2022  
— = ARC SURVEY HYDROGRAPHIC SURVEY JUNE 23-JULY 6, 2020

MLW = MEAN LOW WATER  
STA. = STATION



— = TEMPLATE AT -5' MLW (REVISED PER CLIENT)  
— = TEMPLATE AT -6' MLW (REVISED PER CLIENT)

| DATE | BY | REVISION |
|------|----|----------|
|      |    |          |
|      |    |          |
|      |    |          |
|      |    |          |

LB No. 6487  
Drawn By: D. Trubits  
Scale: see map  
Plot Date: 04/07/22  
File Name:  
Fld Bk / Pg:  
ARC Project No.:  
21-272  
SHEET: 10 OF: 18



# Baseline 2

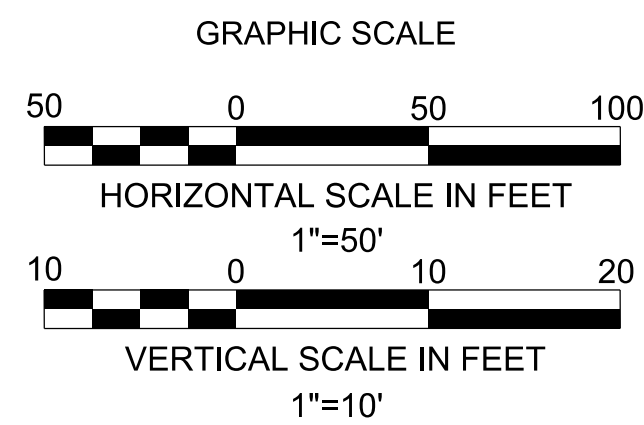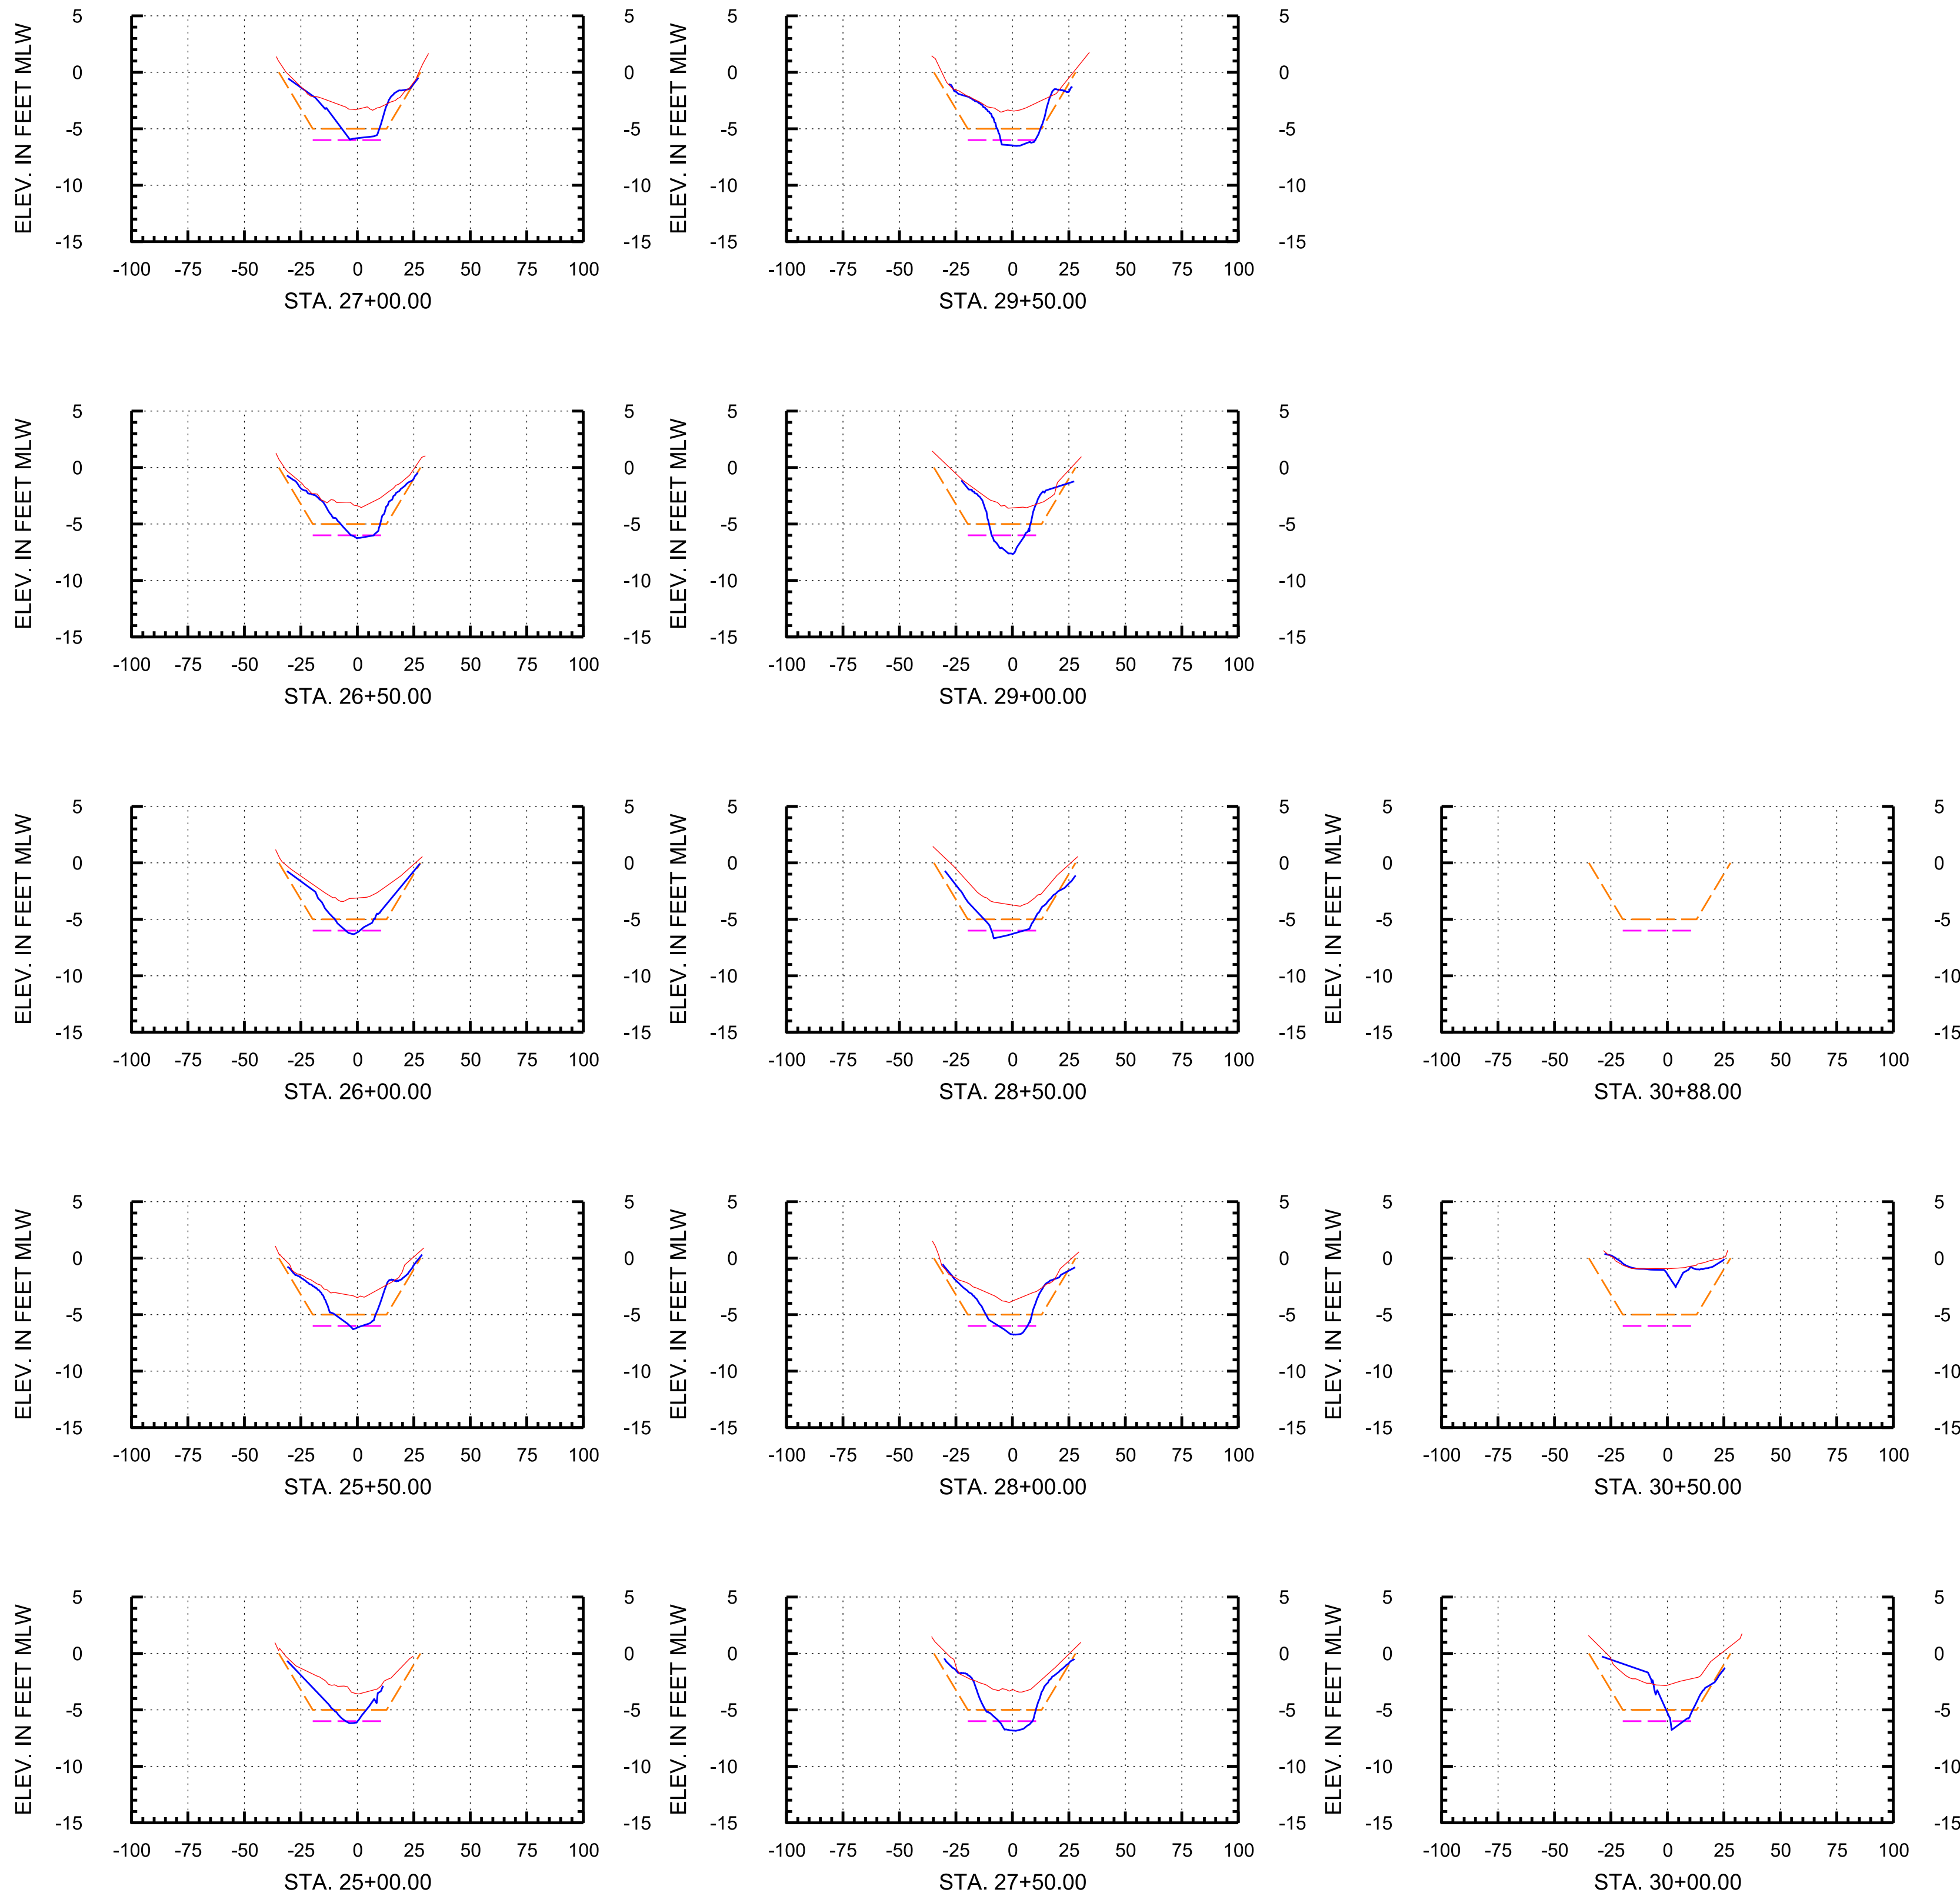

Arc Surveying & Mapping, Inc.  
Professional Hydrographers • Surveyors • Mappers  
5202 San Juan Avenue  
Jacksonville, Florida 32210  
904.384.8377

Prepared For:  
**Isle of Palms Special District**  
501 Riverside Avenue  
Jacksonville, FL 32202

Project Title:  
Isle of Palms North  
Hydrographic After-Dredge Survey

— = ARC SURVEY HYDROGRAPHIC SURVEY MARCH 15-29, 2022  
— = ARC SURVEY HYDROGRAPHIC SURVEY JUNE 23-JULY 6, 2020

MLW = MEAN LOW WATER  
STA. = STATION



— = TEMPLATE AT -5' MLW (REVISED PER CLIENT)  
— = TEMPLATE AT -6' MLW (REVISED PER CLIENT)

|      |    |          |
|------|----|----------|
|      |    |          |
|      |    |          |
|      |    |          |
|      |    |          |
| DATE | BY | REVISION |

|                         |
|-------------------------|
| LB No. 6487             |
| Drawn By: D. Trabis     |
| Scale: see map          |
| Plot Date: 04/07/22     |
| File Name:              |
| Fld Bk / Pg:            |
| ARC Project No.: 21-272 |
| SHEET: 11 OF: 18        |



# Baseline 3

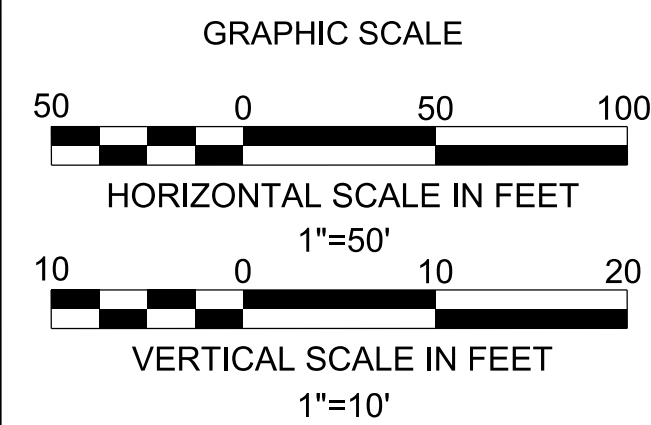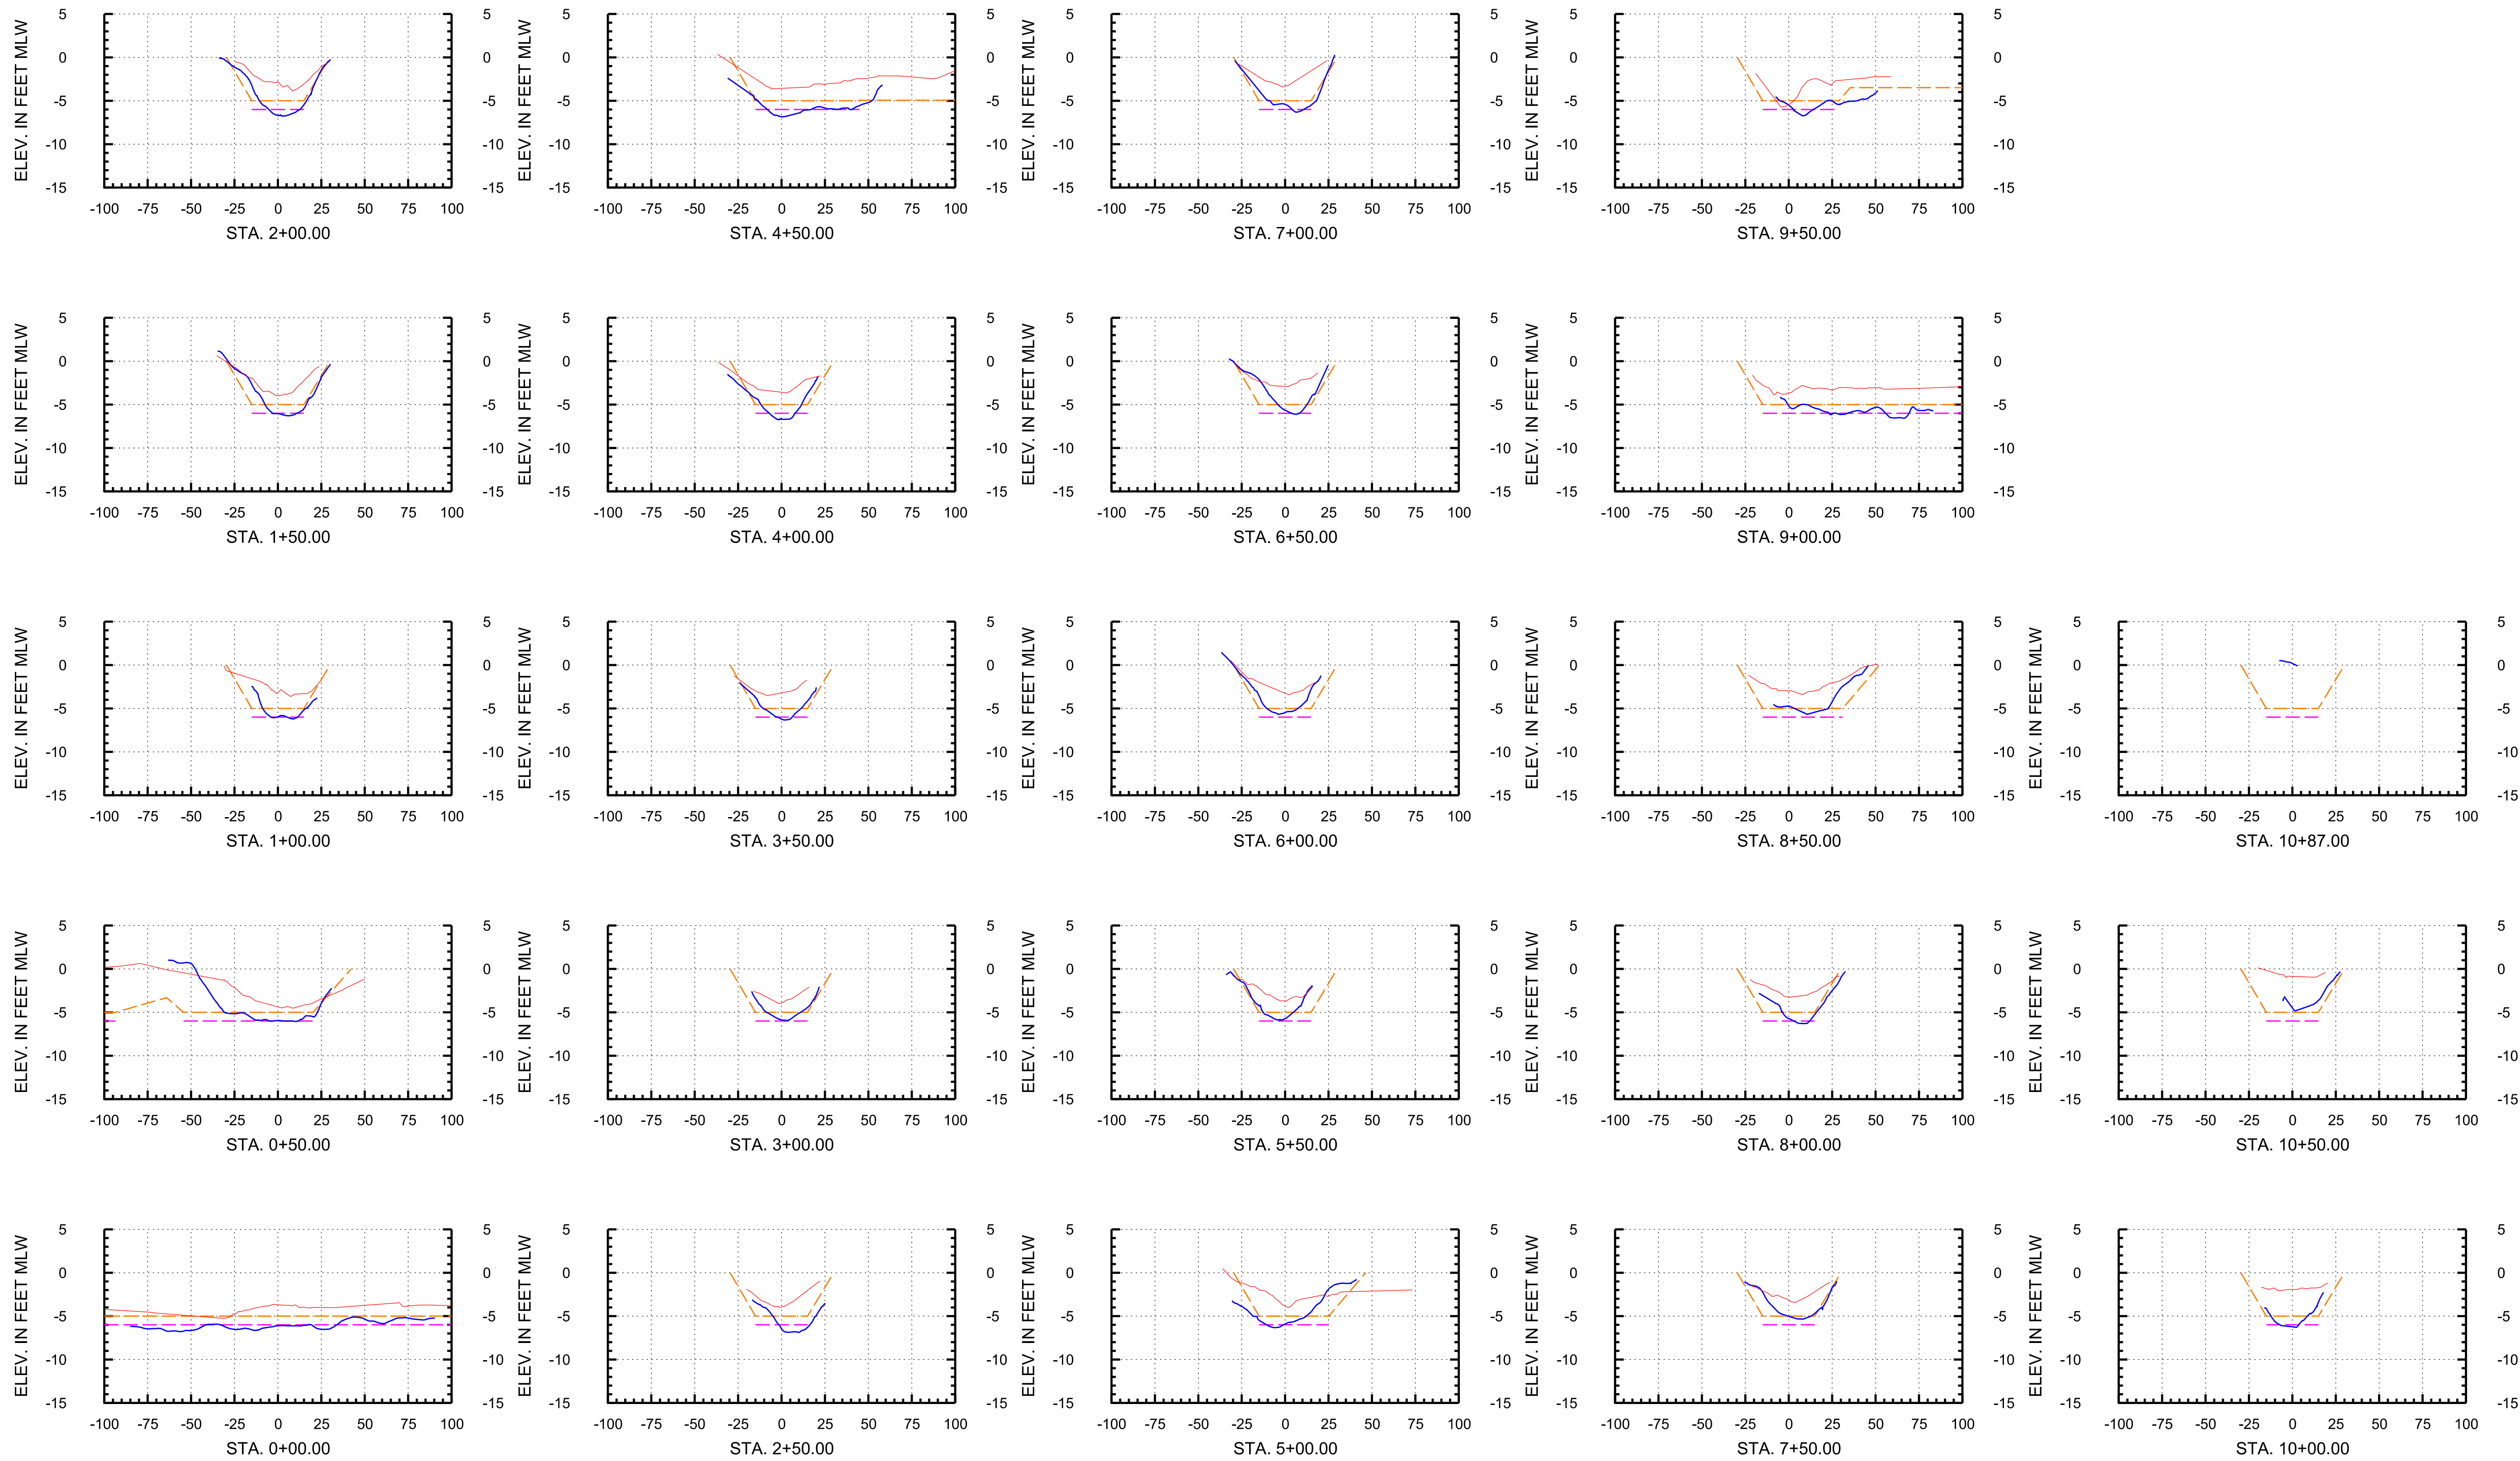

Arc Surveying & Mapping, Inc.  
Professional Hydrographers • Surveyors • Mappers  
5202 San Juan Avenue  
Jacksonville, Florida 32210  
904.384.8377

Prepared For:  
**Isle of Palms Special District**  
501 Riverside Avenue  
Jacksonville, FL 32202

Project Title:  
Isle of Palms North  
Hydrographic After-Dredge Survey

— = ARC SURVEY HYDROGRAPHIC SURVEY MARCH 15-29, 2022  
— = ARC SURVEY HYDROGRAPHIC SURVEY JUNE 23-JULY 6, 2020

MLW = MEAN LOW WATER  
STA. = STATION



— = TEMPLATE AT -5' MLW (REVISED PER CLIENT)  
— = TEMPLATE AT -6' MLW (REVISED PER CLIENT)

| DATE | BY | REVISION |
|------|----|----------|
|      |    |          |
|      |    |          |
|      |    |          |
|      |    |          |

LB No. 6487  
Drawn By: D. Trabits  
Scale: see map  
Plot Date: 04/07/22  
File Name:  
Fld Bk / Pg:  
ARC Project No.:  
21-272  
SHEET: 12 OF: 18



# Baseline 4

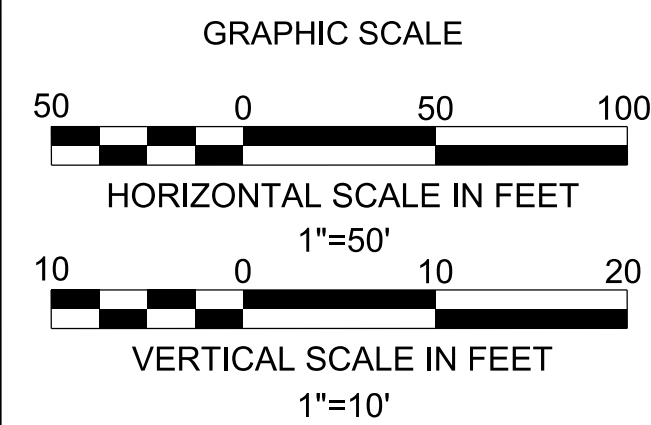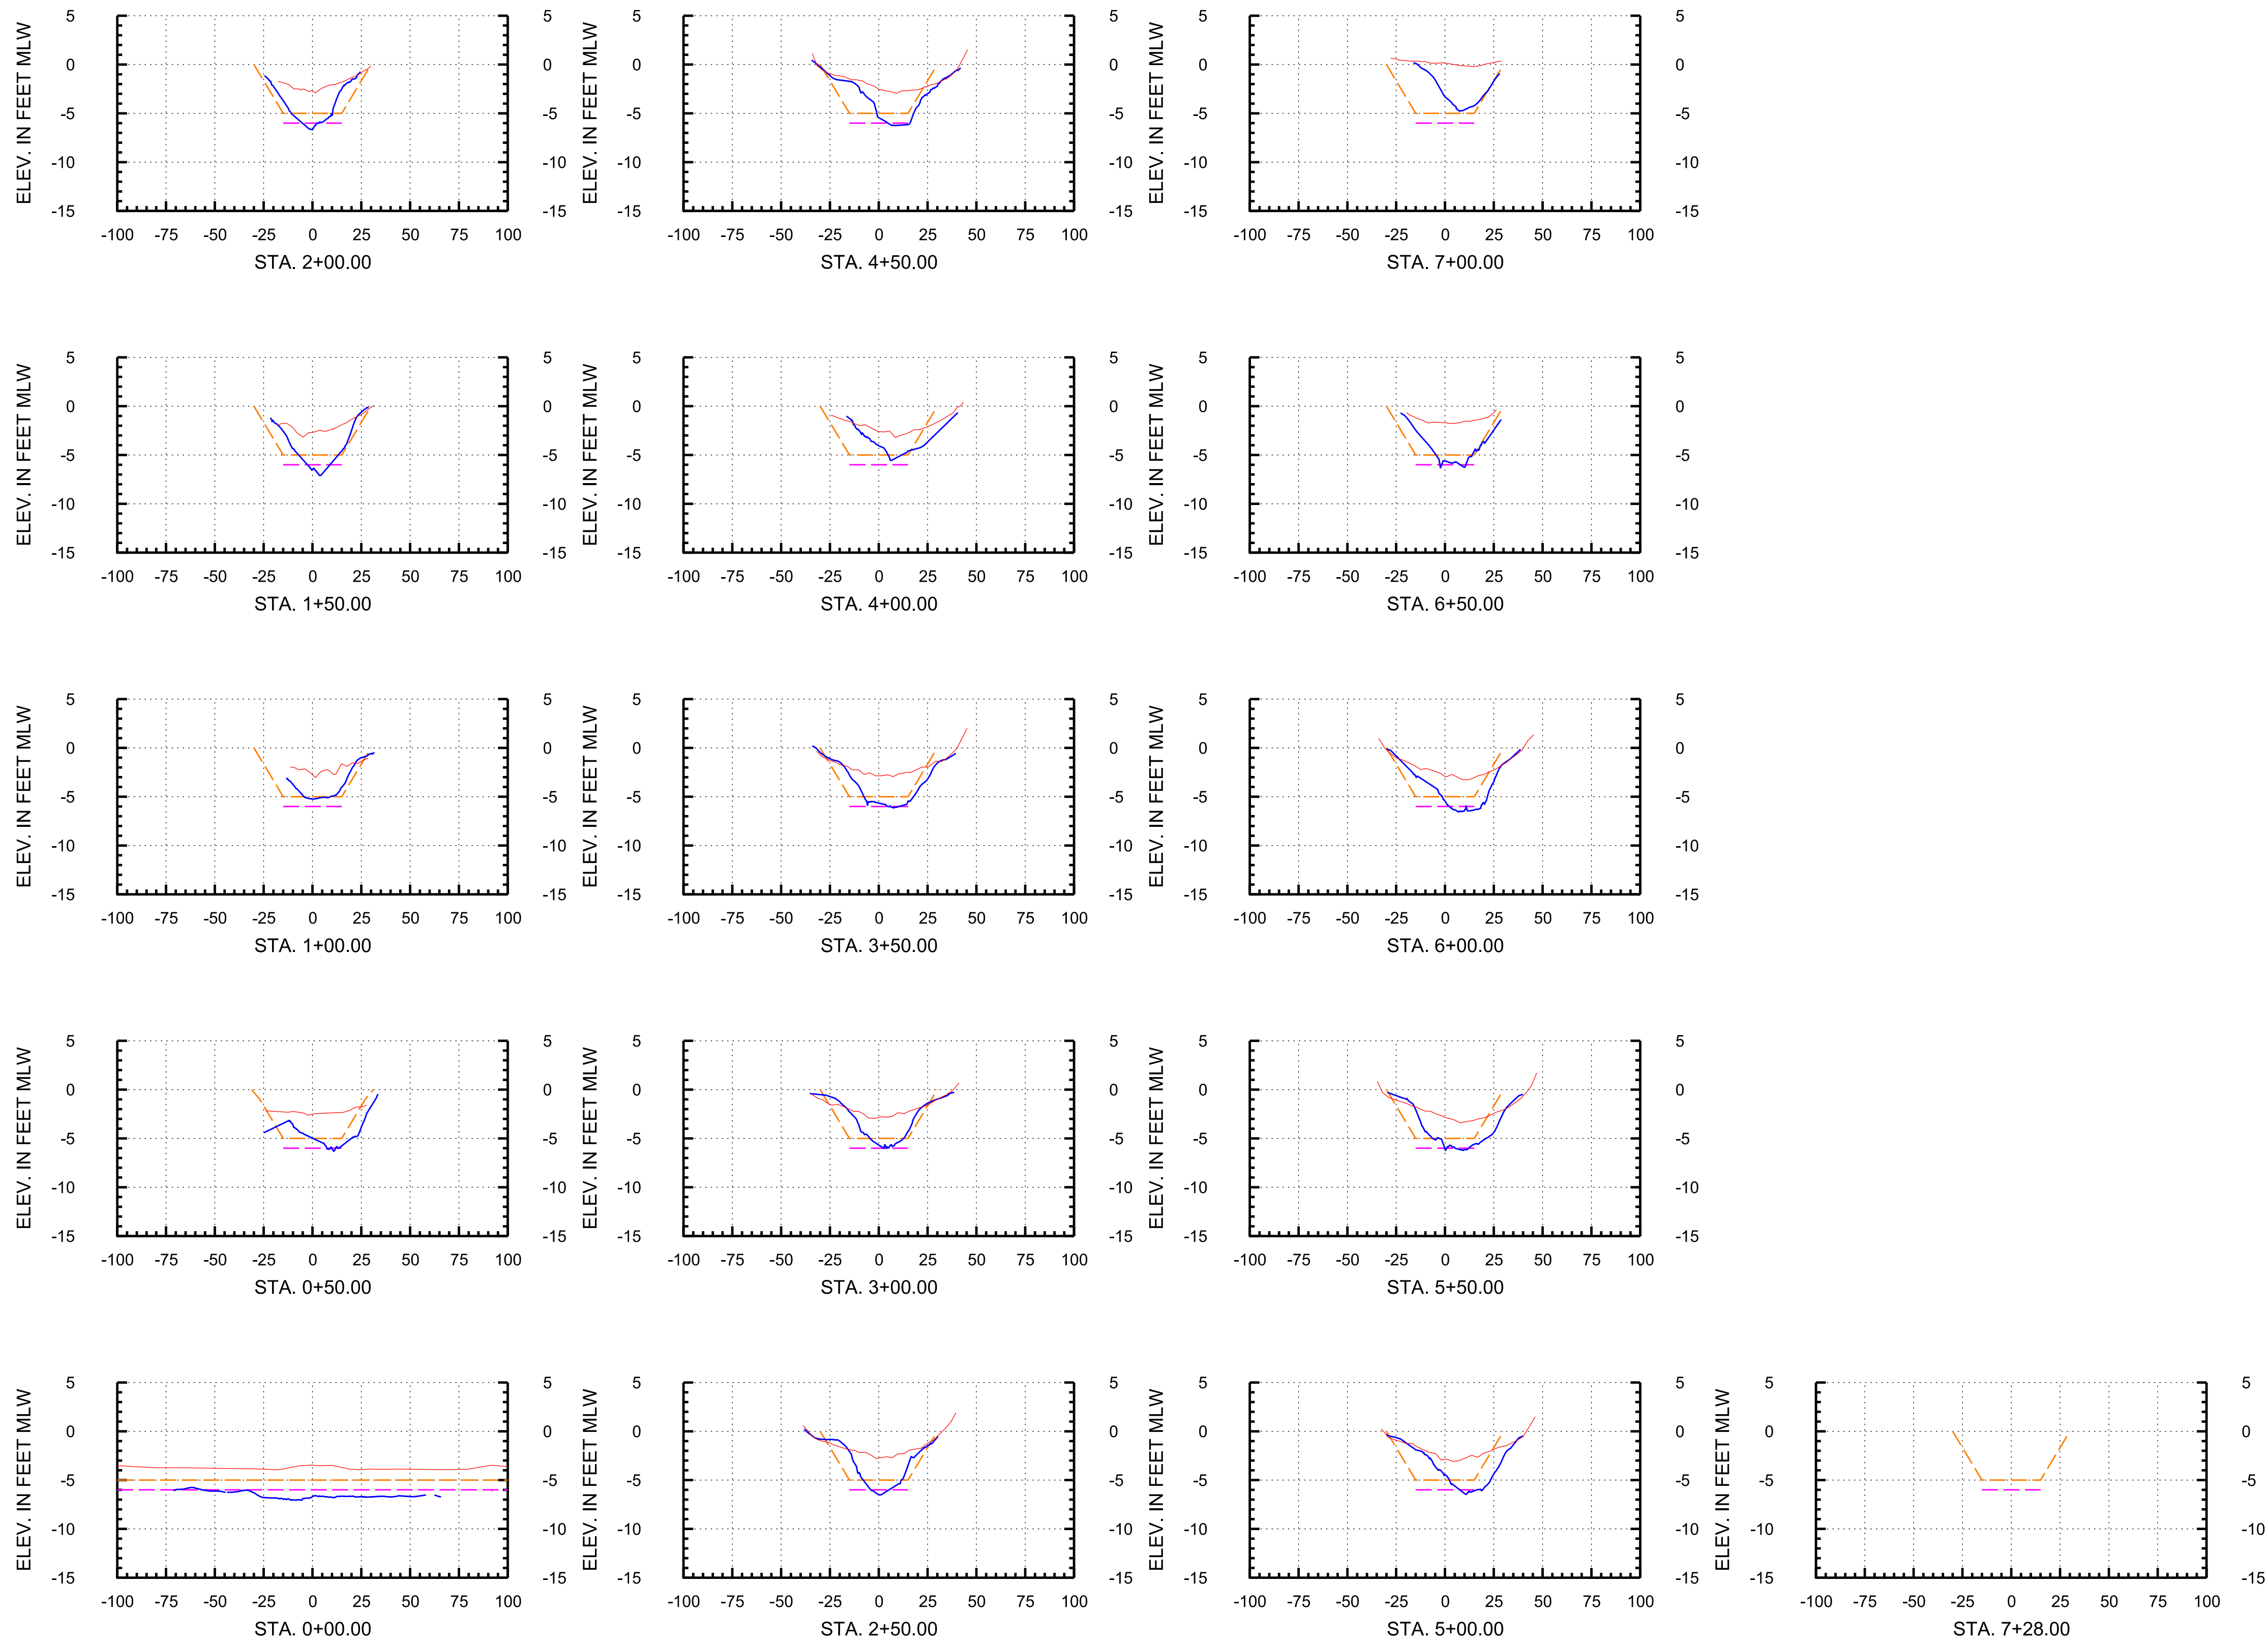

**Arc Surveying & Mapping, Inc.**  
Professional Hydrographers • Surveyors • Mappers  
5202 San Juan Avenue  
Jacksonville, Florida 32210  
904.384.8377

Prepared For:  
**Isle of Palms Special District**  
501 Riverside Avenue  
Jacksonville, FL 32202

Project Title:  
**Isle of Palms North  
Hydrographic After-Dredge Survey**

— = ARC SURVEY HYDROGRAPHIC SURVEY MARCH 15-29, 2022  
— = ARC SURVEY HYDROGRAPHIC SURVEY JUNE 23-JULY 6, 2020

MLW = MEAN LOW WATER  
STA. = STATION



— = TEMPLATE AT -5' MLW (REVISED PER CLIENT)  
— = TEMPLATE AT -6' MLW (REVISED PER CLIENT)

| DATE | BY | REVISION |
|------|----|----------|
|      |    |          |
|      |    |          |
|      |    |          |
|      |    |          |

LB No. 6487  
Drawn By: D. Trabits  
Scale: see map  
Plot Date: 04/07/22  
File Name:  
Fld Bk / Pg:  
ARC Project No.:  
21-272  
SHEET: 13 OF: 18



# Baseline 5

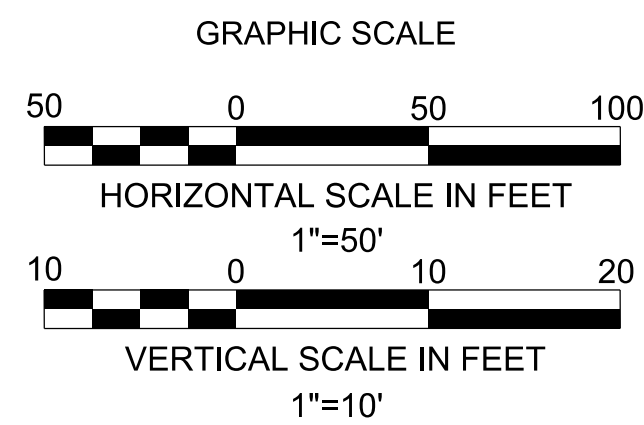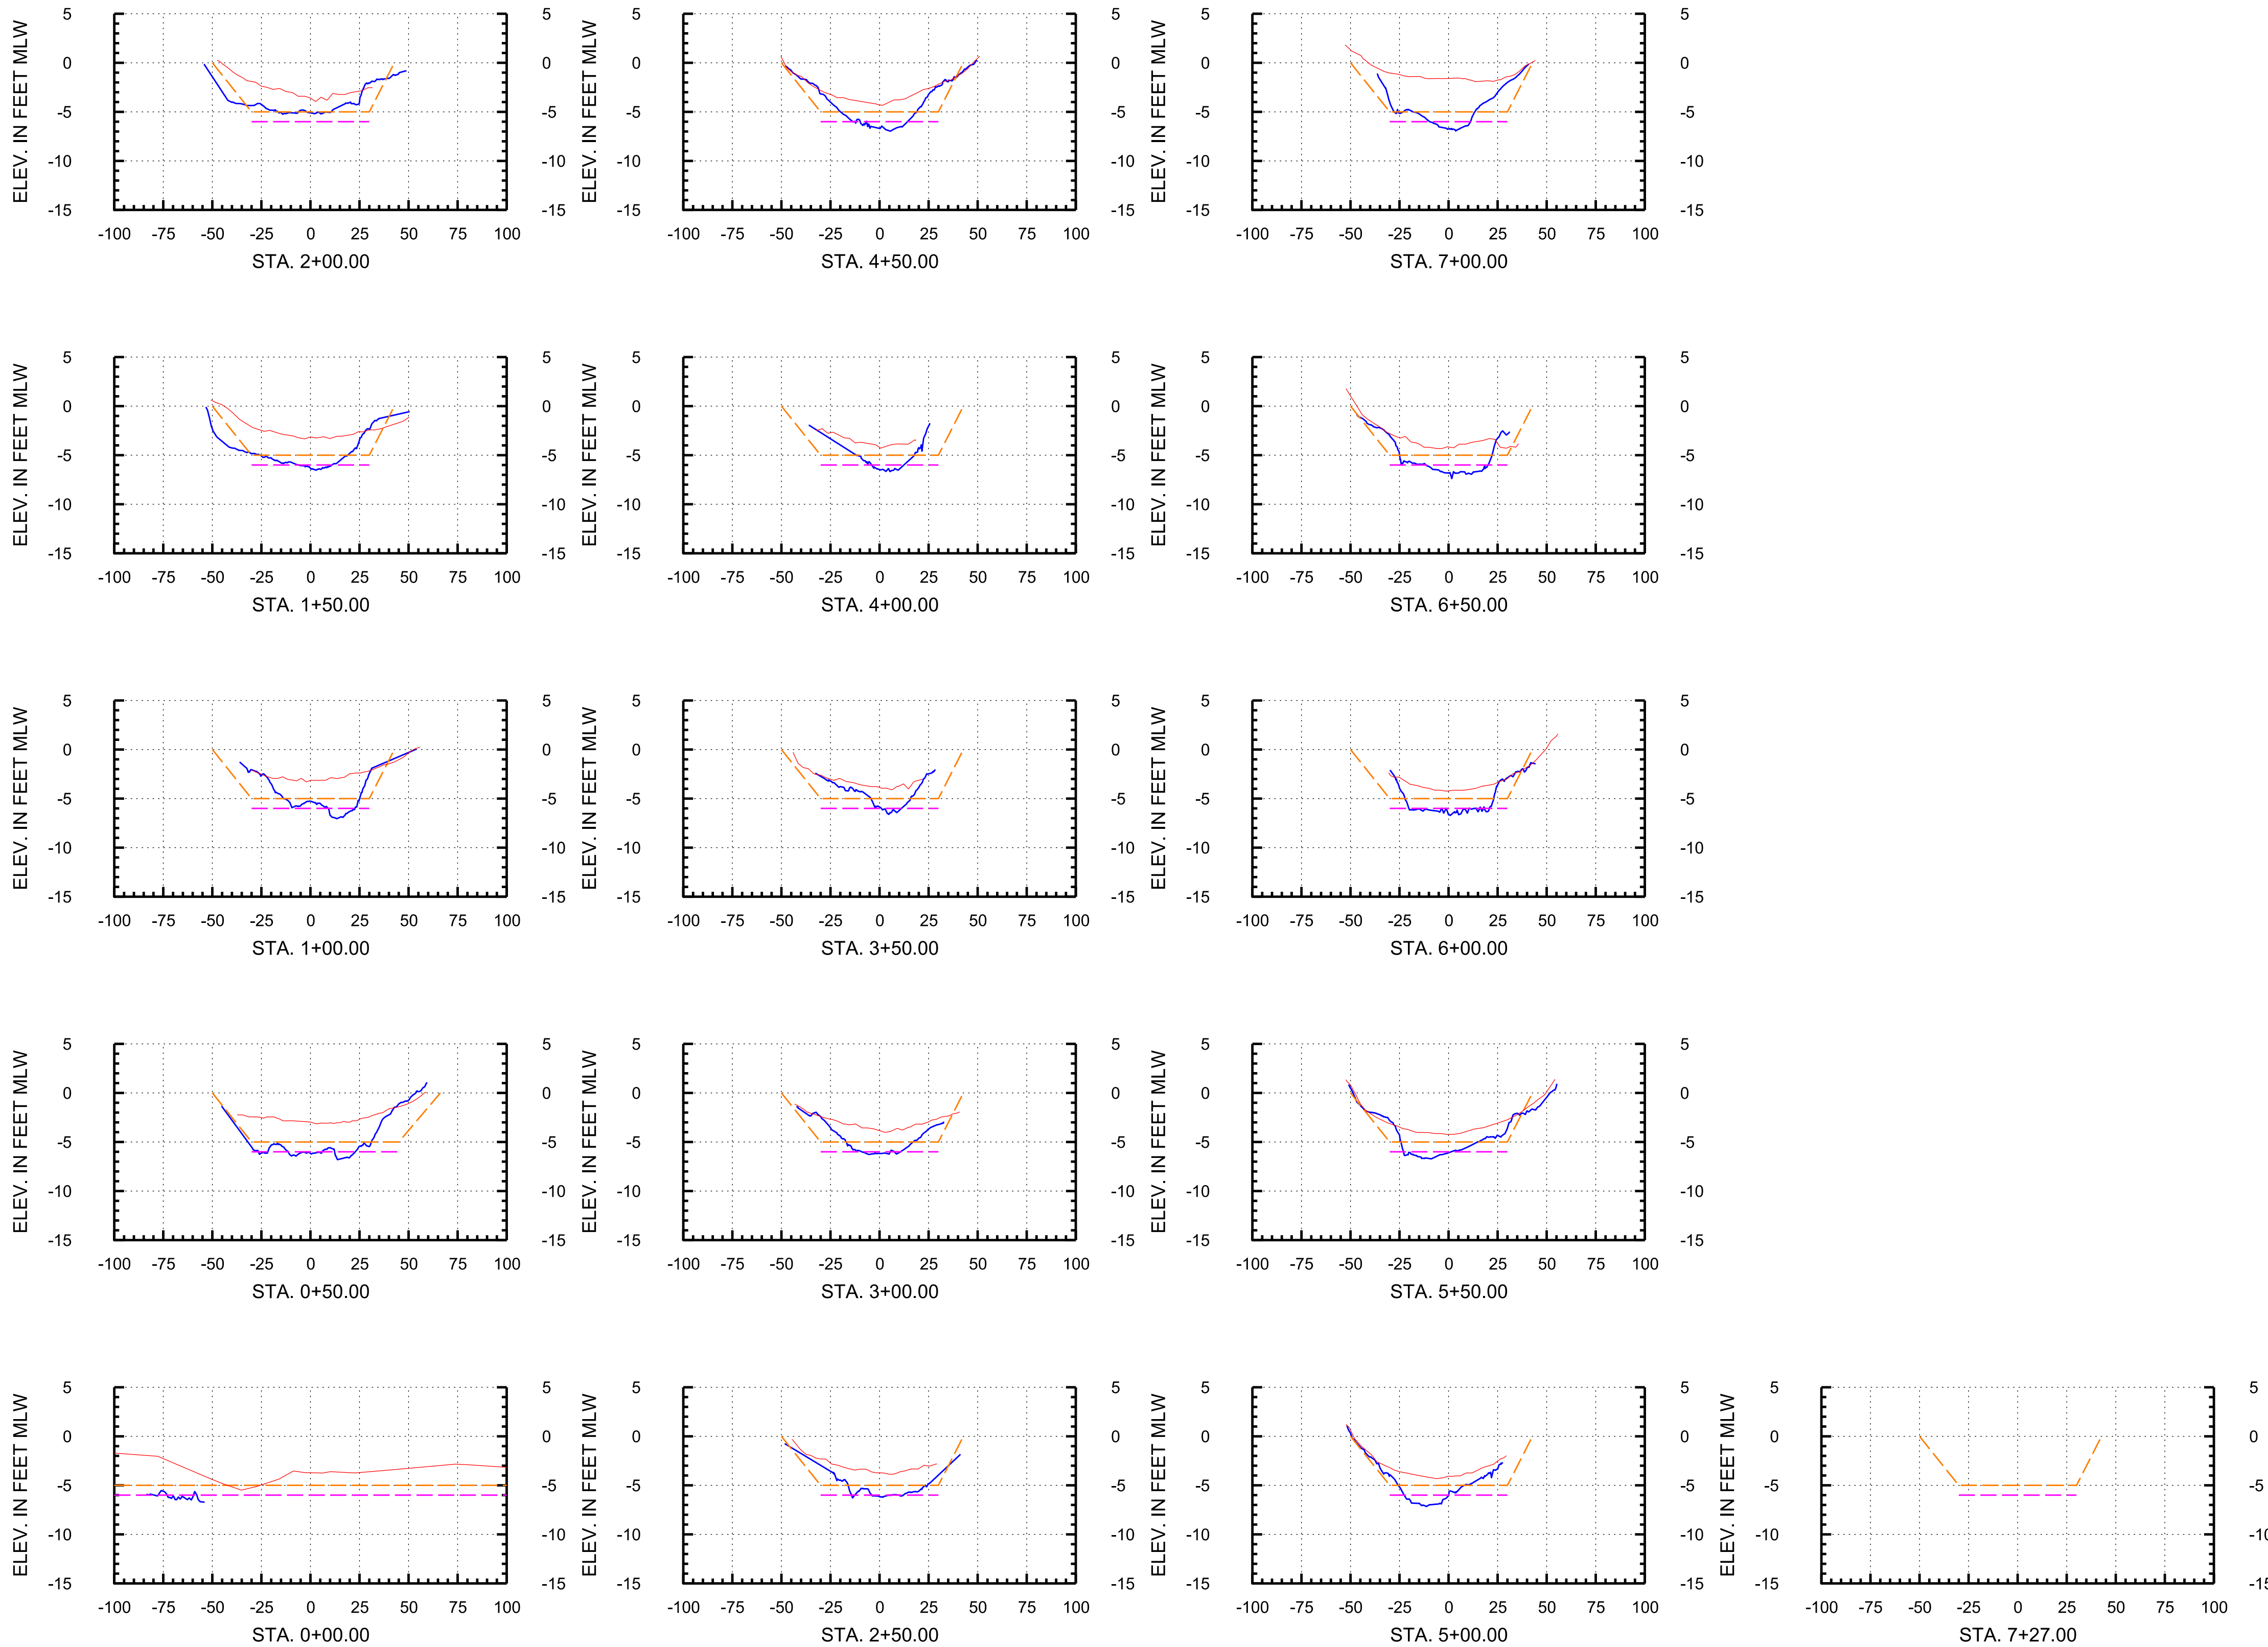

**Arc Surveying & Mapping, Inc.**  
Professional Hydrographers • Surveyors • Mappers  
5202 San Juan Avenue  
Jacksonville, Florida 32210  
904.384.8377

Prepared For:  
**Isle of Palms Special District**  
501 Riverside Avenue  
Jacksonville, FL 32202

Project Title:  
**Isle of Palms North  
Hydrographic After-Dredge Survey**

— = ARC SURVEY HYDROGRAPHIC SURVEY MARCH 15-29, 2022  
— = ARC SURVEY HYDROGRAPHIC SURVEY JUNE 23-JULY 6, 2020

MLW = MEAN LOW WATER  
STA. = STATION



— = TEMPLATE AT -5' MLW (REVISED PER CLIENT)  
- - - = TEMPLATE AT -6' MLW (REVISED PER CLIENT)

| DATE | BY | REVISION |
|------|----|----------|
|      |    |          |
|      |    |          |
|      |    |          |
|      |    |          |

LB No. 6487  
Drawn By: D. Trabits  
Scale: see map  
Plot Date: 04/07/22  
File Name:  
Fld Bk / Pg:  
ARC Project No.:  
21-272  
SHEET: 14 OF: 18



# Baseline 6

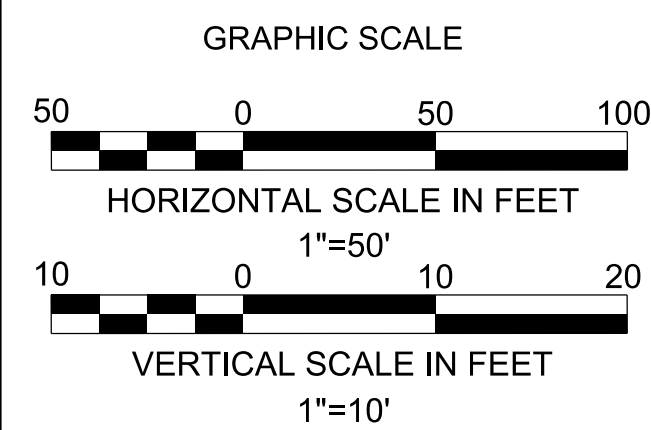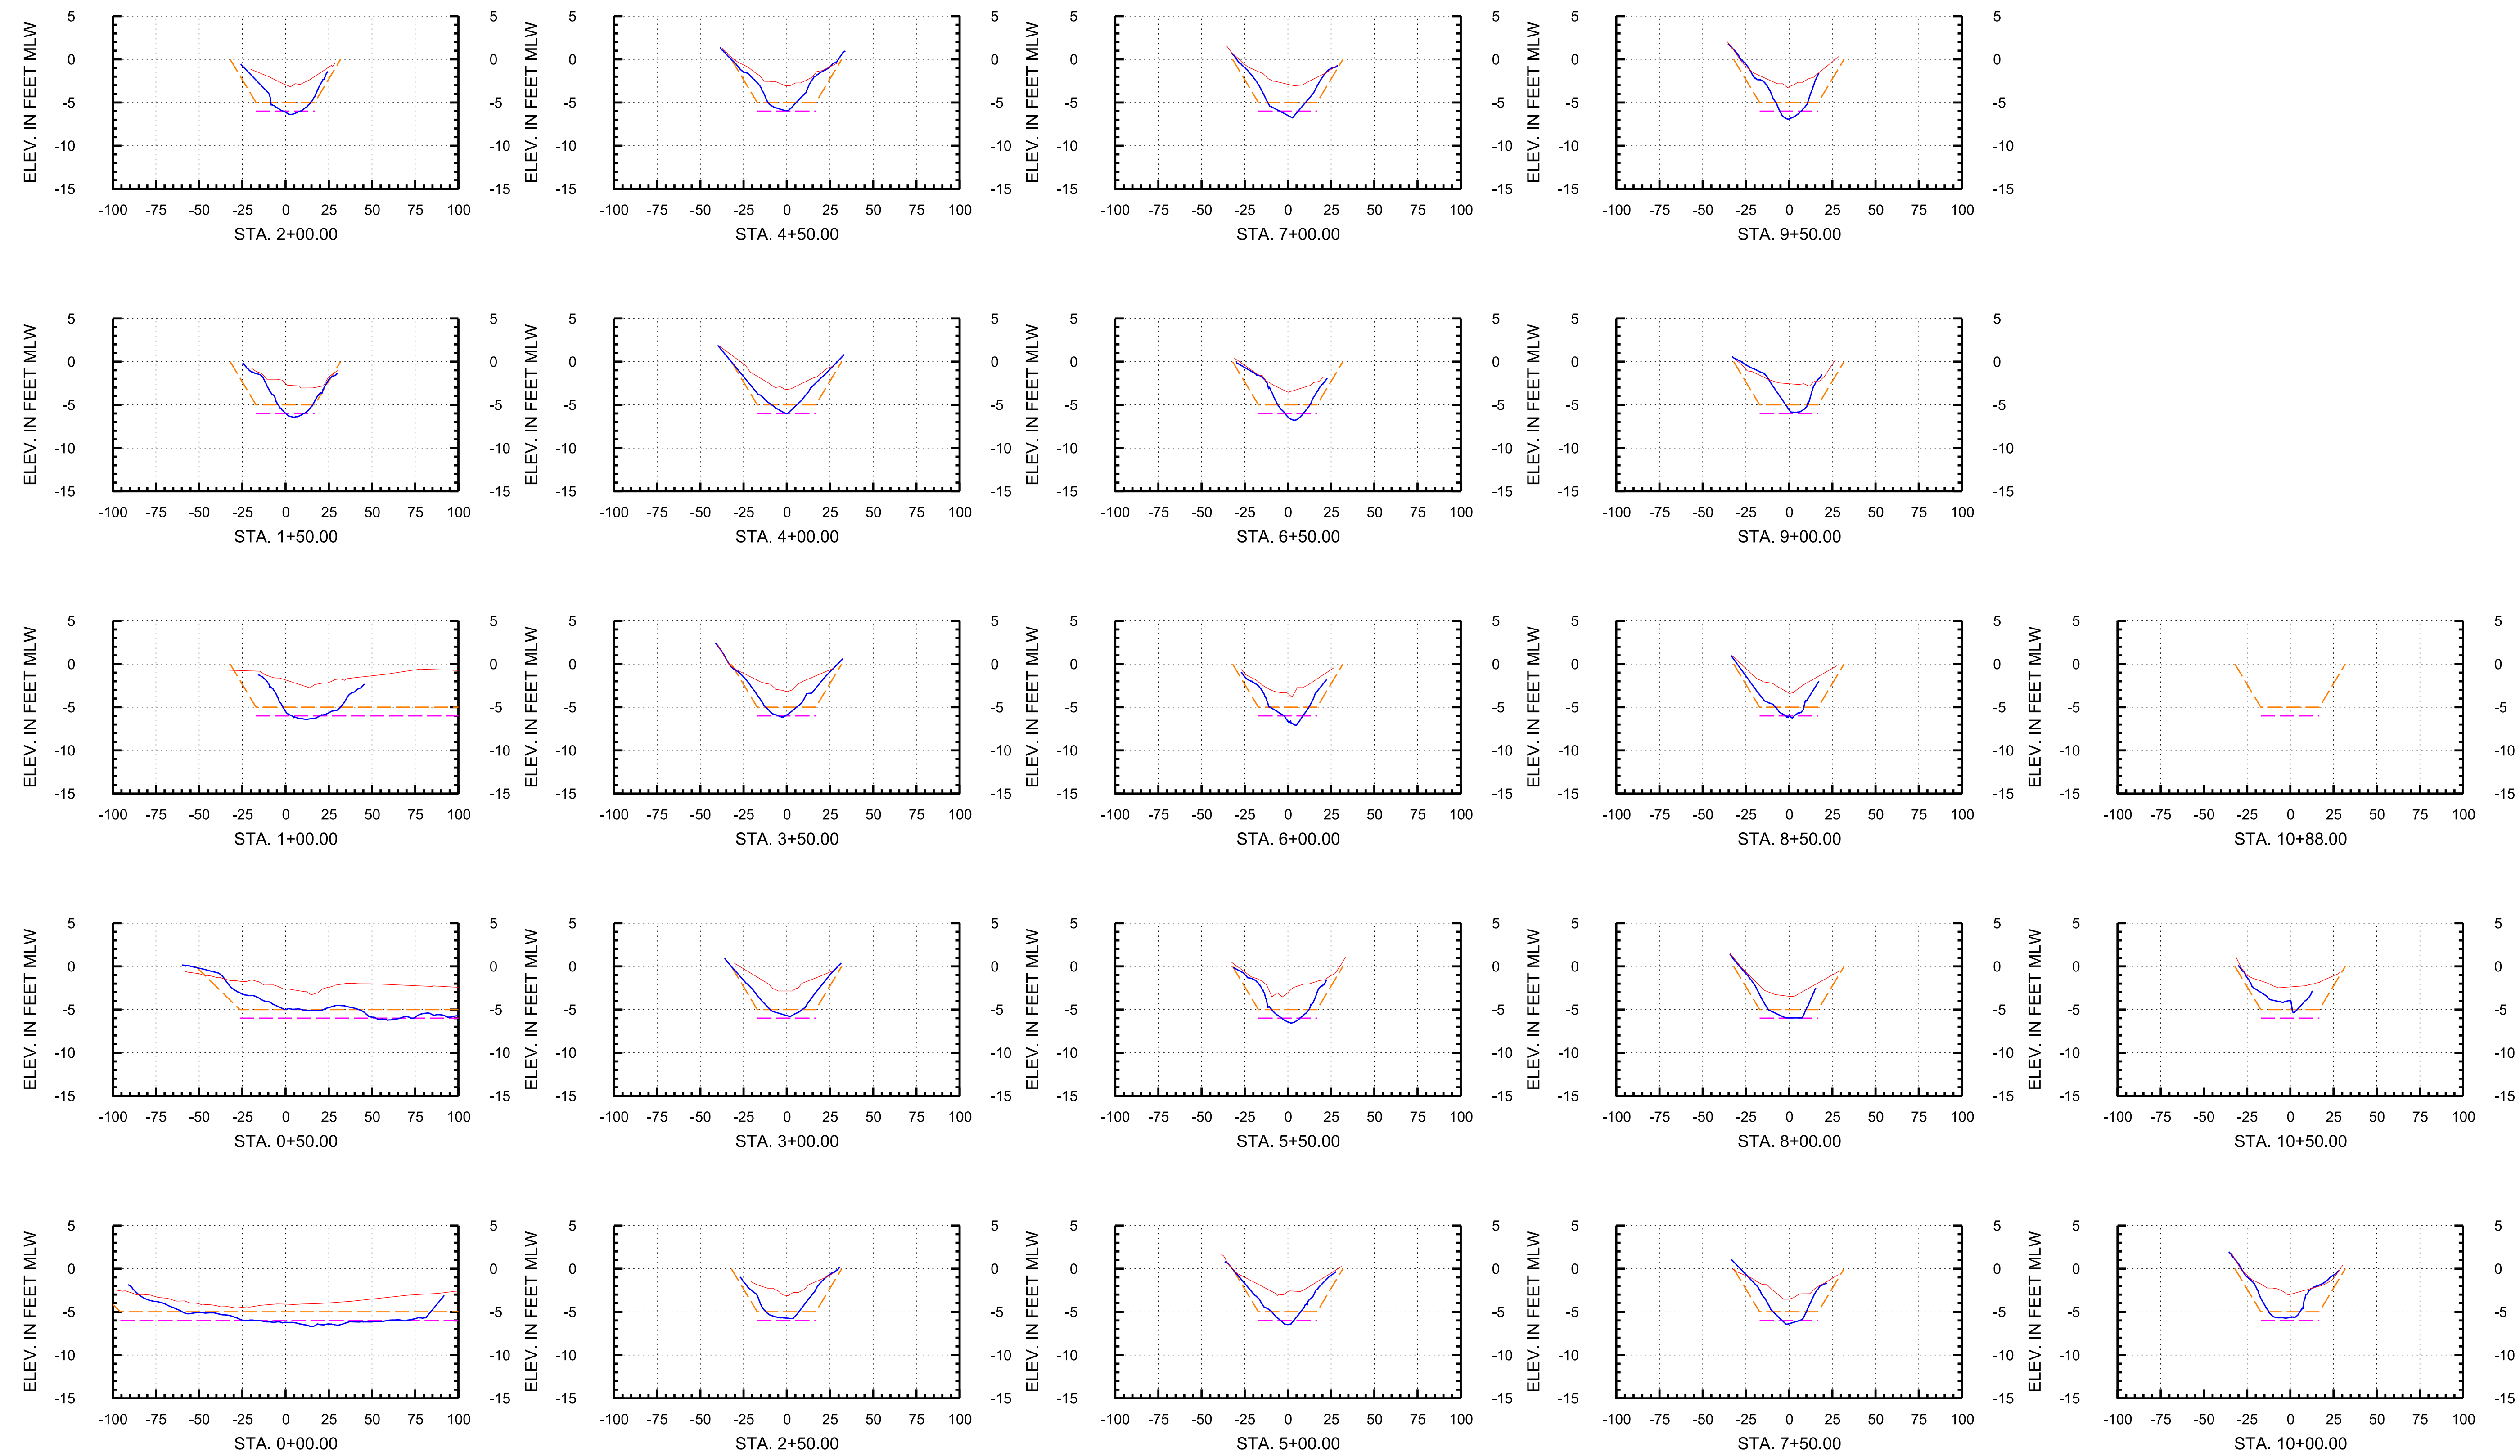

Arc Surveying & Mapping, Inc.  
Professional Hydrographers • Surveyors • Mappers  
5202 San Juan Avenue  
Jacksonville, Florida 32210  
904.384.8377

Prepared For:  
**Isle of Palms Special District**  
501 Riverside Avenue  
Jacksonville, FL 32202

Project Title:  
Isle of Palms North  
Hydrographic After-Dredge Survey

— = ARC SURVEY HYDROGRAPHIC SURVEY MARCH 15-29, 2022  
— = ARC SURVEY HYDROGRAPHIC SURVEY JUNE 23-JULY 6, 2020

MLW = MEAN LOW WATER  
STA. = STATION



— = TEMPLATE AT -5' MLW (REVISED PER CLIENT)  
— = TEMPLATE AT -6' MLW (REVISED PER CLIENT)

| DATE | BY | REVISION |
|------|----|----------|
|      |    |          |
|      |    |          |
|      |    |          |
|      |    |          |

LB No. 6487  
Drawn By: D. Trabis  
Scale: see map  
Plot Date: 04/07/22  
File Name:  
Fld Bk / Pg:  
ARC Project No.:  
21-272  
SHEET: 15 OF: 18



# Baseline 7

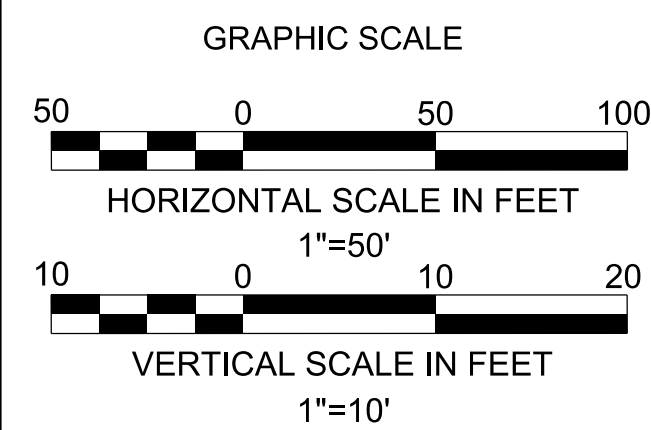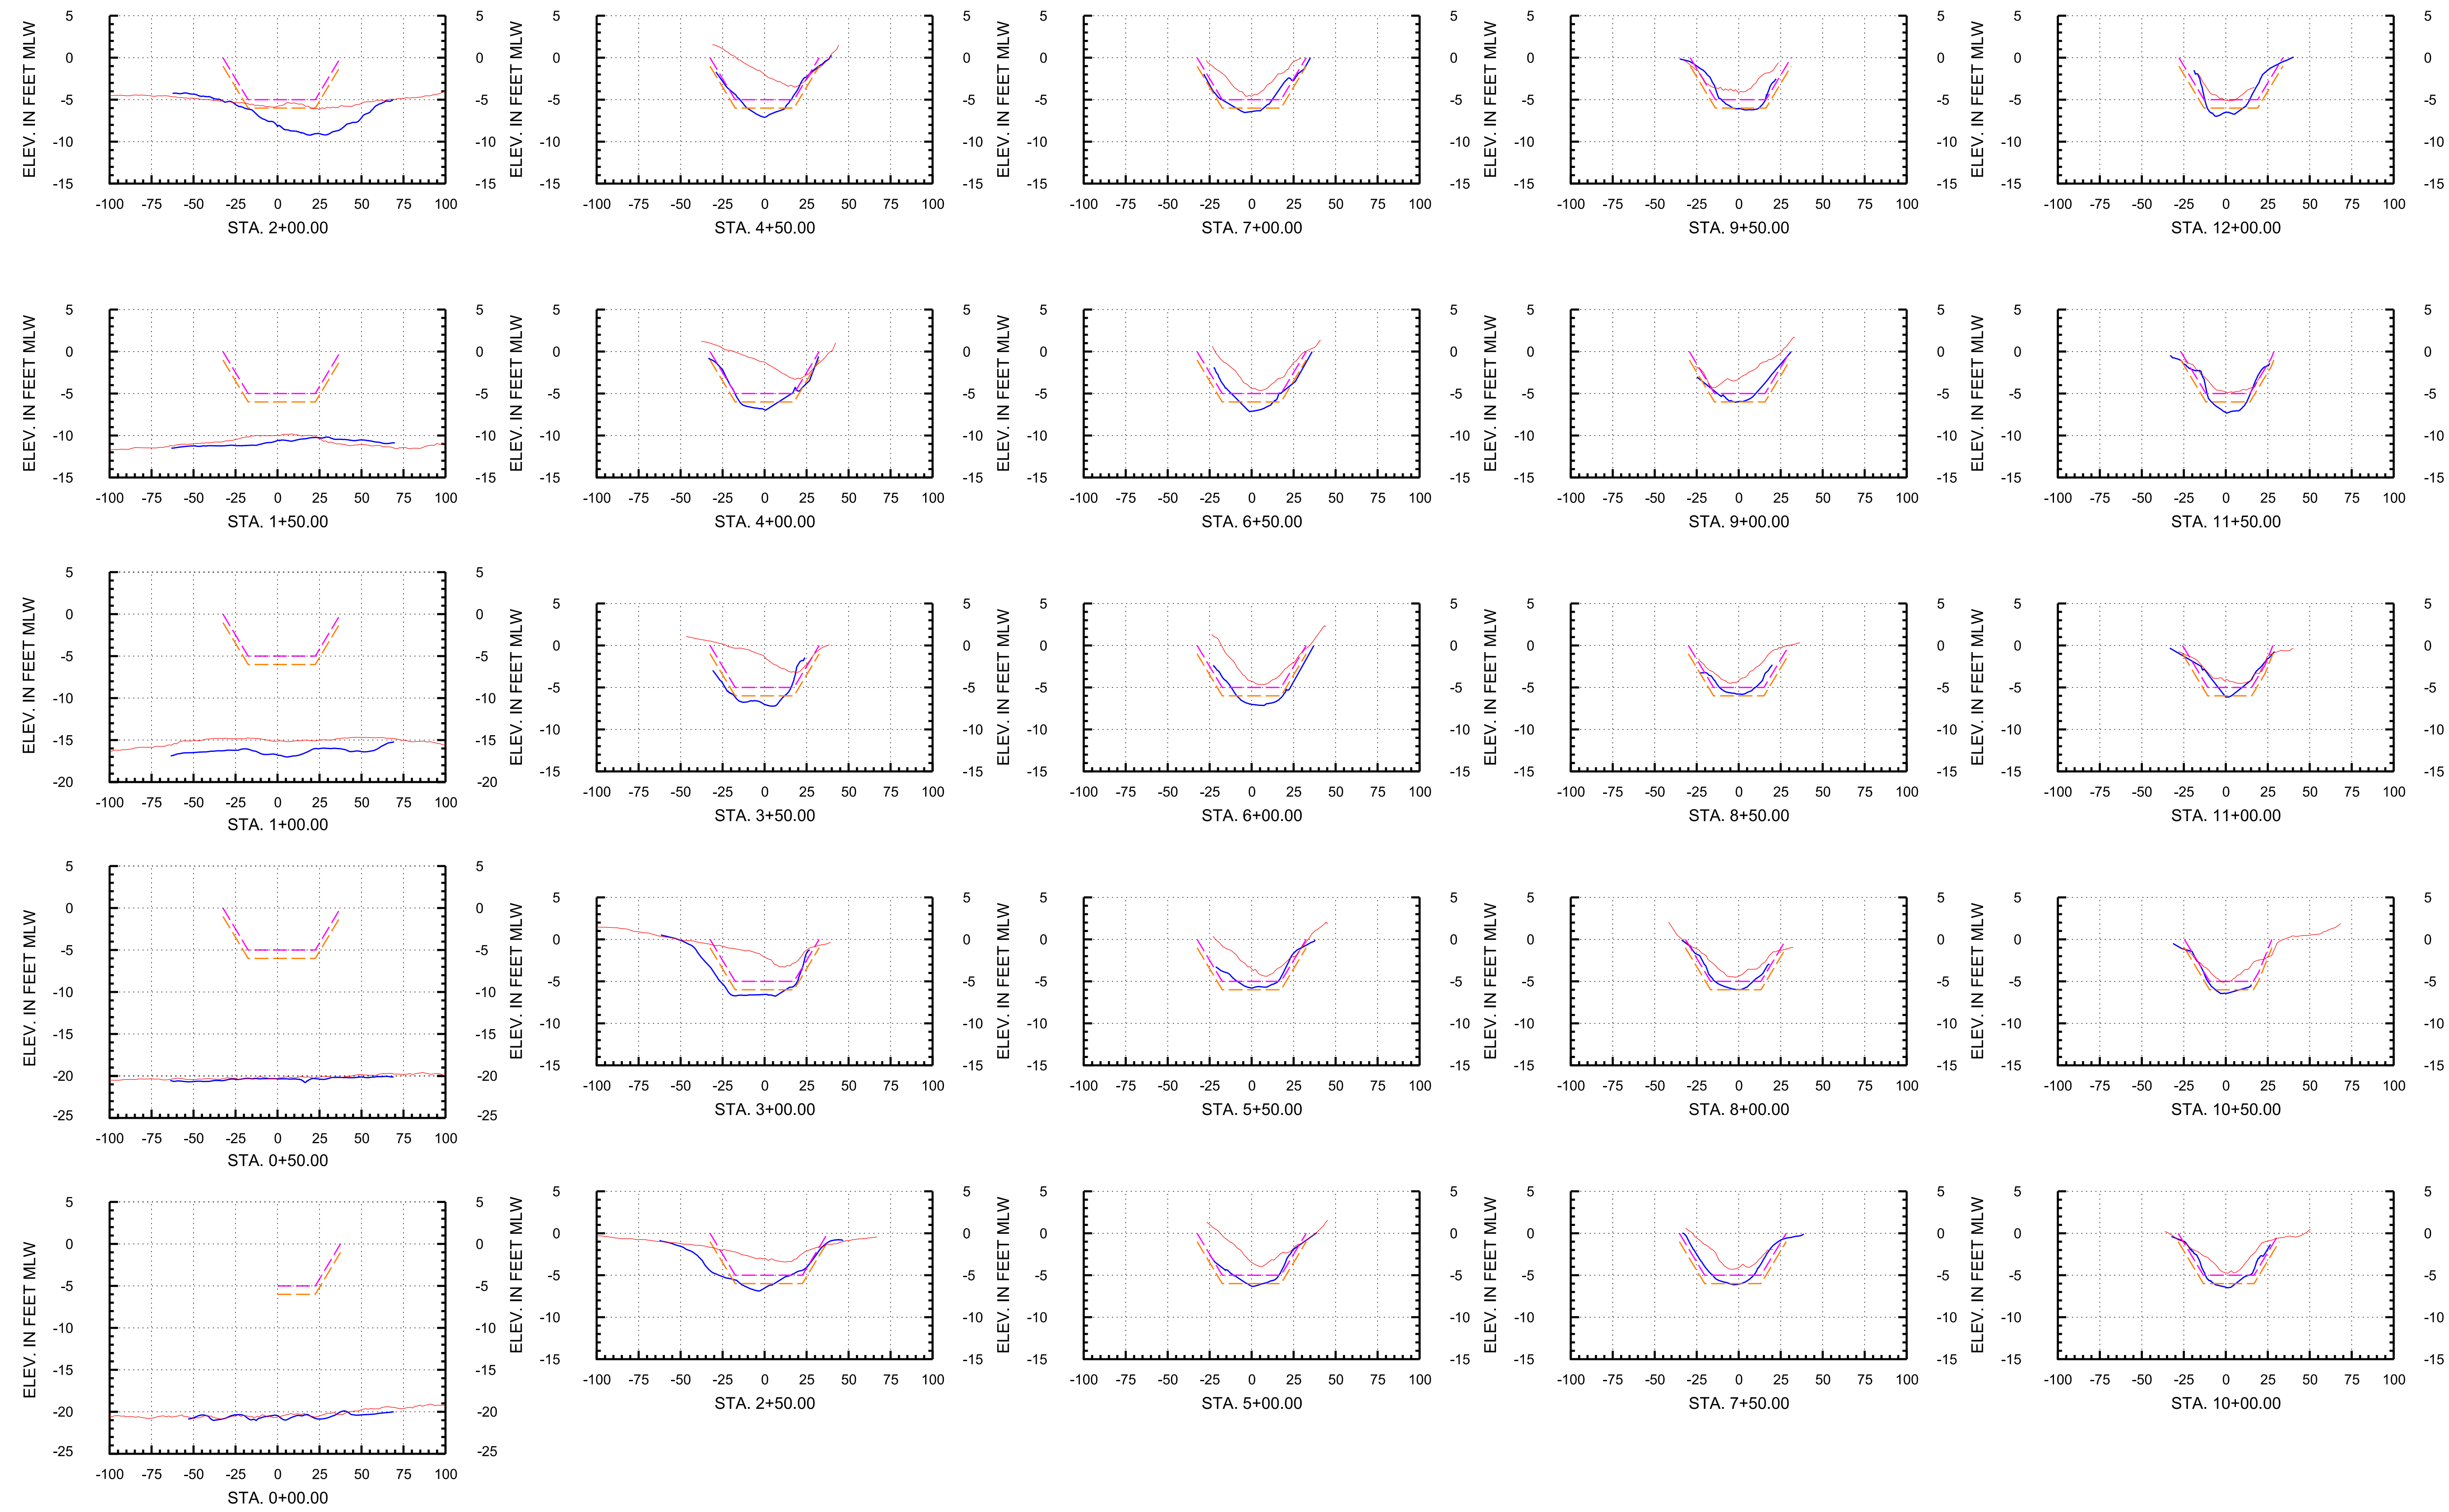

**Arc Surveying & Mapping, Inc.**  
Professional Hydrographers • Surveyors • Mappers  
5202 San Juan Avenue  
Jacksonville, Florida 32210  
904.384.8377

Prepared For:  
**Isle of Palms Special District**  
501 Riverside Avenue  
Jacksonville, FL 32202

Project Title:  
Isle of Palms North  
Hydrographic After-Dredge Survey

— = ARC SURVEY HYDROGRAPHIC SURVEY MARCH 15-29, 2022  
— = ARC SURVEY HYDROGRAPHIC SURVEY JUNE 23-JULY 6, 2020

MLW = MEAN LOW WATER  
STA. = STATION



— = TEMPLATE AT -5' MLW (REVISED PER CLIENT)  
— = TEMPLATE AT -6' MLW (REVISED PER CLIENT)

| DATE | BY | REVISION |
|------|----|----------|
|      |    |          |
|      |    |          |
|      |    |          |
|      |    |          |

LB No. 6487  
Drawn By: D. Trubits  
Scale: see map  
Plot Date: 04/07/22  
File Name:  
Fld Bk / Pg:  
ARC Project No.:  
21-272  
SHEET: 16 OF: 18



# Baseline 7

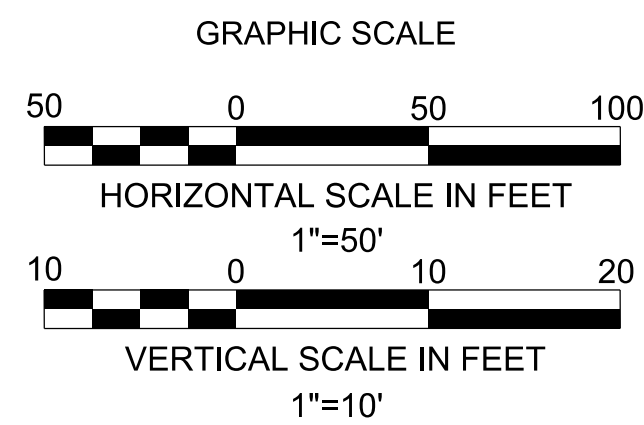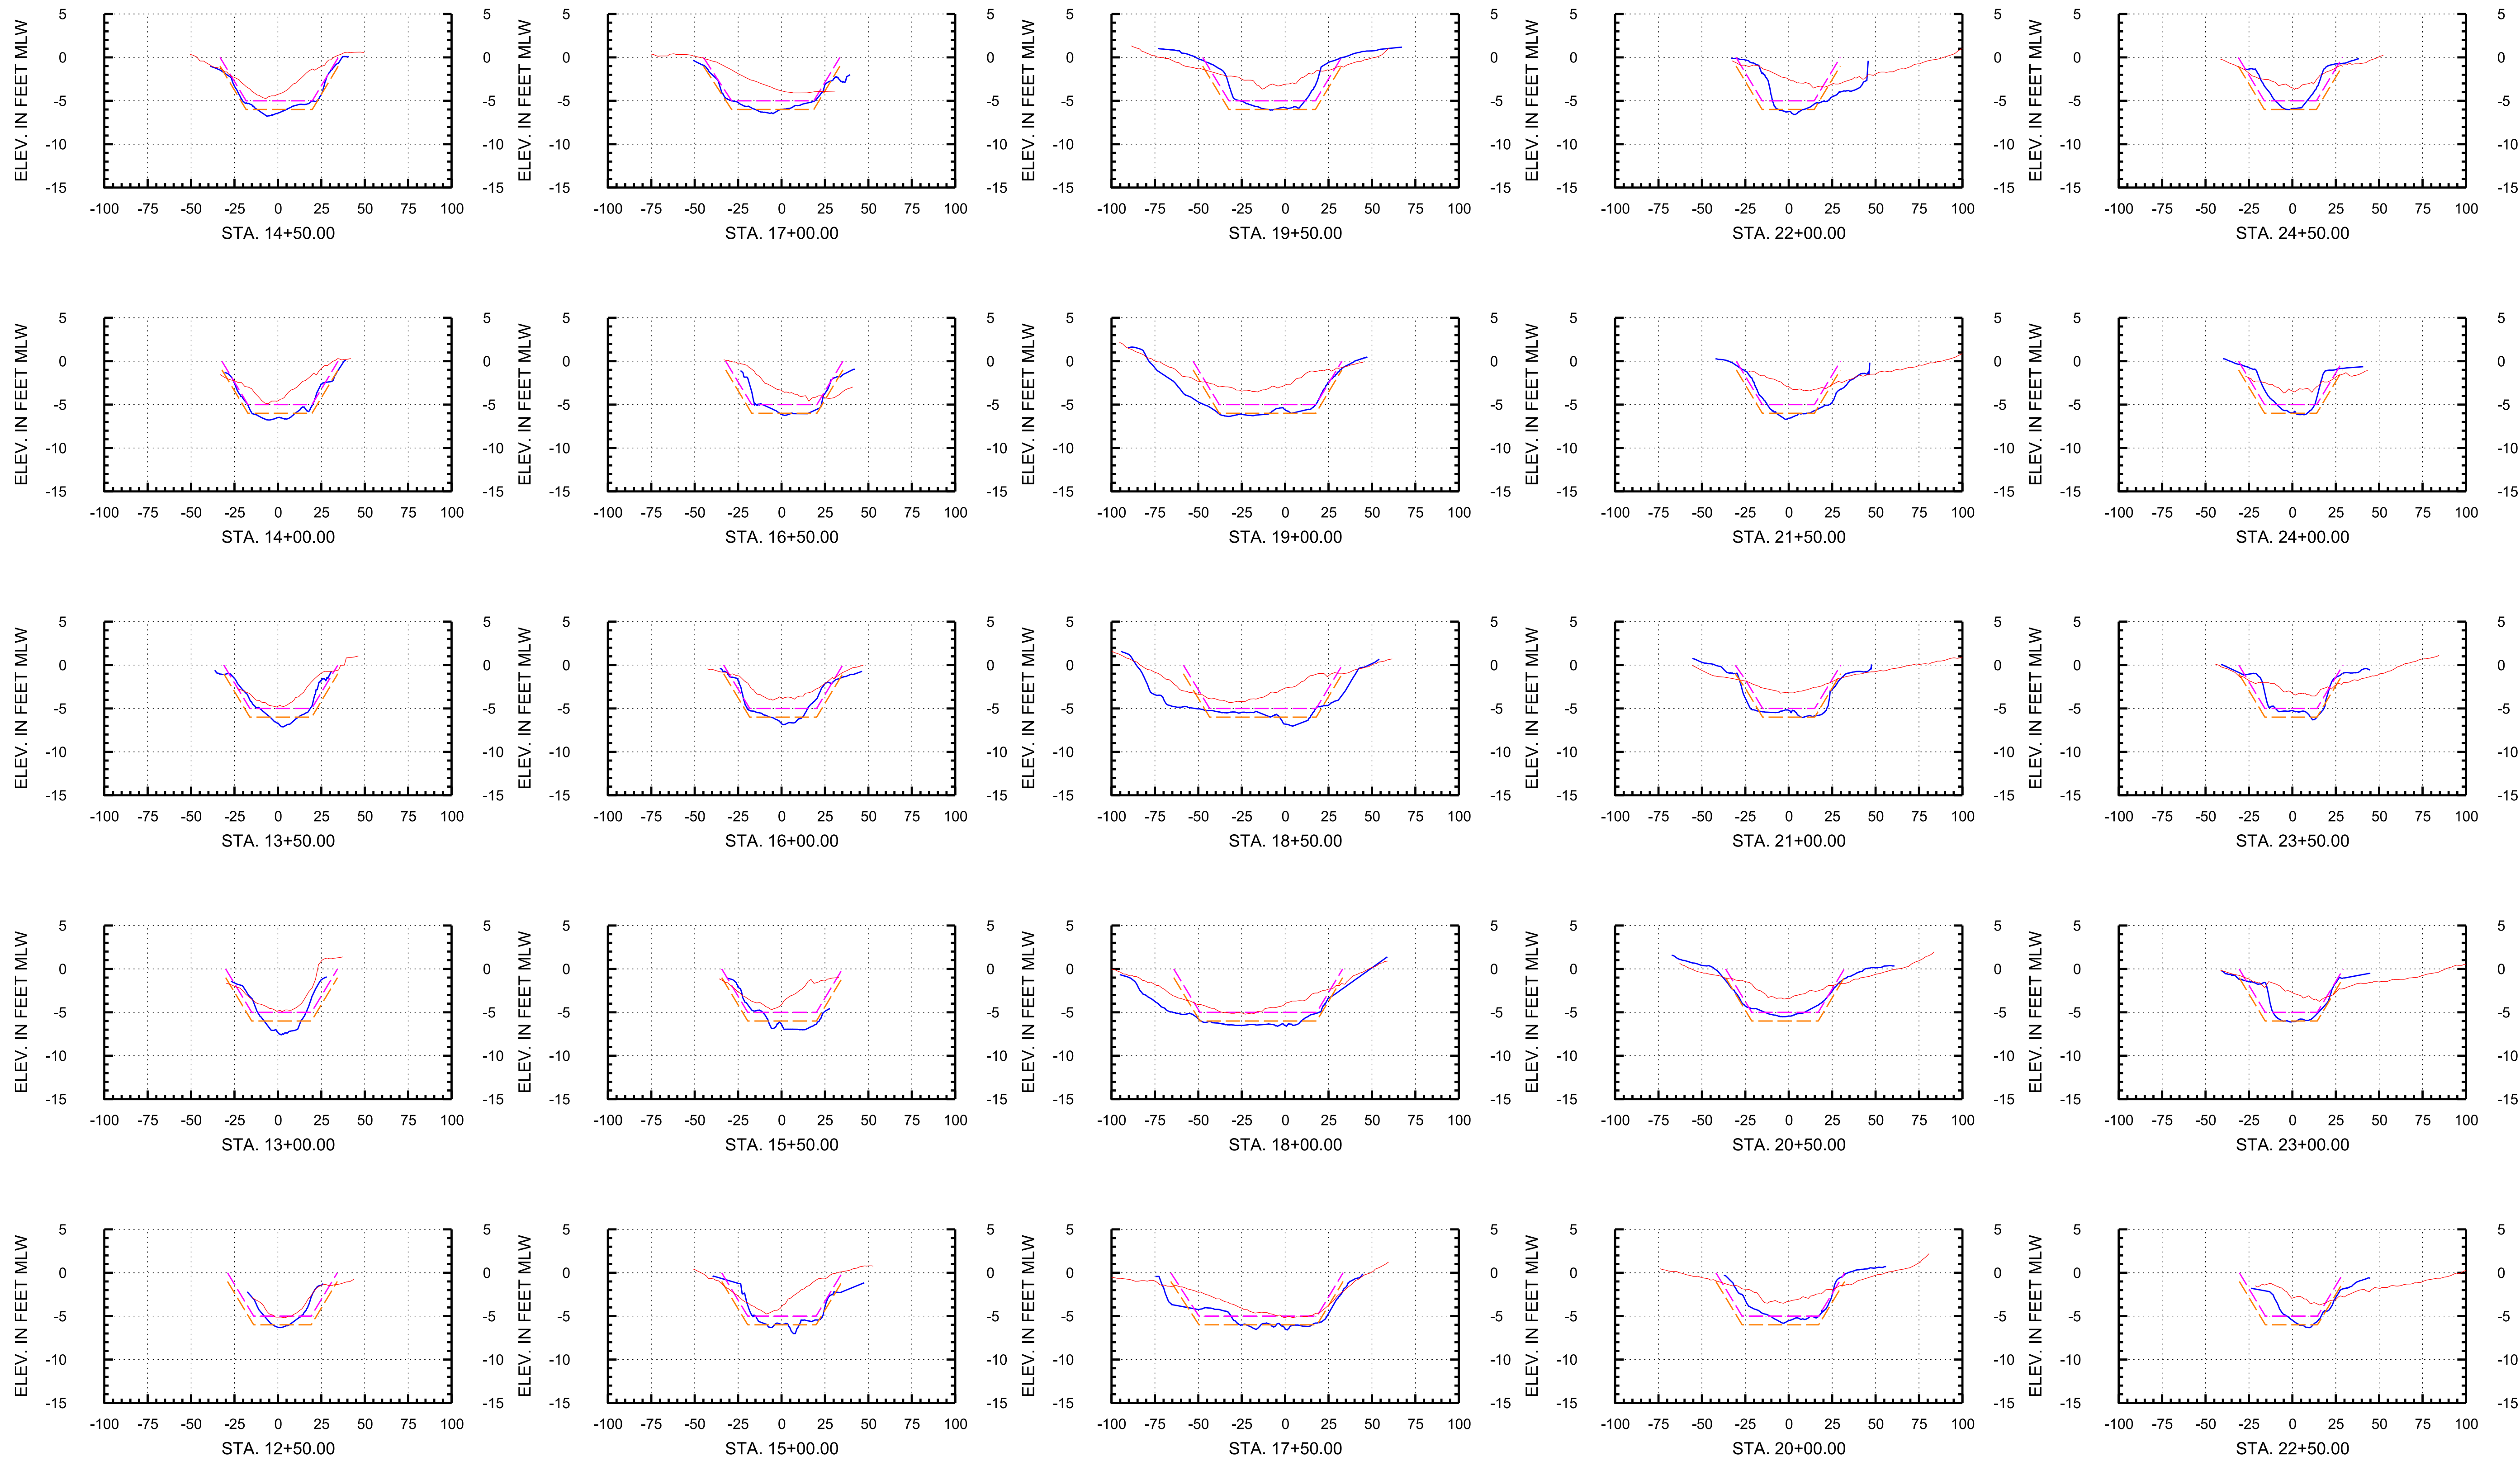

**Arc Surveying & Mapping, Inc.**  
Professional Hydrographers • Surveyors • Mappers  
5202 San Juan Avenue  
Jacksonville, Florida 32210  
904.384.8377

Prepared For:  
**Isle of Palms Special District**  
501 Riverside Avenue  
Jacksonville, FL 32202

Project Title:  
Isle of Palms North  
Hydrographic After-Dredge Survey

— = ARC SURVEY HYDROGRAPHIC SURVEY MARCH 15-29, 2022  
— = ARC SURVEY HYDROGRAPHIC SURVEY JUNE 23-JULY 6, 2020

MLW = MEAN LOW WATER  
STA. = STATION



— = TEMPLATE AT -5' MLW (REVISED PER CLIENT)  
— = TEMPLATE AT -6' MLW (REVISED PER CLIENT)

|      |    |          |
|------|----|----------|
|      |    |          |
|      |    |          |
|      |    |          |
|      |    |          |
| DATE | BY | REVISION |

LB No. 6487  
Drawn By: D. Trubits  
Scale: see map  
Plot Date: 04/07/22  
File Name:  
Fld Bk / Pg:  
ARC Project No.:  
21-272  
SHEET: 17 OF: 18



# Baseline 7

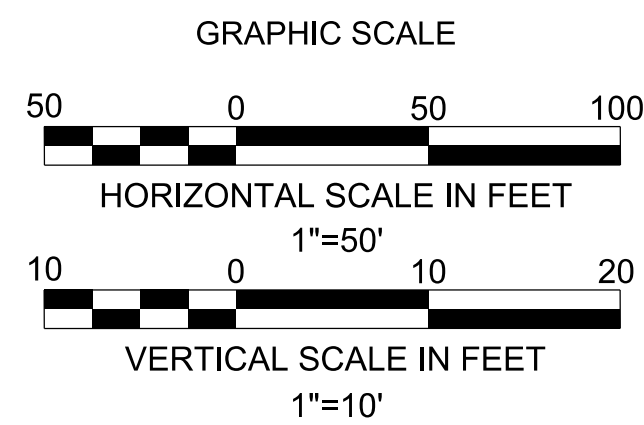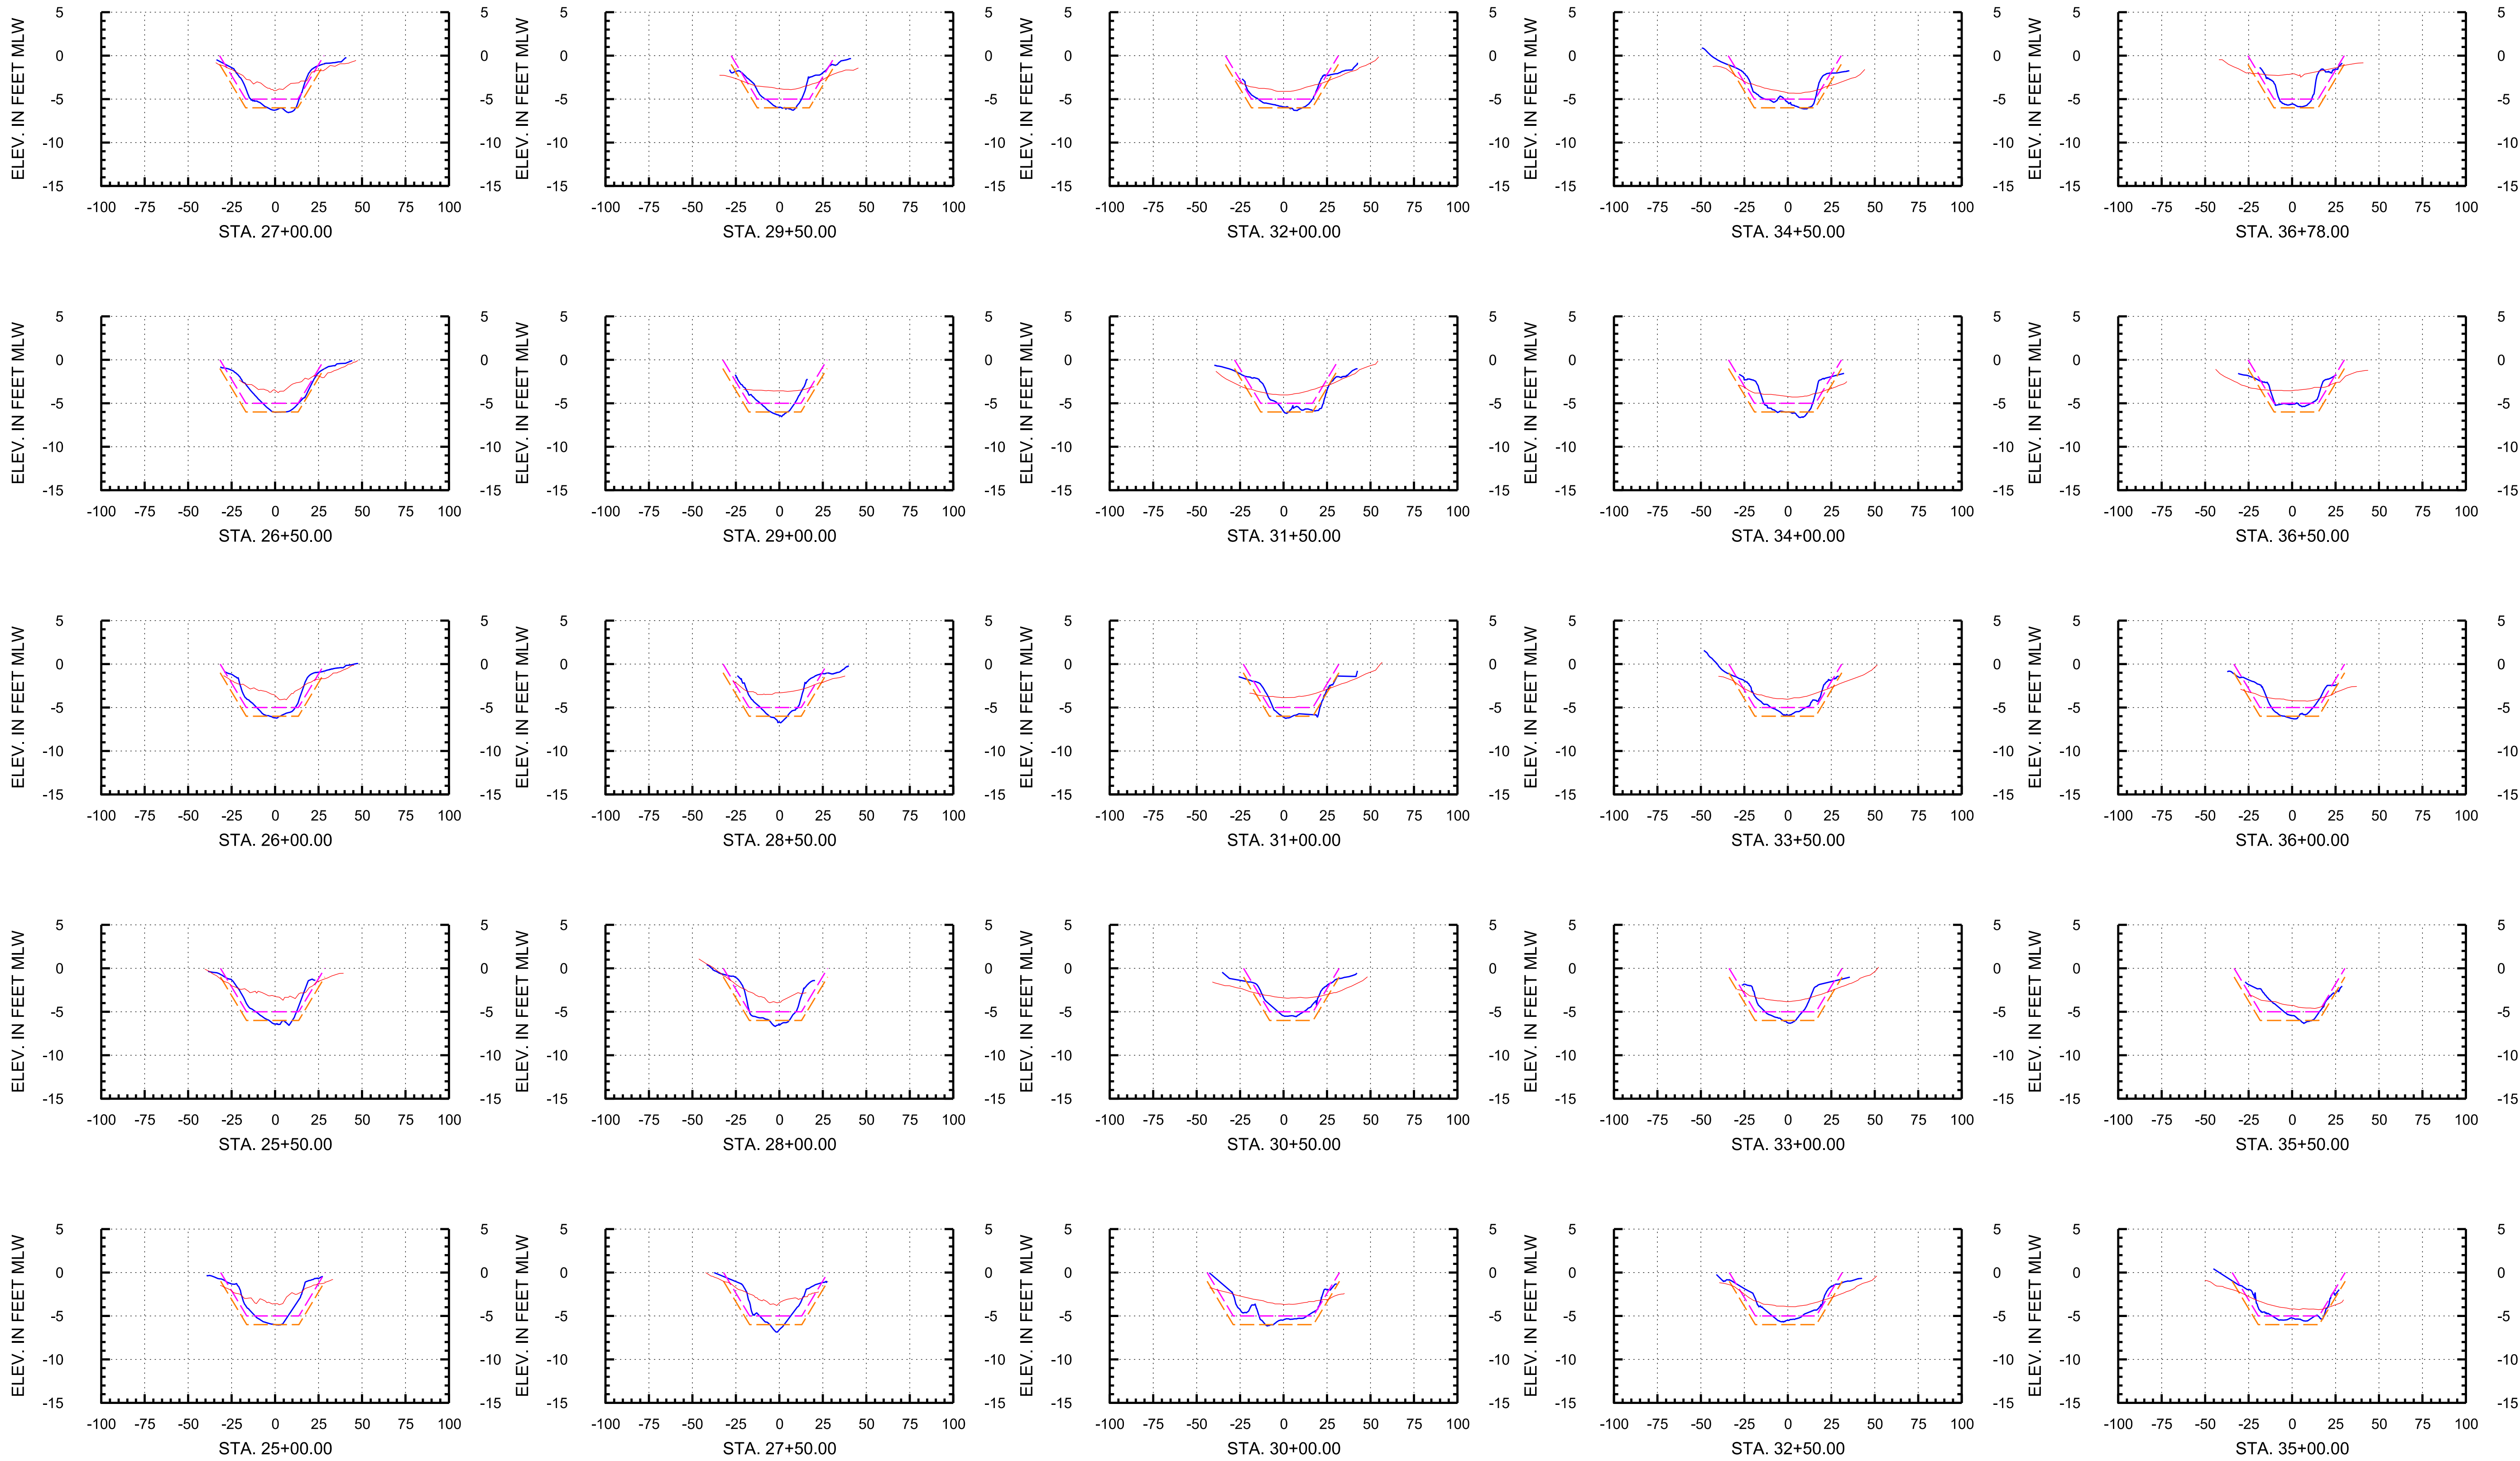

**Arc Surveying & Mapping, Inc.**  
Professional Hydrographers • Surveyors • Mappers  
5202 San Juan Avenue  
Jacksonville, Florida 32210  
904.384.8377

Prepared For:  
**Isle of Palms Special District**  
501 Riverside Avenue  
Jacksonville, FL 32202

Project Title:  
Isle of Palms North  
Hydrographic After-Dredge Survey

— = ARC SURVEY HYDROGRAPHIC SURVEY MARCH 15-29, 2022  
— = ARC SURVEY HYDROGRAPHIC SURVEY JUNE 23-JULY 6, 2020

MLW = MEAN LOW WATER  
STA. = STATION

— = TEMPLATE AT -5' MLW (REVISED PER CLIENT)  
— = TEMPLATE AT -6' MLW (REVISED PER CLIENT)

| DATE | BY | REVISION |
|------|----|----------|
|      |    |          |
|      |    |          |
|      |    |          |
|      |    |          |

LB No. 6487  
Drawn By: D. Trubits  
Scale: see map  
Plot Date: 04/07/22  
File Name:  
Fld Bk / Pg:  
ARC Project No.:  
21-272  
SHEET: 18 OF: 18